

STATEMENT OF FINANCIAL INTEREST

Case Number: **SUP-22975** APN: 138-02-712-011

Name of Property Owner: Temor Sadat

Name of Applicant: Nicole R. Kuter

Name of Representative: _____

To the best of your knowledge, does the Mayor or any member of the City Council or Planning Commission have any financial interest in this or any other property with the property owner, applicant, the property owner or applicant's general or limited partners, or an officer of their corporation or limited liability company?

 Yes X No

If yes, please indicate the member of the City Council or Planning Commission who is involved and list the name(s) of the person or persons with whom the City Official holds an interest. Also list the Assessor's Parcel Number if the property in which the interest is held is different from the case parcel.

City Official: _____

Partner(s): _____

APN: _____

Signature of Property Owner: *Temor Sadat*


Print Name: Temor Sadat

Subscribed and sworn before me


This 27th day of June, 2007

Catherine N. Peterson
Notary Public in and for said County and State



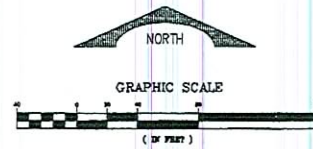


Northbrooke, A Business Park
4275-4335 No. Rancho Drive
Las Vegas, Nevada 89130

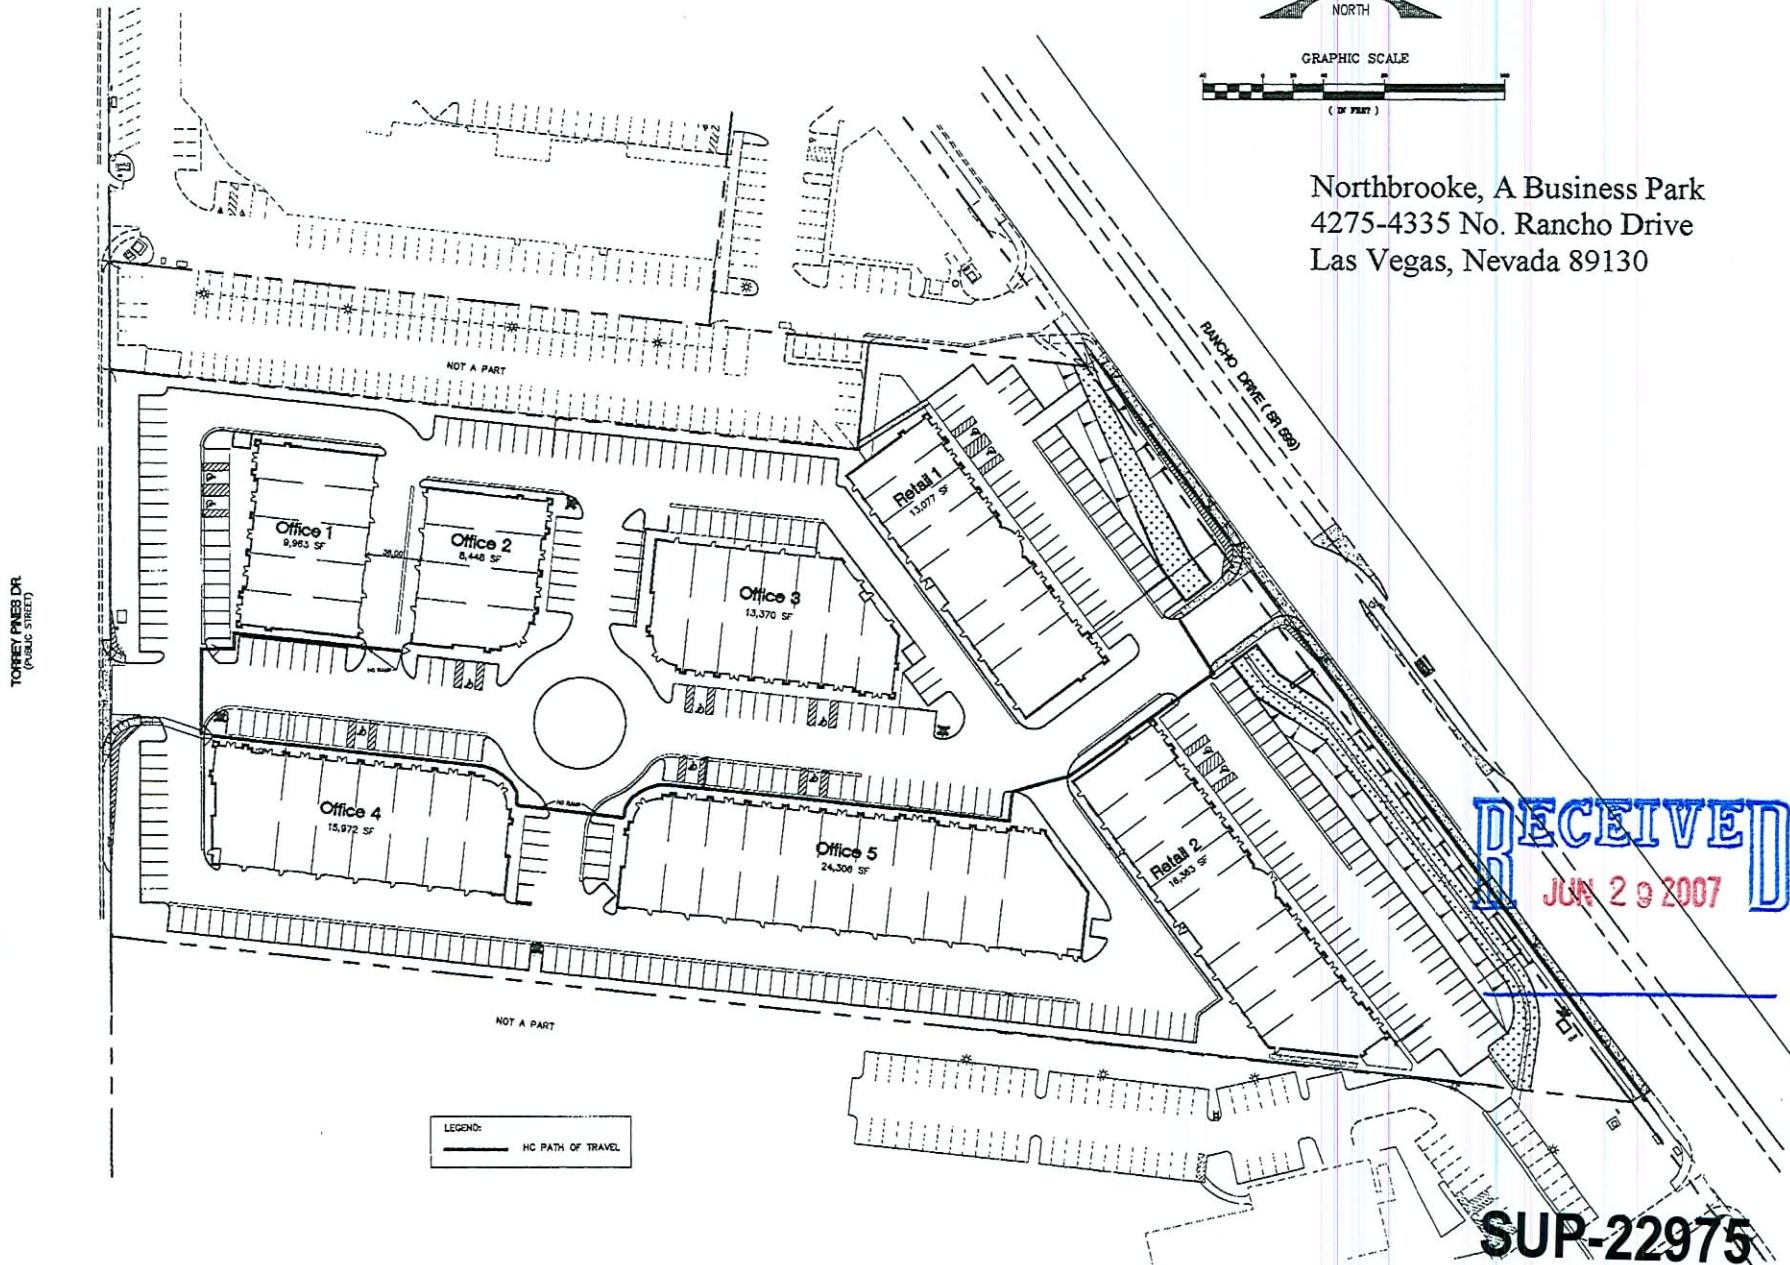

RECEIVED
JUN 29 2007

SUP-22975
08/23/07 PC

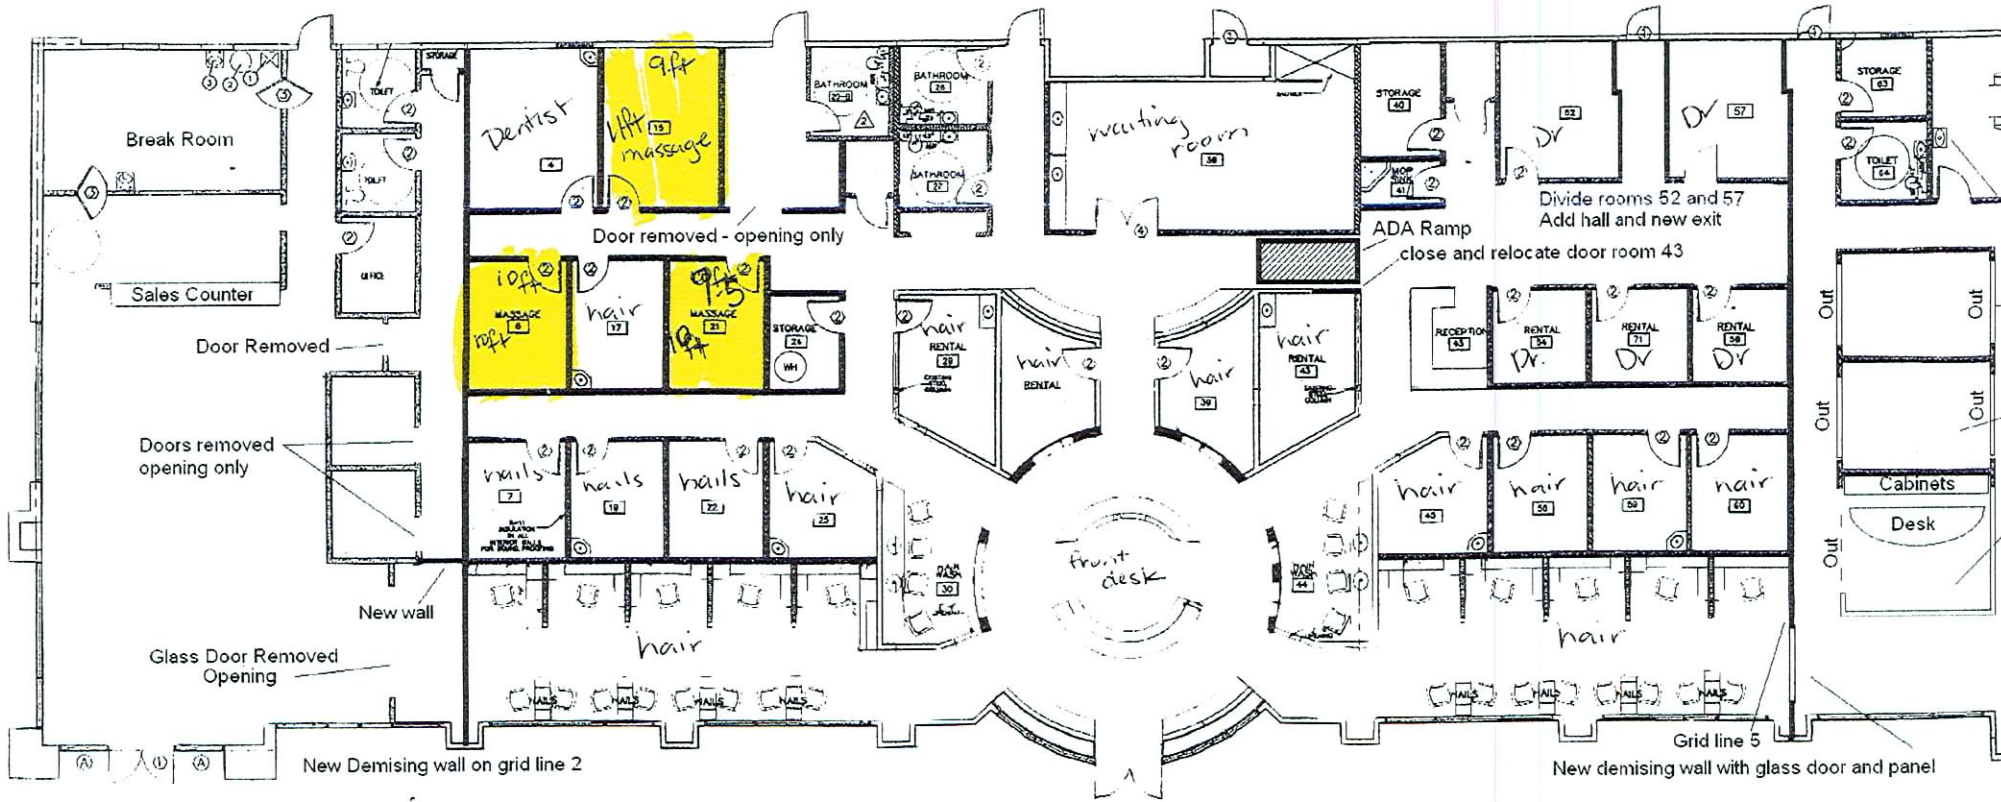

Whole building
13,084
Prive 7,938 sq ft

4335 No. Rancho Drive, Las Vegas, Nevada 89130

Suite 110 - Elegance Formal Wear
 Suite 150 - Privé Salon
 Suite 180 - B² Boutique

RECEIVED
 JUL 27 2007

SUP-22975
 REVISED
 08/23/07 PC