
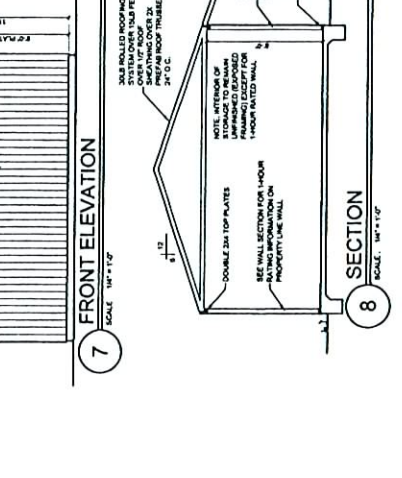



FIRE-RESISTANCE-UNITED CONSTRUCTION

MATERIAL	ITEM NUMBER	CONSTRUCTION	MINIMUM RATED FIRE-RESISTANCE PERIOD (HOURS)

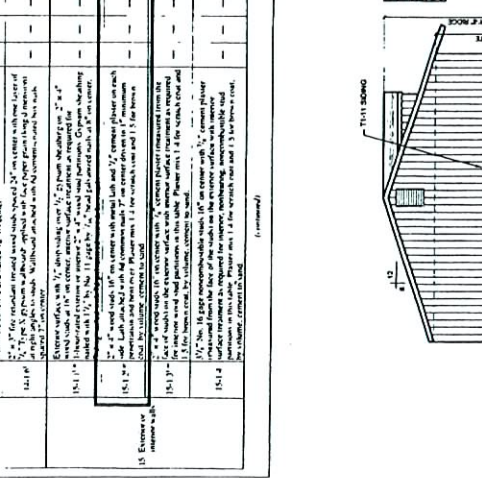

- PERMIT SET**
- GENERAL NOTES:
- ALL WORK MUST BE IN ACCORDANCE WITH THE CURRENT EDITION OF THE UNIFORM BUILDING CODE AS WELL AS APPLICABLE RULES AND REGULATIONS AS ADOPTED BY LOCAL GOVERNMENTAL AGENCIES
 - ALL WINDOW GLAZING TO BE PER IRC SECTION R602.4.10.2
 - ALL HABITABLE ROOMS SHALL HAVE MINIMUM CEILING HEIGHT OF NOT LESS THAN 7'4" PER IRC R602.1
 - PROVIDE WATER RESISTANT GYPSUM BOARD BEHIND ALL PLUMBING FIXTURES PER IRC D01
 - PROVIDE TREATED WOOD BATT AT ALL WOOD STUD WALLS IN CONTACT WITH CONCRETE OR MASONRY.
 - PROVIDE CONTINUOUS BIL SEAL AT ALL BATT Joints TO CONCRETE OR MASONRY SHALL SEALER BY CERTIFIED OR EQUAL
 - PROVIDE CURTAIN FLOORS AT EACH SIDE OF EACH WINDOW.
 - PROVIDE FIBER GLASS PER IRC R602.4
 - ALL DOOR HARDWARE TO COMPLY WITH IRC R310.1.4.4
 - ALL WINDOWS WITHIN 24" OF DOOR SWINGS SHALL BE TEMPERED
 - ALL FIXTURES & FINISHES TO BE SELECTED BY OWNER.
 - INSTALL ALL EXTERIOR WALLS WITH BATT INSULATION
 - ALL ROOF & FLOOR SPACES, AS WELL AS BATT INSULATION
 - ALL CORROSION RESISTANT WEAP SCREENS SHALL BE PROVIDED AT OR BELOW THE FOUNDATION PLATE LINE AND SHALL BE A MINIMUM 1/2" THICK GALVANNEED STEEL AND SHALL BE A TYPE THAT WILL ALLOW TRAPPED WATER TO DRAIN TO THE EXTERIOR OF THE BUILDING PER IRC D01.2
 - MINIMUM BARRIERS PER IRC R310.1.2

RECEIVED
 APR 27 2007
 VAR-21621
 06/14/07 PC

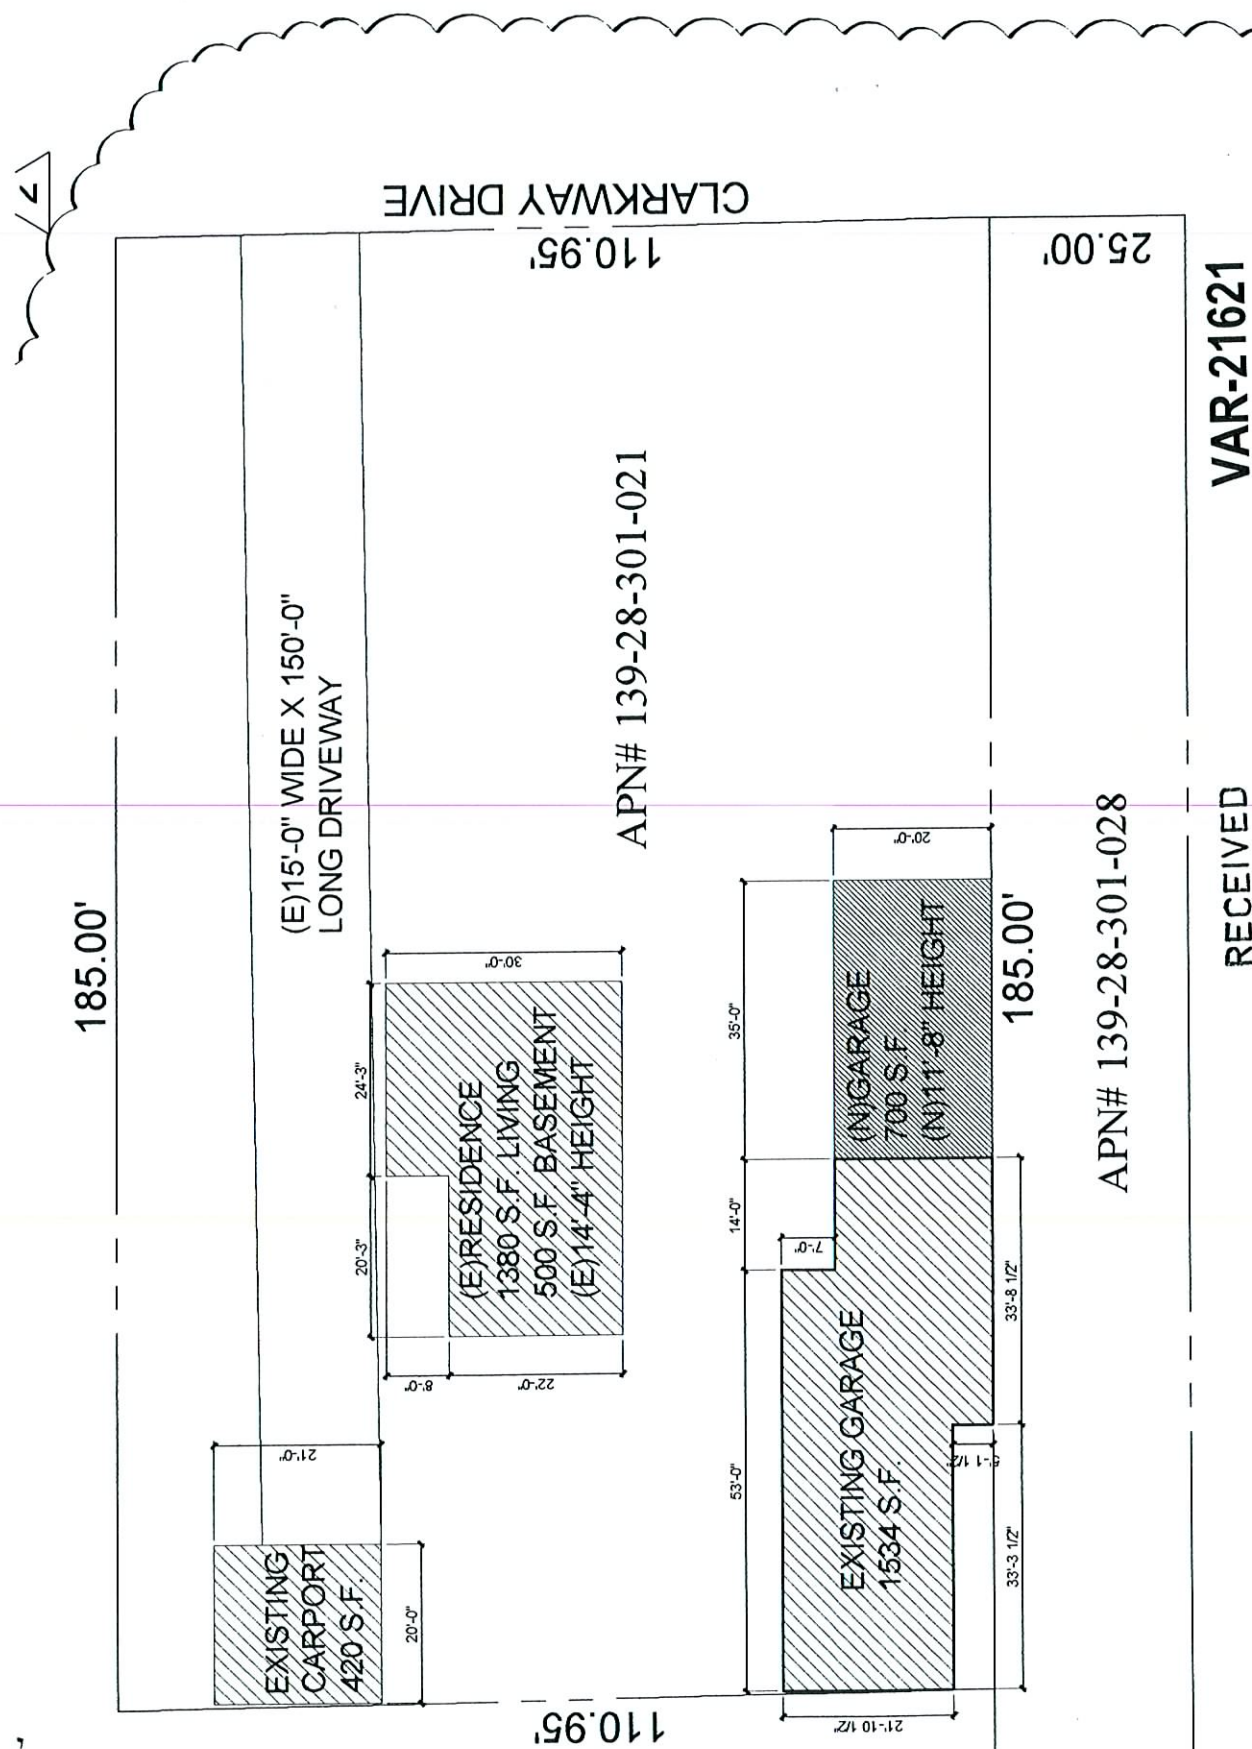

CLARKWAY DRIVE

110.95'

25.00'

APN# 139-28-301-021

APN# 139-28-301-028

VAR-21621
REVISED
06/14/07 PC

RECEIVED
MAY 25 2007



VAR-21621 - APPLICANT/OWNER: LARRY BUCHANAN
715 CLARK WAY DRIVE
JUNE 14, 2007 PLANNING COMMISSION

05/25/07



VAR-21621 - APPLICANT/OWNER: LARRY BUCHANAN
715 CLARK WAY DRIVE
JUNE 14, 2007 PLANNING COMMISSION

05/25/07