



**PLANNING & DEVELOPMENT DEPARTMENT**

**STATEMENT OF FINANCIAL INTEREST**

Case Number: **RQR-23916** APN: 1162-06-211-001

Name of Property Owner: Ernest Becker III MEB Family Trust

Name of Applicant: Lamar Outdoor Advertising

To the best of your knowledge, does the Mayor or any member of the City Council or Planning Commission have any financial interest in this or any other property with the property owner, applicant, the property owner or applicant's general or limited partners, or an officer of their corporation or limited liability company?

~~Yes~~

No

If yes, please indicate the member of the City Council or Planning Commission who is involved and list the name(s) of the person or persons with whom the City Official holds an interest. Also list the Assessor's Parcel Number if the property in which the interest is held is different from the case parcel.

City Official: \_\_\_\_\_

Partner(s): \_\_\_\_\_

APN \_\_\_\_\_

Signature of Property Owner: [Signature]

Print Name: Scott Nafziger


on behalf of owner

Subscribed and sworn before me

This 14 day of August, 2007

[Signature]  
Notary Public in and for said County and State

RECEIVED  
AUG 14 2007

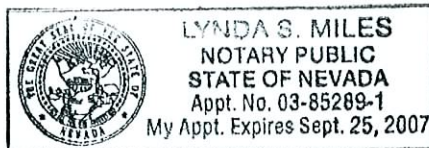

PELICAN COVE APARTMENTS

WESTLAND MALL SHOPPING CENTER


OLIVE GARDEN RESTAURANT

DECATUR BOULEVARD

APPROVED

*Off premise sign rebuild*

By: *Les Comeau 8/29/07*  
COMMUNITY PLANNING & DEVELOPMENT  
City of Las Vegas

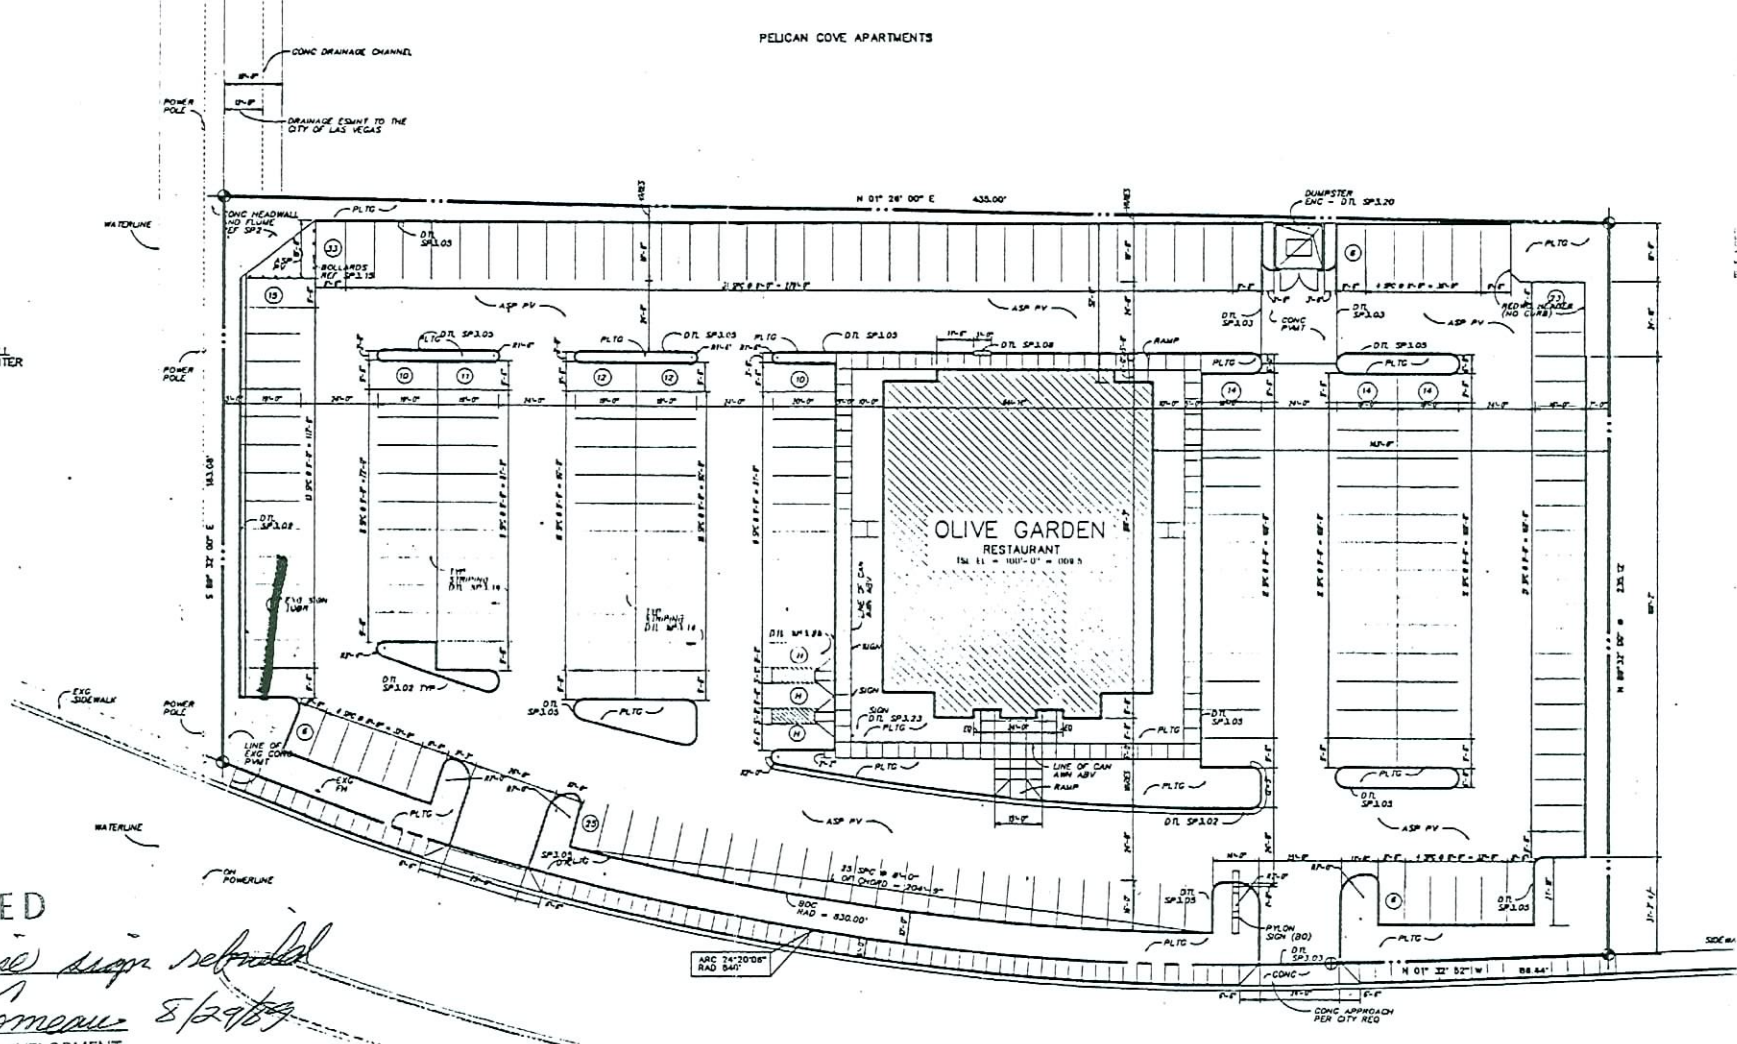

RECEIVED

AUG 14 2007

RQR-23916

09/27/07 PC