



PLANNING & DEVELOPMENT DEPARTMENT

STATEMENT OF FINANCIAL INTEREST

Case Number: **SUP-23922** APN: 162-06-402-001

Name of Property Owner: PK II Sahara Pavilion North LLC

Name of Applicant: Regina Edwards

Name of Representative: _____

To the best of your knowledge, does the Mayor or any member of the City Council or Planning Commission have any financial interest in this or any other property with the property owner, applicant, the property owner or applicant's general or limited partners, or an officer of their corporation or limited liability company?

Yes No

If yes, please indicate the member of the City Council or Planning Commission who is involved and list the name(s) of the person or persons with whom the City Official holds an interest. Also list the Assessor's Parcel Number if the property in which the interest is held is different from the case parcel.

City Official: _____

Partner(s): _____

APN: _____

Signature of Property Owner: PLEASE SEE ATTACHED.


Print Name: _____

Subscribed and sworn before me

This _____ day of _____, 20_____

Notary Public in and for said County and State

Caylix Supper Club

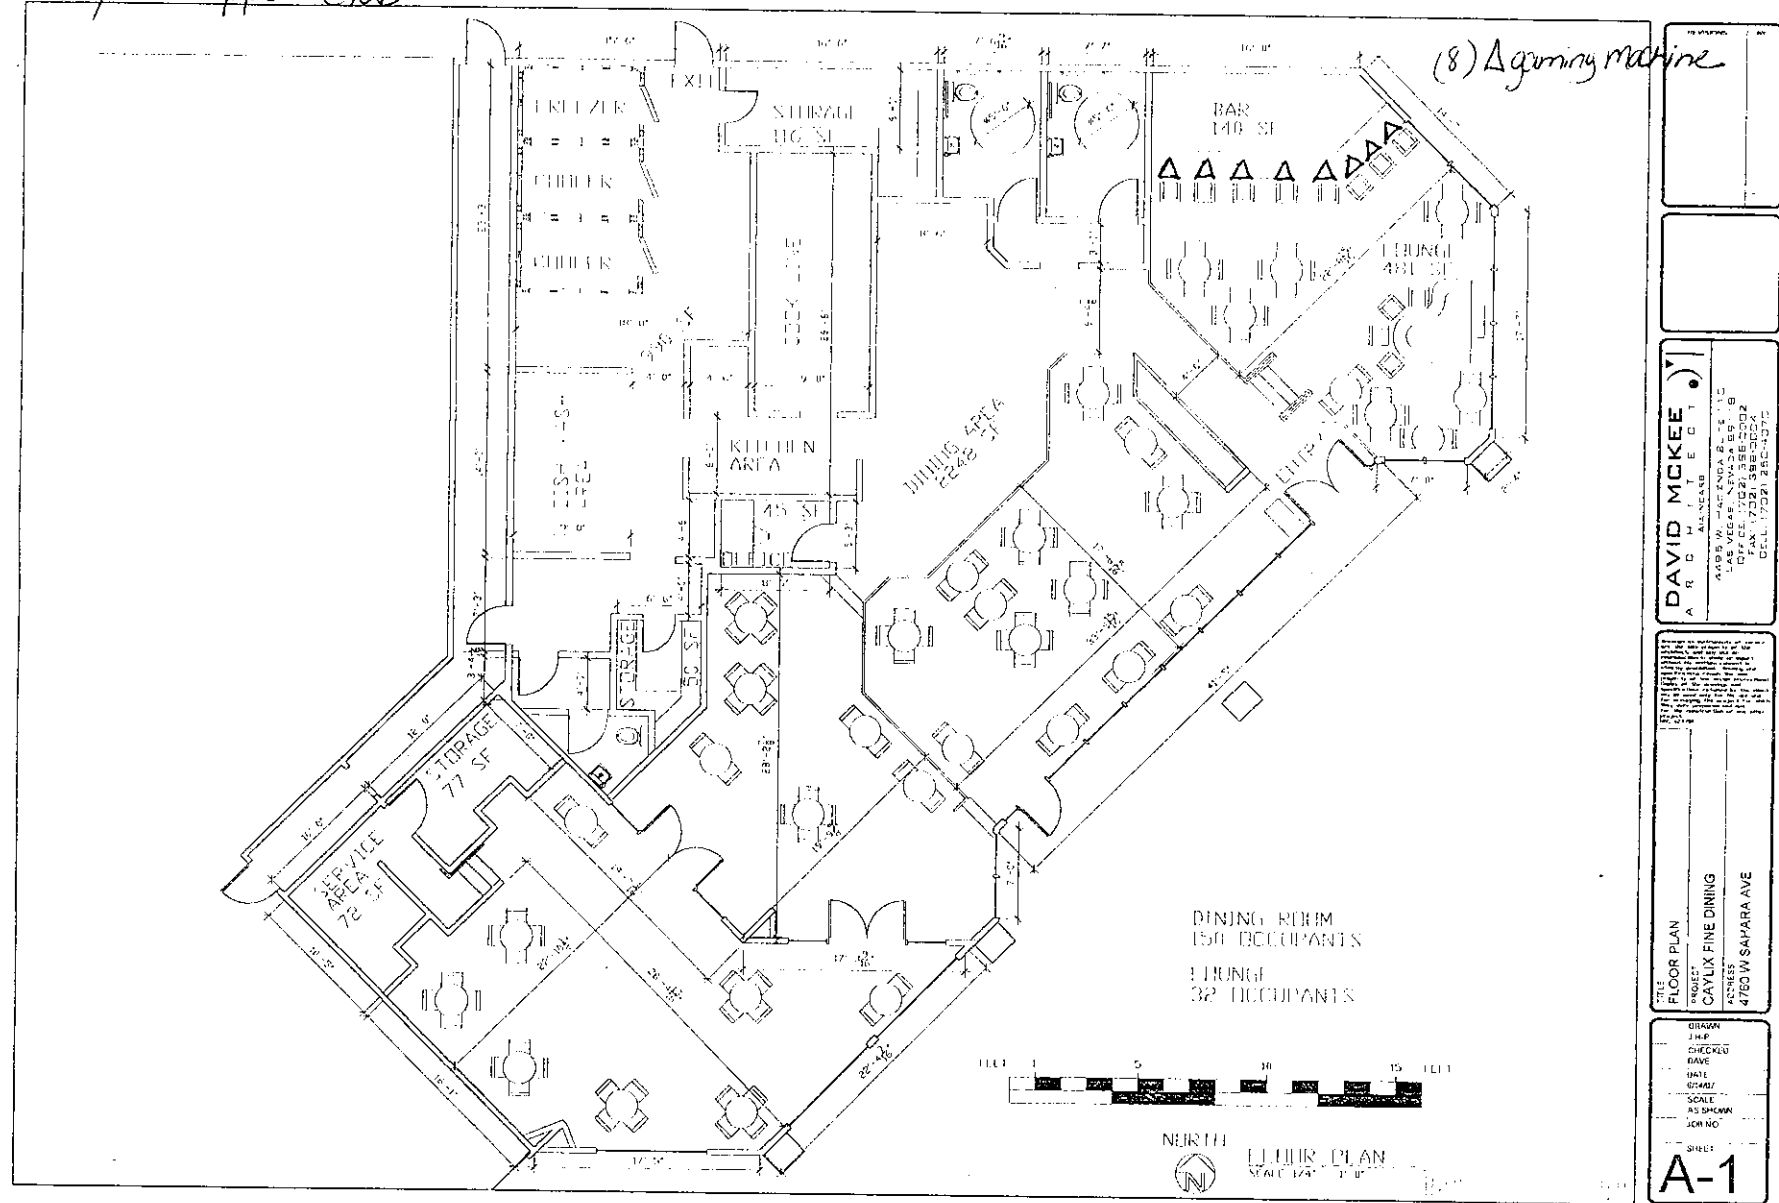

<p>(8) Gaming machine</p>	
<p>TITLE: FLOOR PLAN PROJECT: CAYLIX FINE DINING ADDRESS: 4760 W SAGARA AVE</p>	
<p>DESIGNER: [] CHECKED: [] DATE: [] SCALE: AS SHOWN SHEET NO: []</p>	
<p>A-1</p>	

AUG 20 2007

SUP-23922
09/27/07 PC