



PLANNING & DEVELOPMENT DEPARTMENT

STATEMENT OF FINANCIAL INTEREST

Case Number: **SUP-23924** APN: 162-06-402-001

Name of Property Owner: PK II Sahara Pavilion North LLC

Name of Applicant: Regina Edwards

Name of Representative: _____

To the best of your knowledge, does the Mayor or any member of the City Council or Planning Commission have any financial interest in this or any other property with the property owner, applicant, the property owner or applicant's general or limited partners, or an officer of their corporation or limited liability company?

Yes

No

If yes, please indicate the member of the City Council or Planning Commission who is involved and list the name(s) of the person or persons with whom the City Official holds an interest. Also list the Assessor's Parcel Number if the property in which the interest is held is different from the case parcel.

City Official: _____

Partner(s): _____

APN: _____

Signature of Property Owner: PLEASE SEE ATTACHED.

Print Name: _____

Subscribed and sworn before me


This _____ day of _____, 20____

Notary Public in and for said County and State

SAHARA PAVILION NORTH

LAS VEGAS, NV 1510


PD: 41307

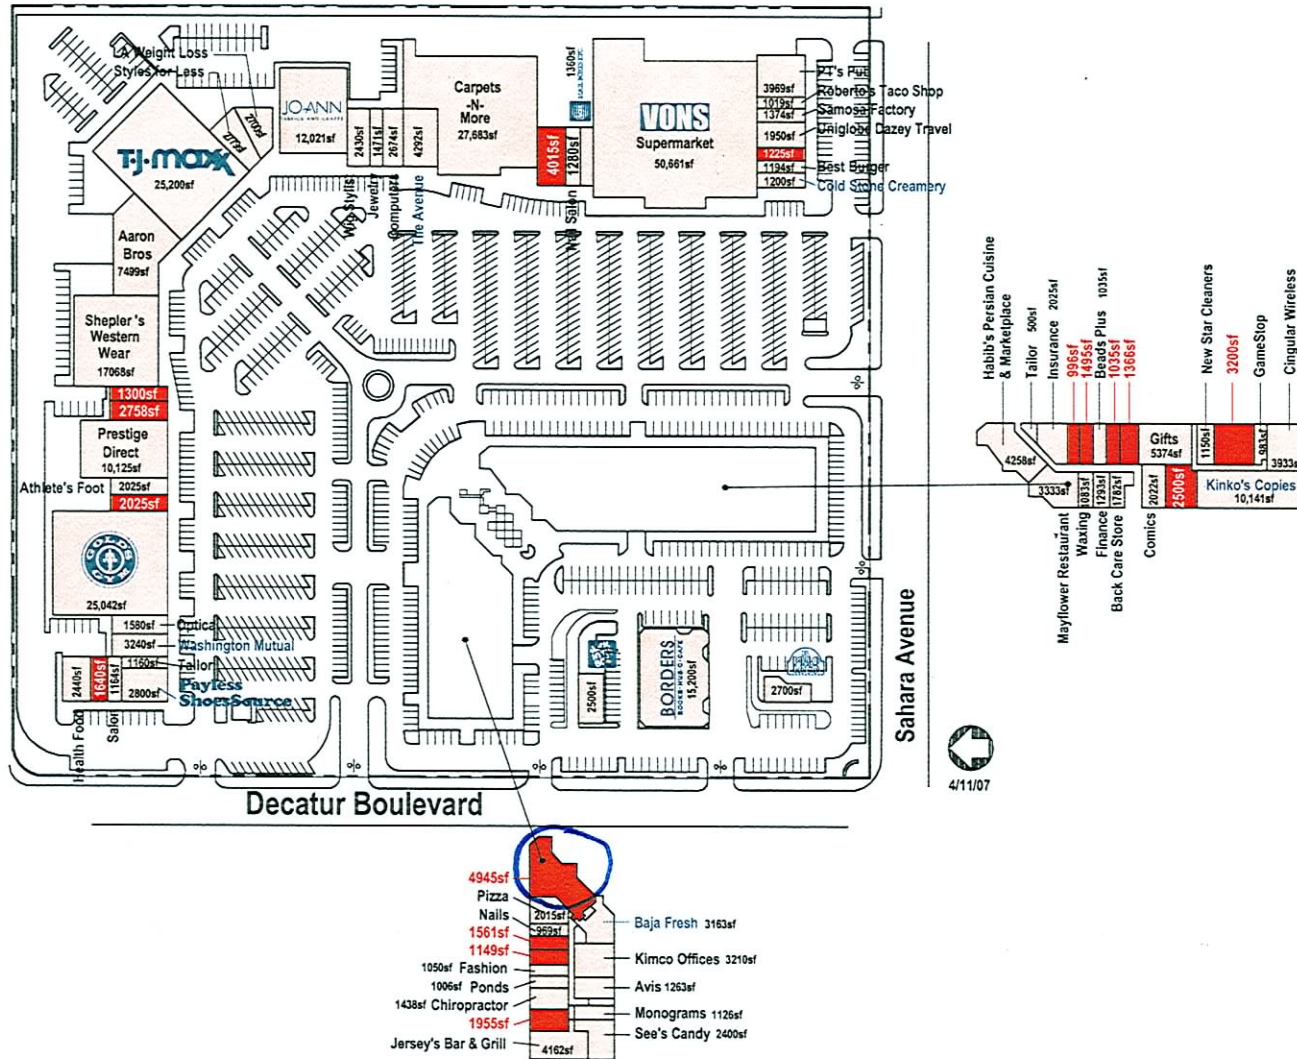

RECEIVED

AUG 14 2007

Caylix Supper Club

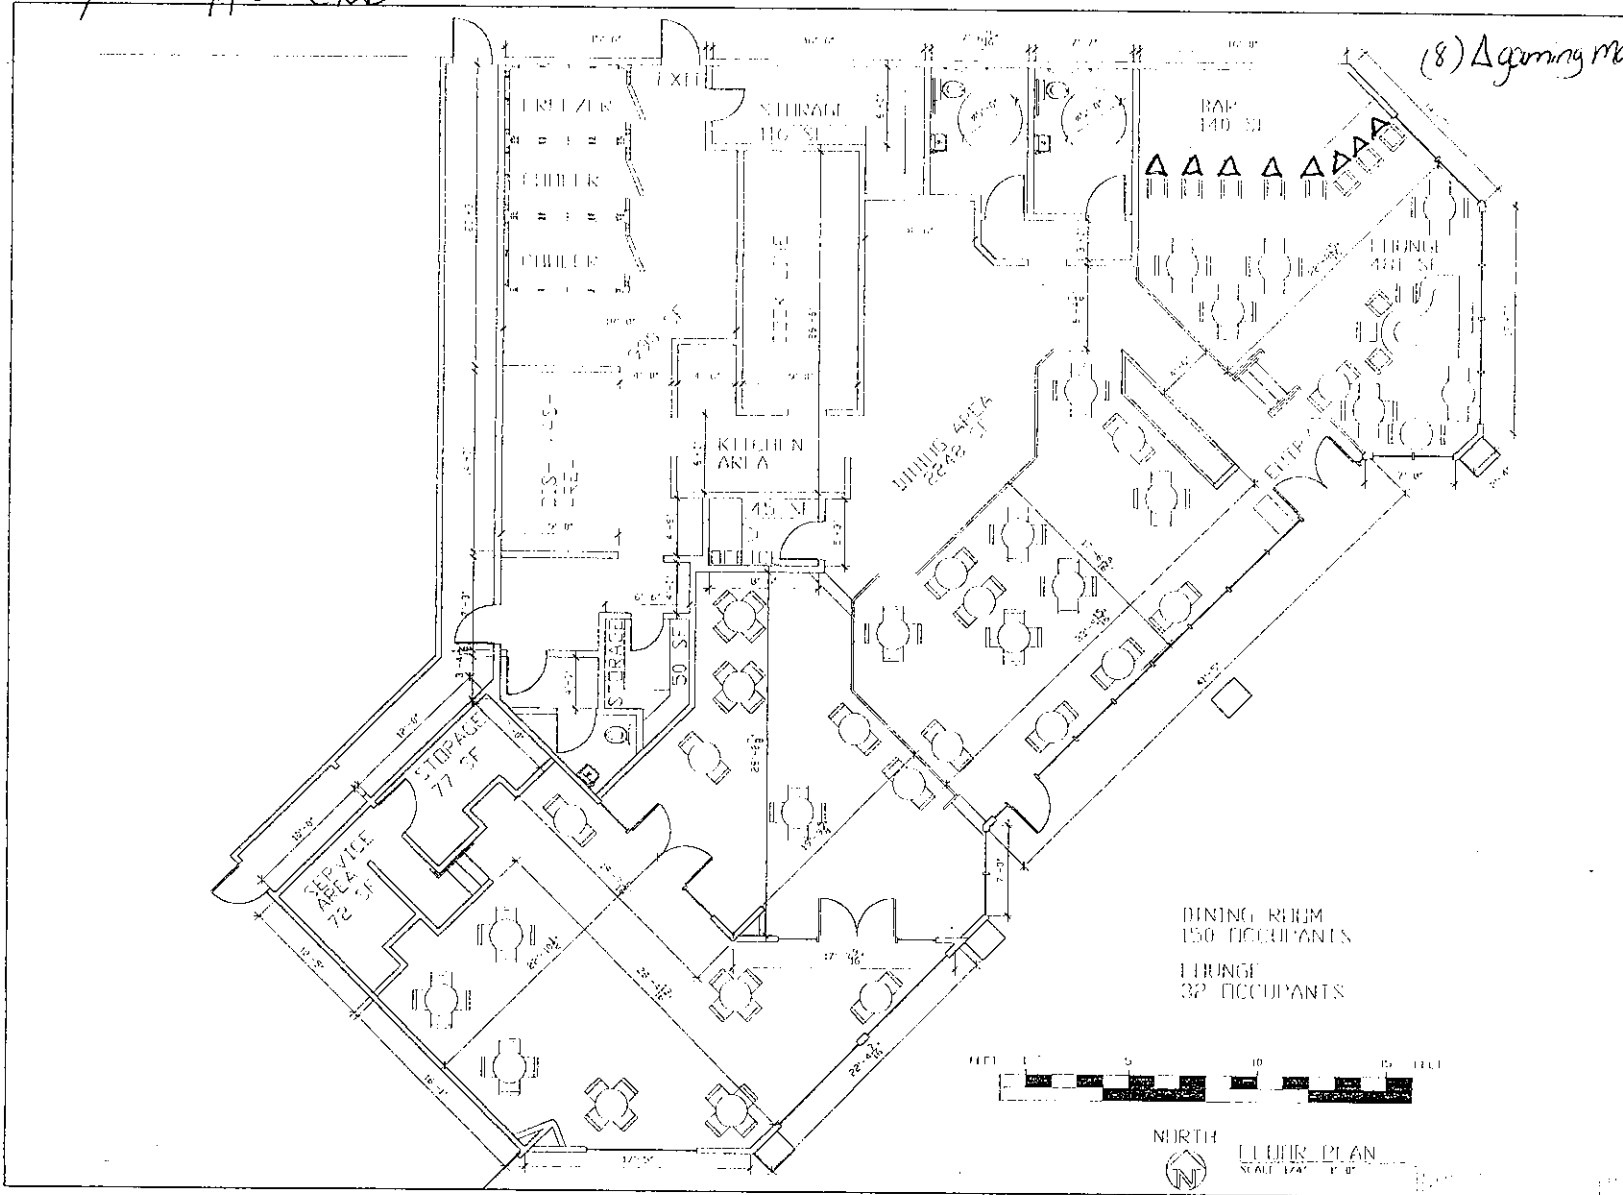

(8) Gaming machine

--

--

DAVID MCKEE
 ARCHITECT
 4405 W. LAS VEGAS BLVD. SUITE 100
 LAS VEGAS, NEVADA 89118
 OFFICE: (702) 388-0002
 HOME: (702) 388-9076
 FAX: (702) 388-9076

TITLE FLOOR PLAN
PROJECT CAYLIX FINE DINING
ADDRESS 4760 W. SAHARA AVE

SCALE 1/4" = 1'-0"

DRAWN: JHP
 CHECKED: DAV
 DATE: RHM/07
 SCALE: AS SHOWN
 JOB NO: SHEET: **A-1**

DINING ROOM
150 OCCUPANTS

LUNGE
32 OCCUPANTS



NORTH

 SCALE 1/4" = 1'-0"

AUG 20 2007

SUP-23924
09/27/07 PC