

TO WHOM IT MAY CONCERN

THE PURPOSE OF THIS REQUEST
IS TO ASK FOR A VARIANCE FOR
A DETACHED GARAGE THAT HAS ALREADY
BEEN CONSTRUCTED ON MY PROPERTY.
I TAKE FULL RESPONSIBILITY FOR
HAVING CONSTRUCTED THIS GARAGE
WITHOUT THE PROPER PERMITS


Respectfully

Dean L Smith

RECEIVED
MAY 23 2007

VAR-22167
07/12/07 PC

JUSTIFICATION LETTER HEIGHT OF EXISTING RESIDENCE

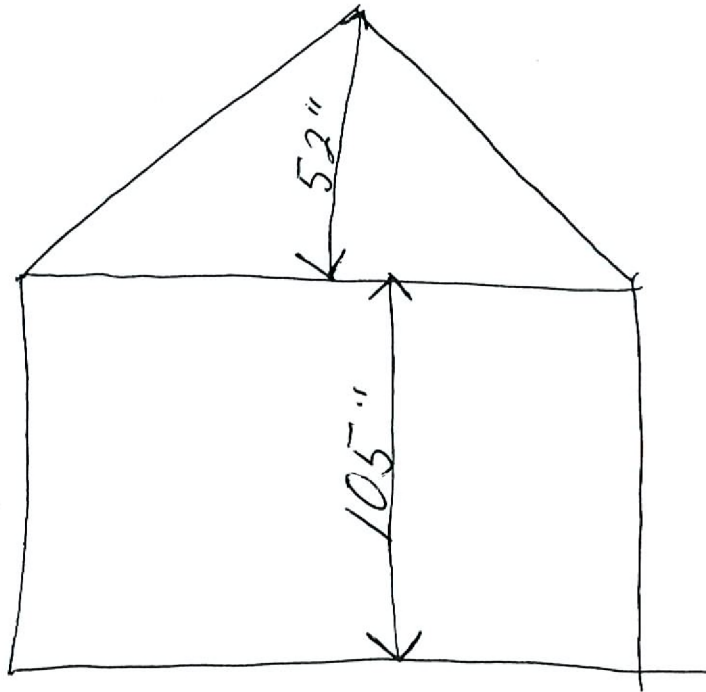

RECEIVED
MAY 23 2007

RECEIVED

VAR-22167
07/12/07 PC