



**PLANNING & DEVELOPMENT DEPARTMENT**

**STATEMENT OF FINANCIAL INTEREST**

Case Number: **SUP-23586** APN: 139-34-210-003

Name of Property Owner: GBSS Properties, LLC.

Name of Applicant: New Genesis

Name of Representative: Kelly Charles

To the best of your knowledge, does the Mayor or any member of the City Council or Planning Commission have any financial interest in this or any other property with the property owner, applicant, the property owner or applicant's general or limited partners, or an officer of their corporation or limited liability company?

Yes

No

If yes, please indicate the member of the City Council or Planning Commission who is involved and list the name(s) of the person or persons with whom the City Official holds an interest. Also list the Assessor's Parcel Number if the property in which the interest is held is different from the case parcel.

City Official: \_\_\_\_\_


Partner(s): \_\_\_\_\_

APN: \_\_\_\_\_


Signature of Property Owner: *Glenda Shaw*  
Print Name: Glenda Shaw GBSS PROPERTIES, LLC

Subscribed and sworn before me

This 30 day of July, 20 07  
*Garnette Y. Klukoske*  
Notary Public in and for said County and State

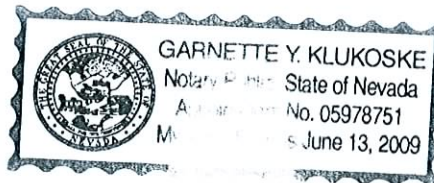

BRIDGER AVE.

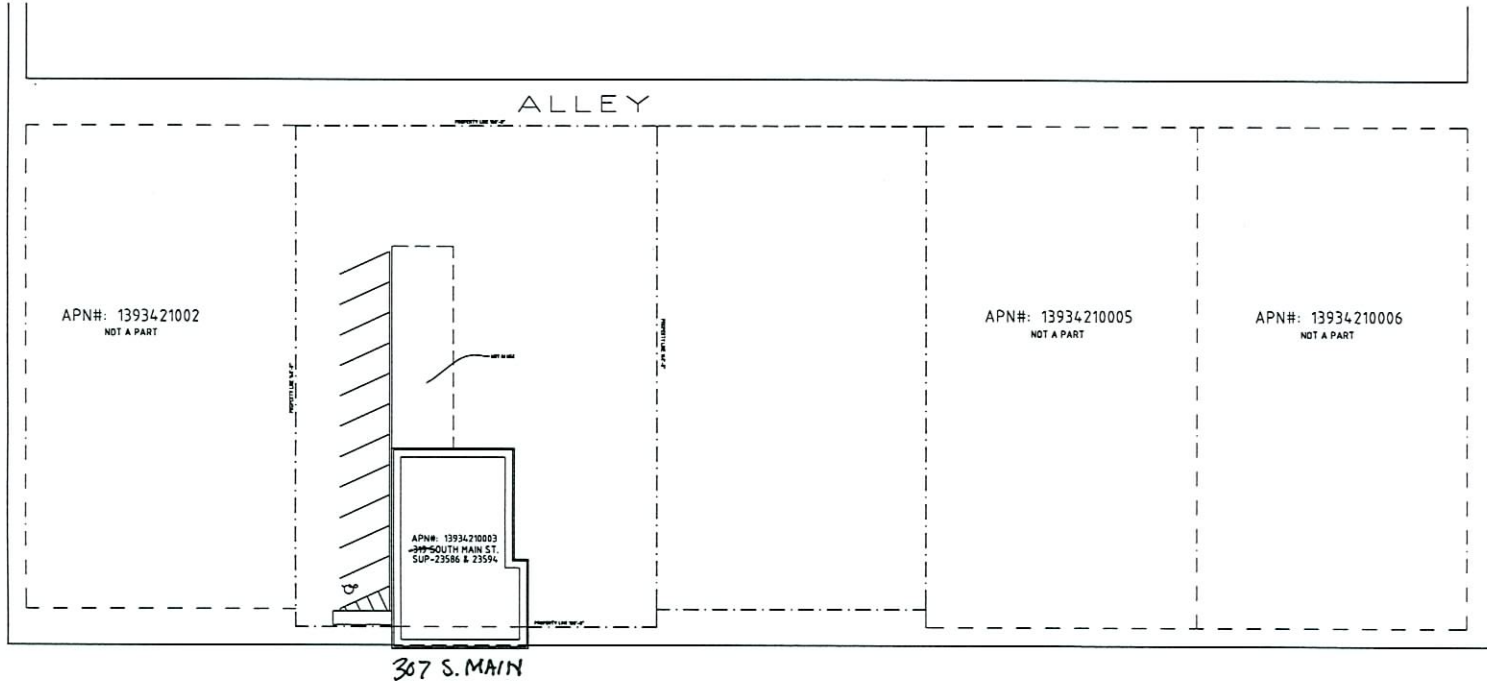

307 S. MAIN

S. MAIN ST.

PARKING ANALYSIS	
TOTAL BEDS =	12
PARKING SPACES REQUIRED =	3
PARKING SPACES SUPPLIED =	10

RECEIVED  
OCT 17 2007

AA SITE PLAN  
1/16"



VICINITY MAP  
1/8"



SUP-23586  
11/29/07 PC

DRAWN BY : DESIGNED BY : CHECKED BY : DATE : JOB No : SCALE :	ALM   2.30.07 1/8" = 1'-0"	SITE PLAN SHEET SPECIAL USE PERMIT #'s 23586 & 23594 307 S. MAIN ST. LAS VEGAS, NEVADA	NO. DATE: _____ PR. SUPERVISOR: _____
--	--	---	--



