

**SITE DATA**


ADJACENT'S PARCEL NUMBER	188-16410-017
SITE AREA	333,333 SF (7.64 ACRES)
BUILD A	6,000 SF
BUILD B	4,000 SF
BUILD C	4,000 SF
BUILD D	4,000 SF
BUILD E	4,000 SF
BUILD F	4,000 SF
BUILD G	4,000 SF
BUILD H (2 STORY)	16,000 SF
BUILD I (2 STORY)	16,000 SF
BUILD J	4,000 SF
BUILD K	4,000 SF
<b>TOTAL BUILDING AREA</b>	<b>78,000 SF</b>
<b>BUILDING COVERAGE</b>	<b>23.4%</b>
PARKING REQUIRED	3,31000
PARKING PROVIDED	4,71000
	265
	381

NOTE:  
 ALL BUILDING AREA, LAND COVERAGE AND PARKING TABULATIONS ARE PRELIMINARY AND SUBJECT TO CHANGE.  
 ANY PROPOSED DEVELOPMENT IS SUBJECT TO REVIEW AND APPROVAL OF GOVERNMENTAL AGENCIES.

RECEIVED  
 OCT 03 2007

SMOKE RANCH ROAD

SUP-24985  
 REVISED  
 11/29/07 PC

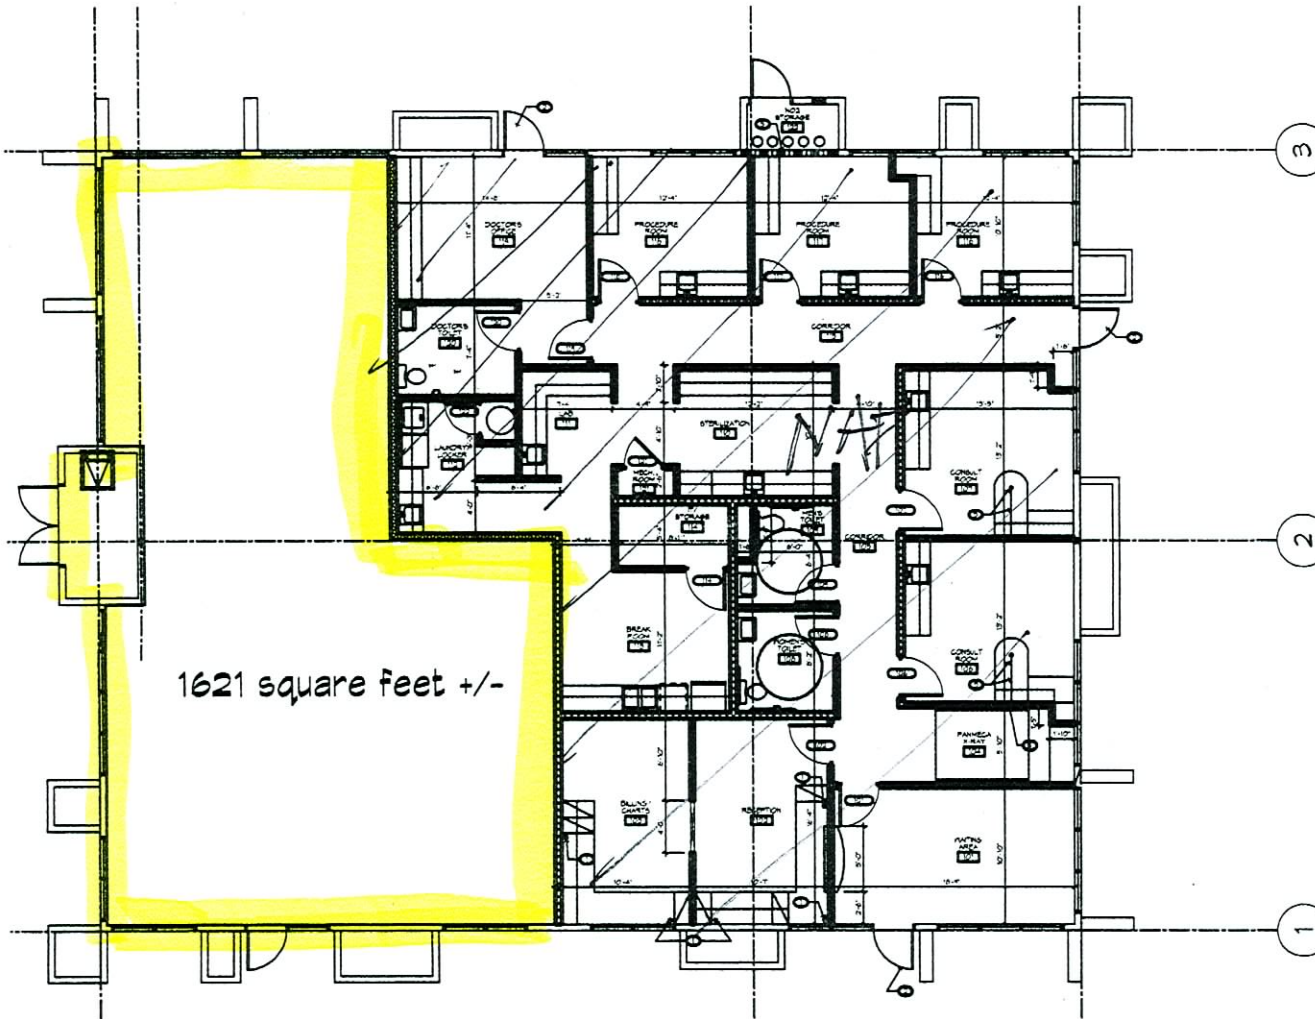

1621 square feet +/-

6970 SMOKE BANCH RD

STE #110

RECEIVED  
OCT 04 2007

RECEIVED  
OCT 4 2007

SUP-24985  
11/29/07 PC