



PLANNING & DEVELOPMENT DEPARTMENT

STATEMENT OF FINANCIAL INTEREST

Case Number: SUP-24192 APN: 162-04-410-001

Name of Property Owner: The Garret Group, LLC

Name of Applicant: Dual Alliance, LLC dba Rider's

Name of Representative: _____

To the best of your knowledge, does the Mayor or any member of the City Council or Planning Commission have any financial interest in this or any other property with the property owner, applicant, the property owner or applicant's general or limited partners, or an officer of their corporation or limited liability company?

_____ Yes No

If yes, please indicate the member of the City Council or Planning Commission who is involved and list the name(s) of the person or persons with whom the City Official holds an interest. Also list the Assessor's Parcel Number if the property in which the interest is held is different from the case parcel.

City Official: _____

Partner(s): _____


APN: _____

Signature of Property Owner: *[Handwritten Signature]*

Print Name: TOM JONES

Subscribed and sworn before me

This 24 day of AUGUST, 2007
[Handwritten Signature]
Notary Public in and for said County and State

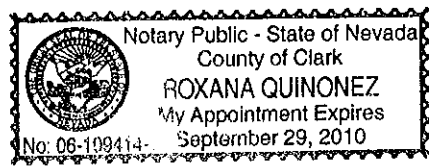



PLANNING & DEVELOPMENT DEPARTMENT

STATEMENT OF FINANCIAL INTEREST

Case Number: SUP-24192 APN: 162-04-410-001

Name of Property Owner: The Garret Group, LLC

Name of Applicant: Dual Alliance, LLC dba Rider's

Name of Representative: _____

To the best of your knowledge, does the Mayor or any member of the City Council or Planning Commission have any financial interest in this or any other property with the property owner, applicant, the property owner or applicant's general or limited partners, or an officer of their corporation or limited liability company?

_____ Yes No

If yes, please indicate the member of the City Council or Planning Commission who is involved and list the name(s) of the person or persons with whom the City Official holds an interest. Also list the Assessor's Parcel Number if the property in which the interest is held is different from the case parcel.

City Official: _____

Partner(s): _____

APN: _____


Signature of Property Owner: *Dalton L. Conners*


Print Name: DALTON L. CONNERS

Subscribed and sworn before me

This 24 day of AUGUST, 2007

Roxana Quinonez
Notary Public in and for said County and State

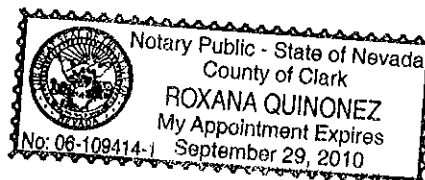

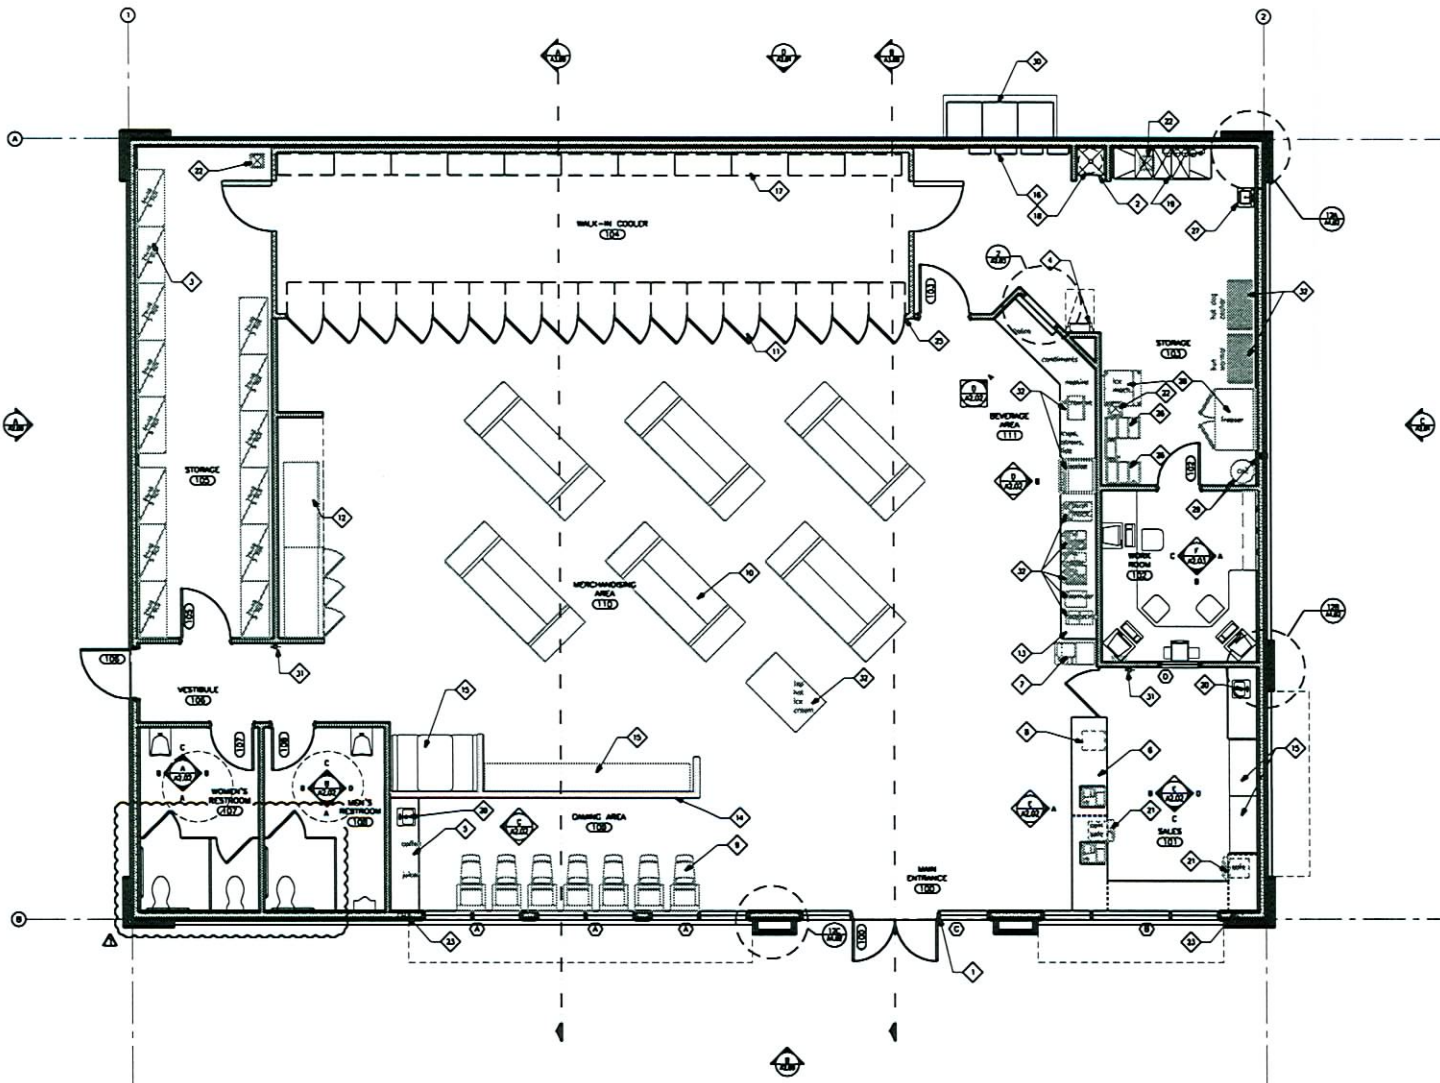

MAIN FLOOR PLAN
SCALE: 1/4" = 1'-0"

SUP-24192
10/11/07 PC

PLAN GENERAL NOTES

- CONTRACTOR SHALL COORDINATE THIS SHEET WITH ALL OTHER SHEETS ISSUED BY ARCHITECT AND ENGINEER AND MAKE ANY MODIFICATIONS TO THE ARCHITECT'S APPROVAL.
- ALL WORK AREAS SHALL BE KEPT IN A CLEAN AND SAFE CONDITION AT ALL TIMES.
- ALL WORK AREAS SHALL BE PROTECTED FOR THE LIFE OF THE PROJECT AND ALL MODIFICATIONS, REVISIONS AND CORRECTIONS SHALL BE NOTICED BY OWNER.
- SEE ALL OTHER FLOOR PLAN DRAWINGS AND WALL PANELS. REFER TO SHEET A1.00 FOR FINISH SCHEDULE.

KEYNOTES

- ALUMINUM STRUCTURE DESIGN FOR ALUMINUM FINISH.
- WALL PANEL BY SHAW & BUCKNER BRANCO 6-24143, SEE "T" SHEETS FOR MORE INFO.
- STORAGE RACK (24" x 48"), BRASS FINISHES.
- FRAMES WITH 100% ACCESS LAMINATE AND 3/4" X 3/4" GRID FINISH BY JACOBS (24" x 48") OR EQUAL, SEE "L" SHEETS.
- P-LAM CONSTRUCTION AT 3/4" (90% ACCESSIBLE).
- OWNER CONSTRUCTION & BIDDING CONTRACT AT 3/4" AFF. SEE MECHANICAL DRAWINGS ON ALUMINUM.
- 100% ACCESSIBLE (SEE "T" SHEETS FOR MORE INFO) AND 3/4" X 3/4" GRID FINISH BY JACOBS (24" x 48") OR EQUAL, SEE "L" SHEETS.
- STAIR RAMPING BY OWNER, SEE "T" SHEETS FOR MORE INFO. PROVIDE COMMUNICATIONS CORDS BETWEEN STAIRS AND PLACES. COORDINATE WITH "T" SHEETS.
- MERCHANDISING COUNTERS BY OWNER, FIN. OF S.
- FINISHES BY OWNER.
- ELECTRICAL PANELS AND PANEL FRAMES AT THIS AREA, SEE "T" SHEETS.
- OWNER STORAGE RACK (24" x 48"), BRASS FINISHES.
- ELECTRIC WIRE HANGER BRACK, SEE "T" SHEETS.
- J CONSTRUCTION SEE "T" SHEETS.
- SHOP-IN SHOP SEE "T" SHEETS.
- SAFE FINISHES BY OWNER.
- FLOOR SEE "T" SHEETS.
- WALL PANELS AND BRASS FINISH FOR "T" SHEETS.
- FACE CONSTRUCTION, VERIFY LOCATIONS AND QUANTITIES WITH THE ARCHITECT AND OWNER, CHECK.
- EQUIPMENT BY OWNER.

RECEIVED
AUG 24 2007

REVISIONS

Mark	Date	Description
A	10-26-07	OWNER COMMENTS

CONTRACTOR
 NAME: **BRESLIN BUILDERS**
 ADDRESS: 5625 POLARIS AVENUE, SUITE B, LAS VEGAS, NEVADA 89118
 PHONE: (702) 786-3077
 FAX: (702) 786-3005
 WWW: www.breslinbuilders.com

BRESLIN BUILDERS
 DESIGN & CONSTRUCTION
 LICENSED GENERAL CONTRACTOR
 LICENSE #001136
 5625 POLARIS AVENUE, SUITE B
 LAS VEGAS, NEVADA 89118
 (702) 786-3077
 FAX (702) 786-3005
 www.breslinbuilders.com

Project Owner:
Chevron Convenience Store
 2237 W. Charleston Blvd.
 Las Vegas, Nevada 89102
 APN: 162-04-101-001

Sheet Title:
Main Level Floor Plan

Date	Designed By
Nov. 27, 2006	Scott Redinger

Project No.	Drawn By
2006-148	ISA/JCA

Annotation	Checked By
Las Vegas	ISA/JCB

A1.00