



Northbrooke, A Business Park  
4275-4335 No. Rancho Drive  
Las Vegas, Nevada 89130

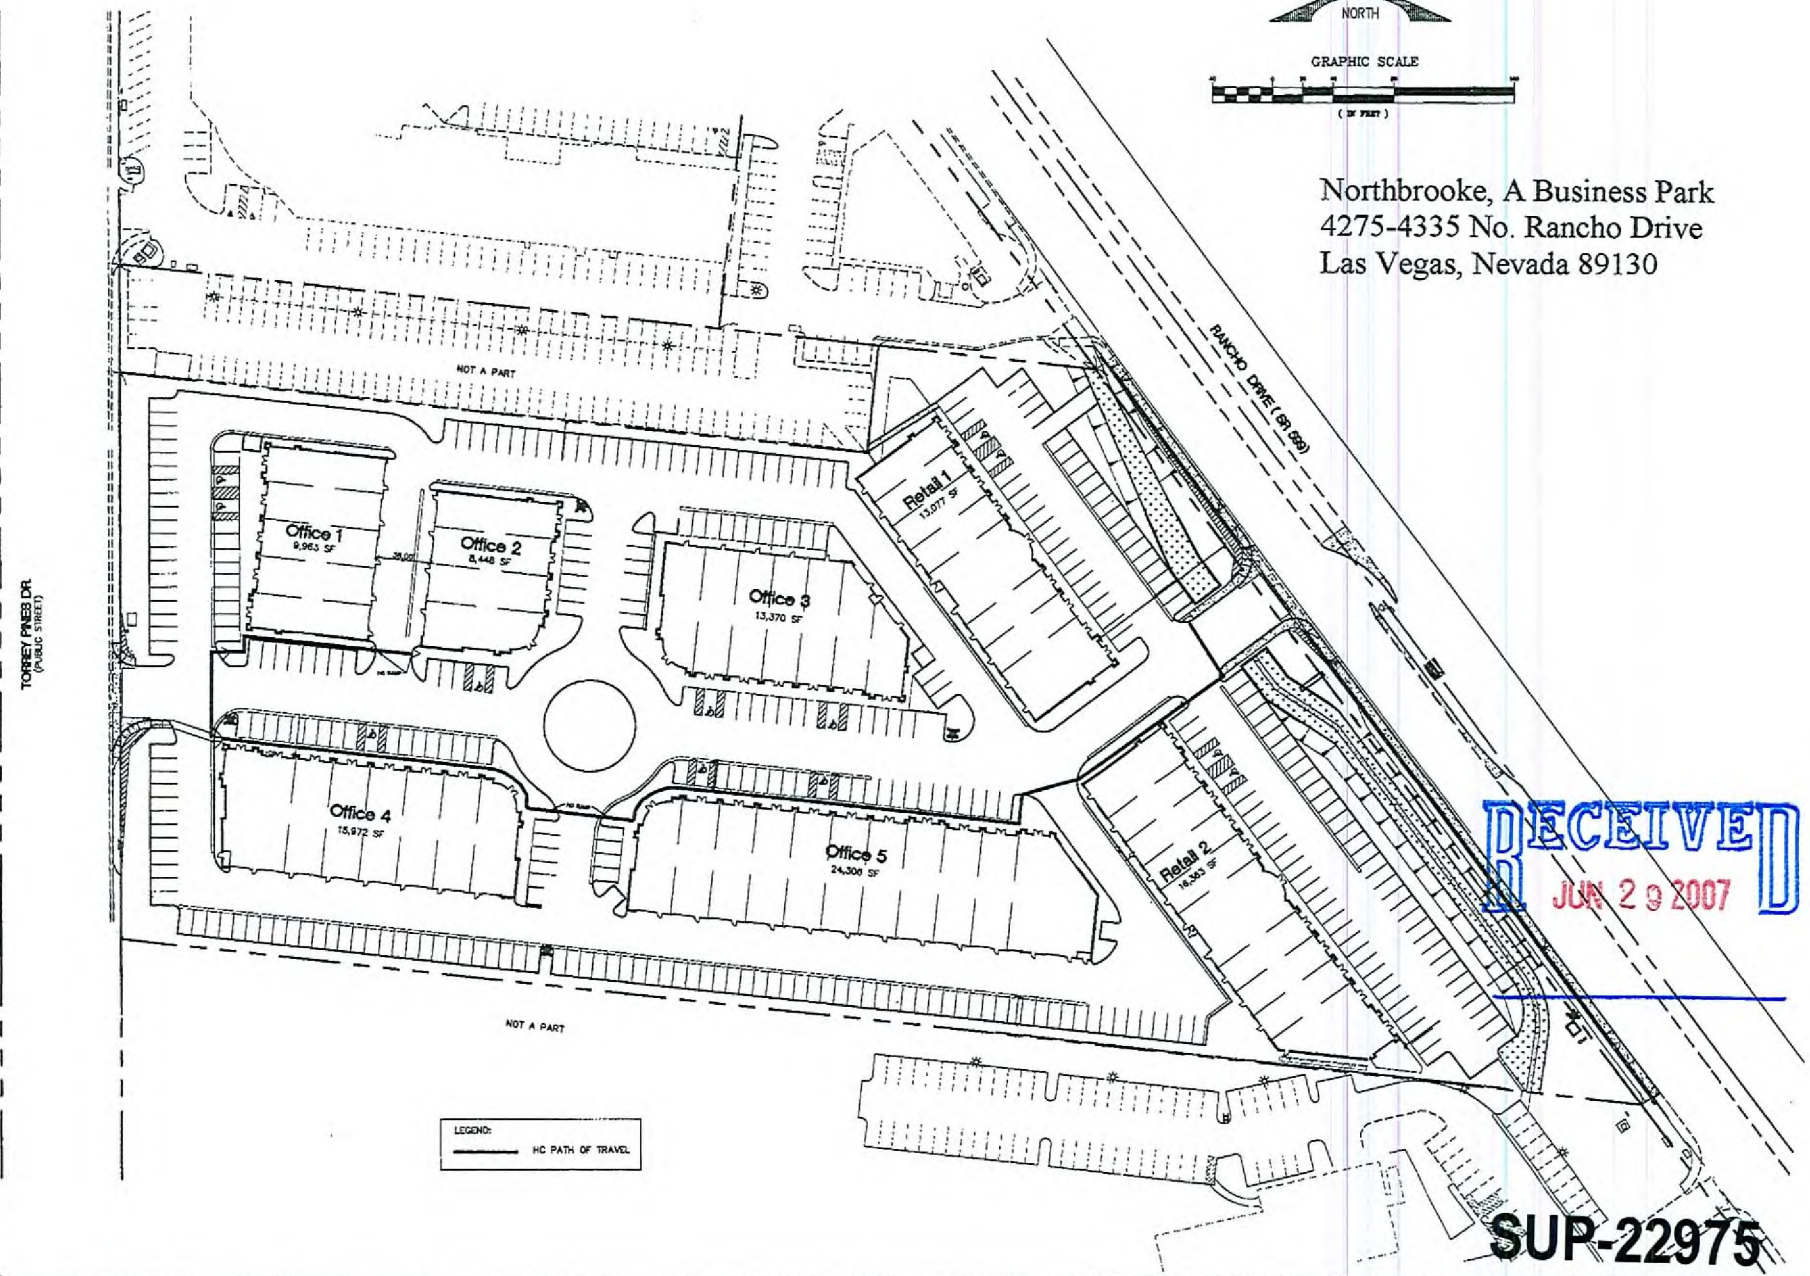

RECEIVED  
JUN 29 2007

SUP-22975  
08/23/07 PC

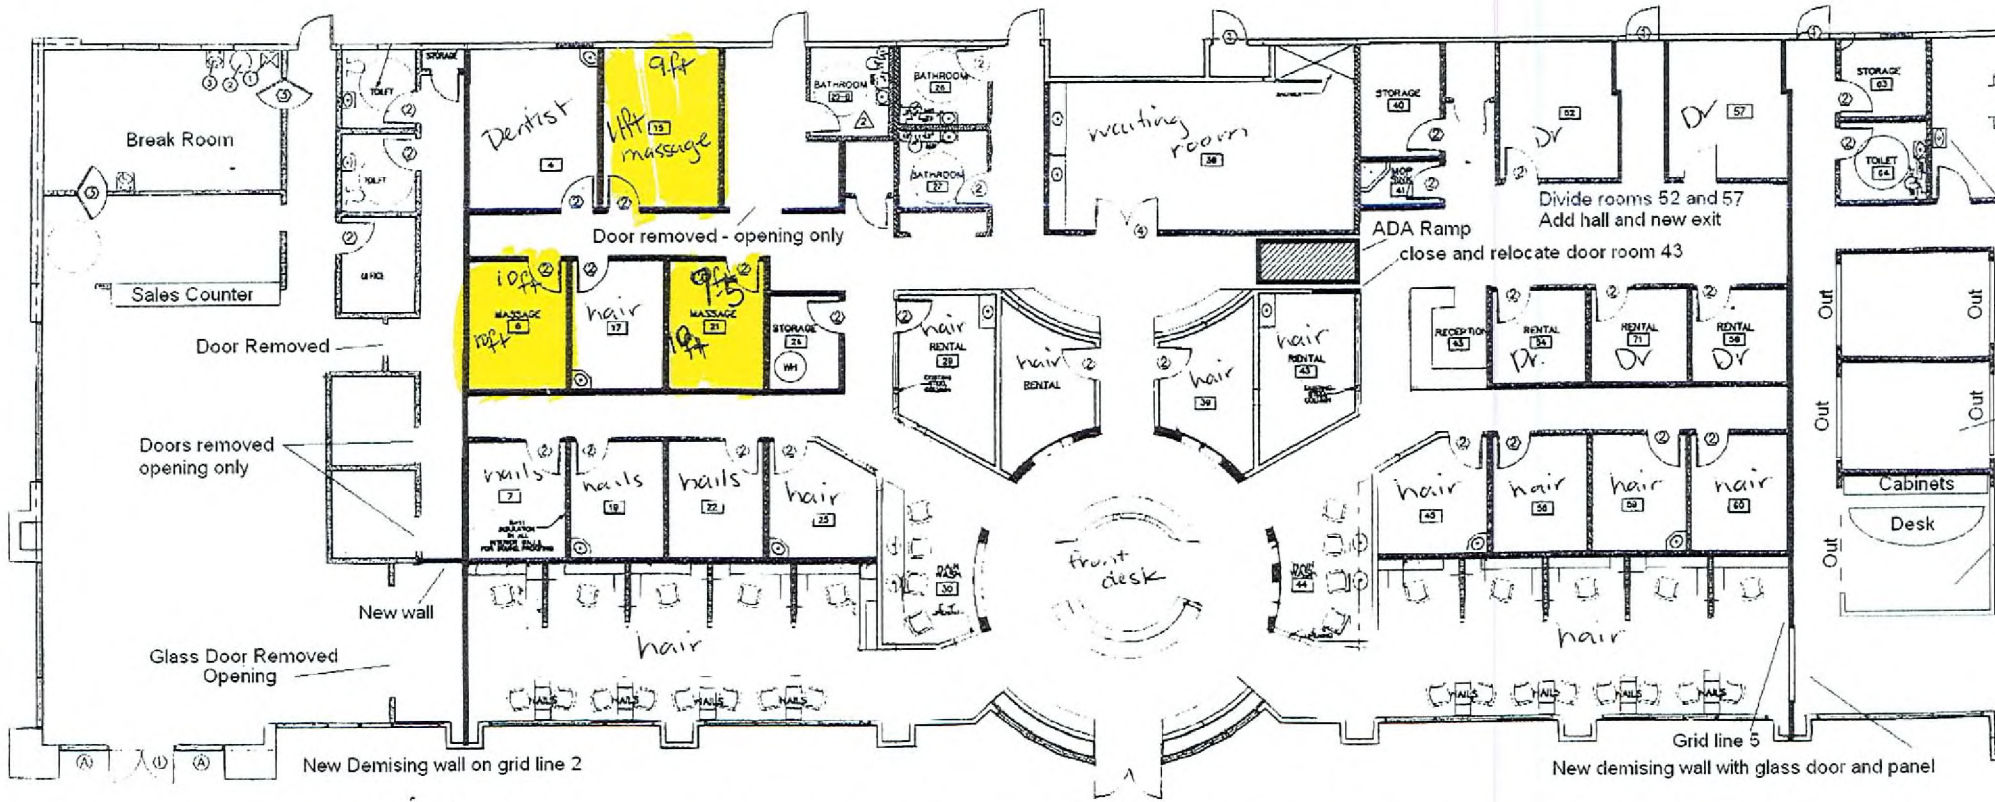

*Whole building*  
*13,086*  
*Prise 7,938 sq ft*

4335 No. Rancho Drive, Las Vegas, Nevada 89130

Suite 110 - Elegance Formal Wear

Suite 150 - Privé Salon

Suite 180 - B<sup>2</sup> Boutique

RECEIVED

JUL 27 2007

**SUP-22975**  
**REVISED**  
**08/23/07 PC**