



**PLANNING & DEVELOPMENT DEPARTMENT**

**STATEMENT OF FINANCIAL INTEREST**

Case Number: **ZON-20475** APN: 125-06-002-003 ptn; 125-07-101-001 ptn

Name of Property Owner: KYLE ACQUISITION GROUP, LLC

Name of Applicant: KYLE ACQUISITION GROUP, LLC

Name of Representative: QUADRANT PLANNING

To the best of your knowledge, does the Mayor or any member of the City Council or Planning Commission have any financial interest in this or any other property with the property owner, applicant, the property owner or applicant's general or limited partners, or an officer of their corporation or limited liability company?

Yes

No

If yes, please indicate the member of the City Council or Planning Commission who is involved and list the name(s) of the person or persons with whom the City Official holds an interest. Also list the Assessor's Parcel Number if the property in which the interest is held is different from the case parcel.

City Official: \_\_\_\_\_

Partner(s): \_\_\_\_\_

APN: \_\_\_\_\_

Signature of Property Owner: \_\_\_\_\_

Print Name: JOHN A. RITTER

Subscribed and sworn before me

This 13 day of March, 2007

Kelly Hermanson  
Notary Public in and for said County and State



*[Handwritten initials]*  
CJC



# PLANNING & DEVELOPMENT DEPARTMENT

## STATEMENT OF FINANCIAL INTEREST

Case Number: **ZON-20475** APN: 125-07-101-002 ptn; 125-06-002-007

Name of Property Owner: KYLE ACQUISITION GROUP, LLC

Name of Applicant: KYLE ACQUISITION GROUP, LLC

Name of Representative: QUADRANT PLANNING

To the best of your knowledge, does the Mayor or any member of the City Council or Planning Commission have any financial interest in this or any other property with the property owner, applicant, the property owner or applicant's general or limited partners, or an officer of their corporation or limited liability company?

Yes

No

If yes, please indicate the member of the City Council or Planning Commission who is involved and list the name(s) of the person or persons with whom the City Official holds an interest. Also list the Assessor's Parcel Number if the property in which the interest is held is different from the case parcel.

City Official: \_\_\_\_\_

Partner(s): \_\_\_\_\_

APN: \_\_\_\_\_

Signature of Property Owner: \_\_\_\_\_

Print Name: JOHN A. RITTER

Subscribed and sworn before me

This 13 day of March, 2007  
Kelly Hermanson  
Notary Public in and for said County and State

*Handwritten initials and signature*  
CJC





**PLANNING & DEVELOPMENT DEPARTMENT**

**STATEMENT OF FINANCIAL INTEREST**

Case Number: **ZON-20475** APN: 125-06-002-006

Name of Property Owner: KYLE CANYON GATEWAY CENTER, LLC

Name of Applicant: KYLE ACQUISITION GROUP, LLC

Name of Representative: QUADRANT PLANNING

To the best of your knowledge, does the Mayor or any member of the City Council or Planning Commission have any financial interest in this or any other property with the property owner, applicant, the property owner or applicant's general or limited partners, or an officer of their corporation or limited liability company?


Yes  No

If yes, please indicate the member of the City Council or Planning Commission who is involved and list the name(s) of the person or persons with whom the City Official holds an interest. Also list the Assessor's Parcel Number if the property in which the interest is held is different from the case parcel.


City Official: \_\_\_\_\_


Partner(s): \_\_\_\_\_

APN: \_\_\_\_\_

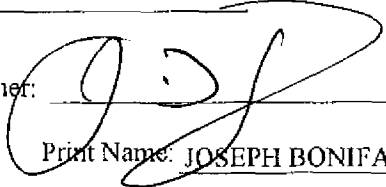Signature of Property Owner:   
Print Name: JOSEPH BONIFATTO

Subscribed and sworn before me

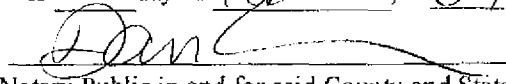This 27 day of Feb, 2007  
  
Notary Public in and for said County and State

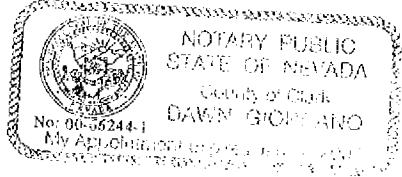



**PLANNING & DEVELOPMENT DEPARTMENT**

**STATEMENT OF FINANCIAL INTEREST**

Case Number: **ZON-20475** APN: 125-06-002-005

Name of Property Owner: RANCHO WAY, LLC

Name of Applicant: KYLE ACQUISITION GROUP, LLC

Name of Representative: QUADRANT PLANNING

To the best of your knowledge, does the Mayor or any member of the City Council or Planning Commission have any financial interest in this or any other property with the property owner, applicant, the property owner or applicant's general or limited partners, or an officer of their corporation or limited liability company?

Yes


No

If yes, please indicate the member of the City Council or Planning Commission who is involved and list the name(s) of the person or persons with whom the City Official holds an interest. Also list the Assessor's Parcel Number if the property in which the interest is held is different from the case parcel.

City Official: \_\_\_\_\_

Partner(s): \_\_\_\_\_


APN: \_\_\_\_\_

Signature of Property Owner: 

Print Name: NIMA TAGHAVI


Subscribed and sworn before me

This 28th day of February, 2007

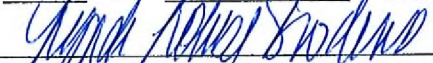  
Notary Public in and for said County and State  
Lynda Louise Broderick  
County of Orange )

Revised 11-14-06 )  
State of California )



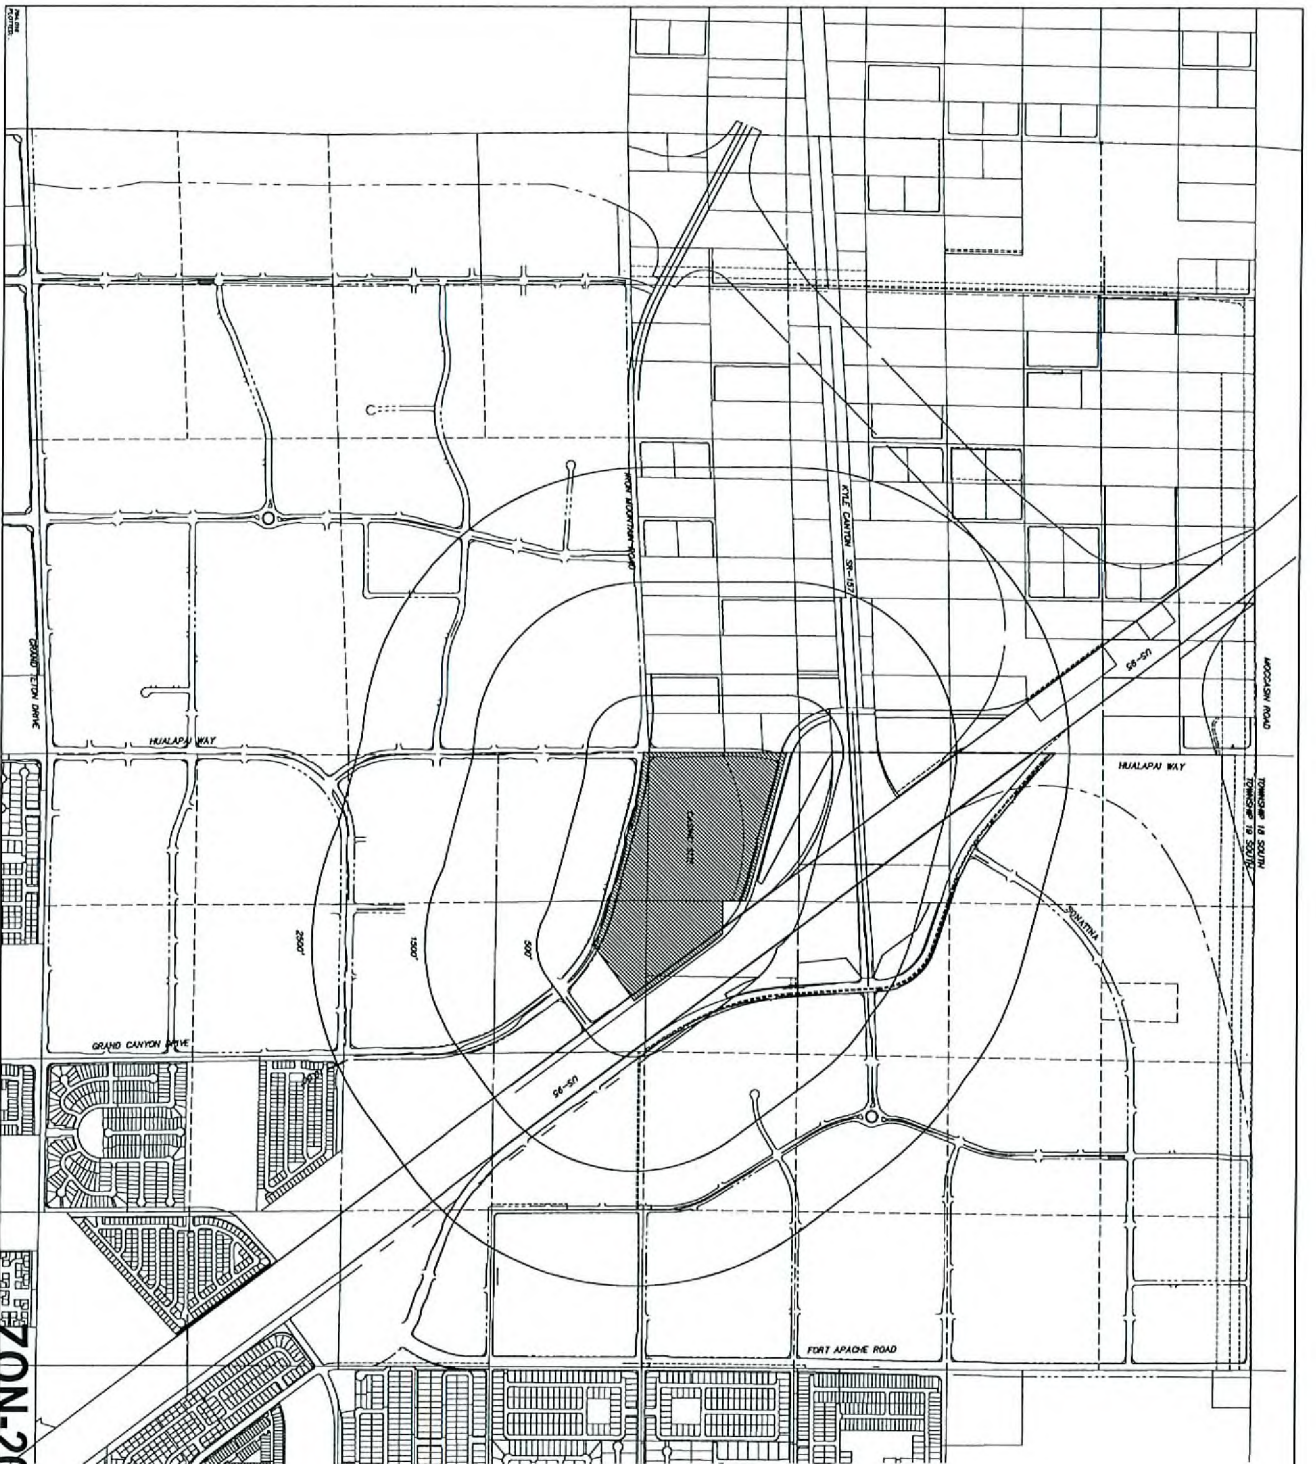


**RECEIVED**  
**REVISION**  
**07/12/07 PC**

**ZON-20475**

**RECEIVED**

**JUN 04 2007**

SHEET <b>1</b> OF 1 SHEETS	<b>KYLE CANYON CASINO</b>	 <b>G.C. WALLACE, INC.</b> Engineers/Planners/Surveyors 1535 SOUTH RANDOLPH BLVD., EAST VEGAS, NEVADA 89146	REV	DATE	DESCRIPTION
	<b>CASINO SITE 500', 1500', 2500' OFFSETS</b>				

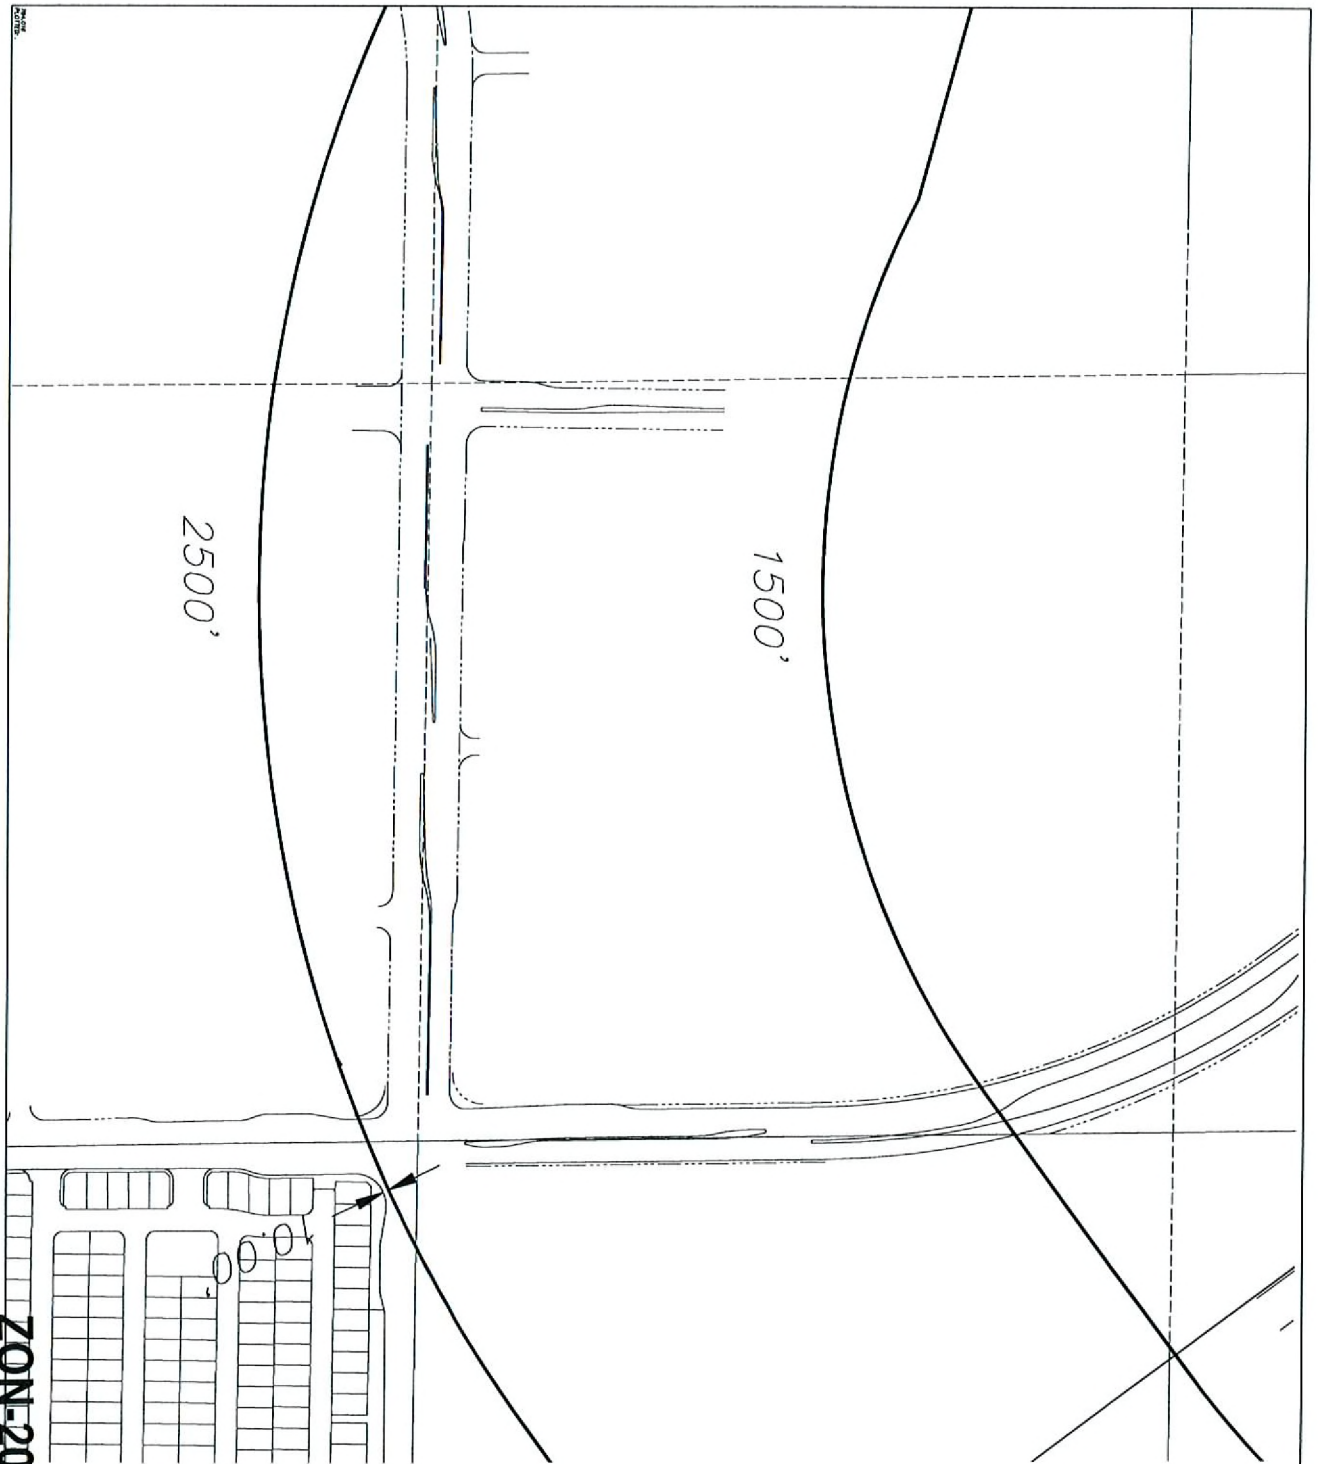

**ZON-20475**  
**REVISED**  
**07/12/07 PC**

**RECEIVED**  
**JUN 04 2007**

REV	DATE	DESCRIPTION

