



PLANNING & DEVELOPMENT DEPARTMENT

STATEMENT OF FINANCIAL INTEREST

Case Number: **VAC-24711** APN: 139 27 210 031

Name of Property Owner: Pentecostal Temple Church of God in Christ, Inc.

Name of Applicant: Leon Smith, Pastor

Name of Representative: Leon Smith, Pastor

To the best of your knowledge, does the Mayor or any member of the City Council or Planning Commission have any financial interest in this or any other property with the property owner, applicant, the property owner or applicant's general or limited partners, or an officer of their corporation or limited liability company?

Yes

No

If yes, please indicate the member of the City Council or Planning Commission who is involved and list the name(s) of the person or persons with whom the City Official holds an interest. Also list the Assessor's Parcel Number if the property in which the interest is held is different from the case parcel.

City Official: _____

Partner(s): _____

APN: _____


Signature of Property Owner: *Leon Smith*





Print Name: Leon Smith

Subscribed and sworn before me

This 20 day of September, 2007

Maria Cortez
Notary Public in and for said County and State

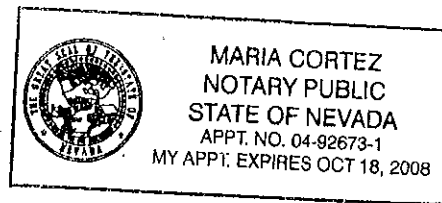

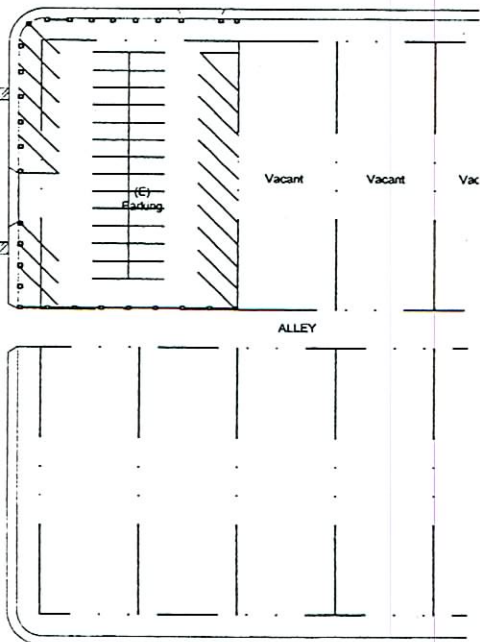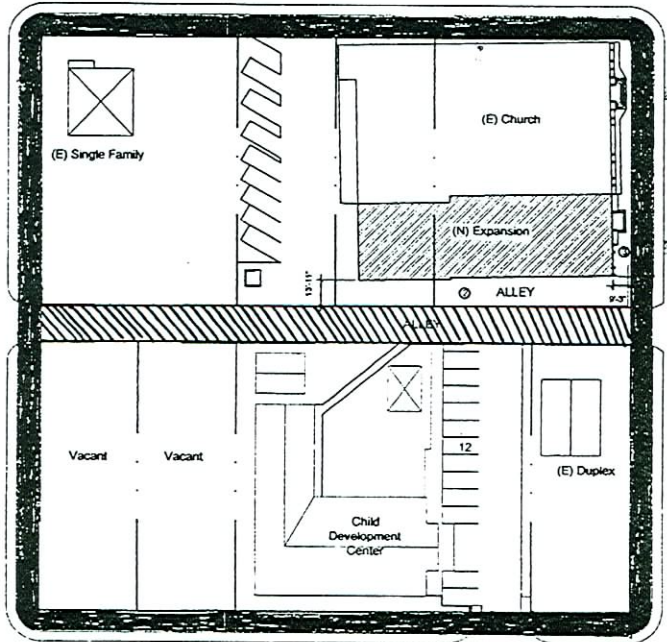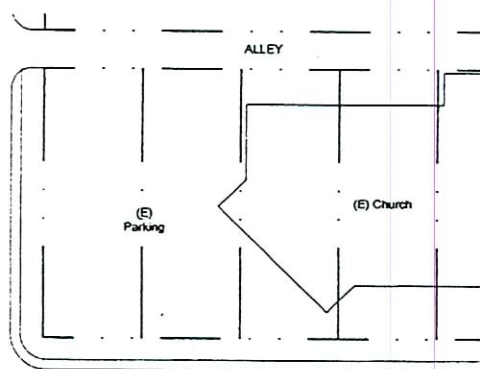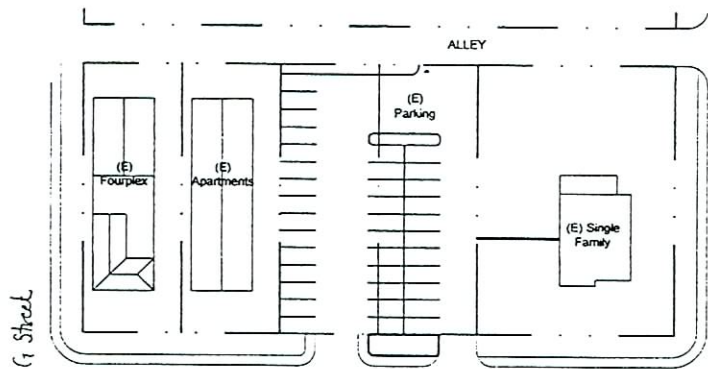

SITE ANALYSIS

Location	1117 F Street
Zoning	C-V Civic District
(E) Church	Sanctuary
	Seats
(E) Parking	101 Stalls
New Expansion	Multi Purpose
	5,224 Sq. Ft.

Notes

10'-0" RIGHT AWAY
 PROPOSED VACATION OF 10'-0" RIGHT AWAY
 FROM JEFFERSON AVENUE TO MADISON AVENUE
 AND FROM 'F' STREET TO 'G' STREET AS OUTLINED
 ON SITE PLAN

VACATION OF ALLEN
 PROPOSED VACATION OF ALLEY
 FROM 'F' STREET TO 'G' STREET
 BETWEEN JEFFERSON AVENUE TO
 MADISON AVENUE AS OUTLINED
 ON SITE PLAN

1 Site Plan
 Scale: 1" = 30'-0"


VAC-24711
REVISED
11/08/07 PC

RECEIVED
 OCT 18 2007

REVISIONS	
PENTECOSTAL TEMPLE	
1117 F Street	
Las Vegas Nevada 89106	
Site Plan & Site Analysis	June 21, 2007
A0.1	

620 | 618 | 616 | 612 | C-V | 002

MADISON AVE

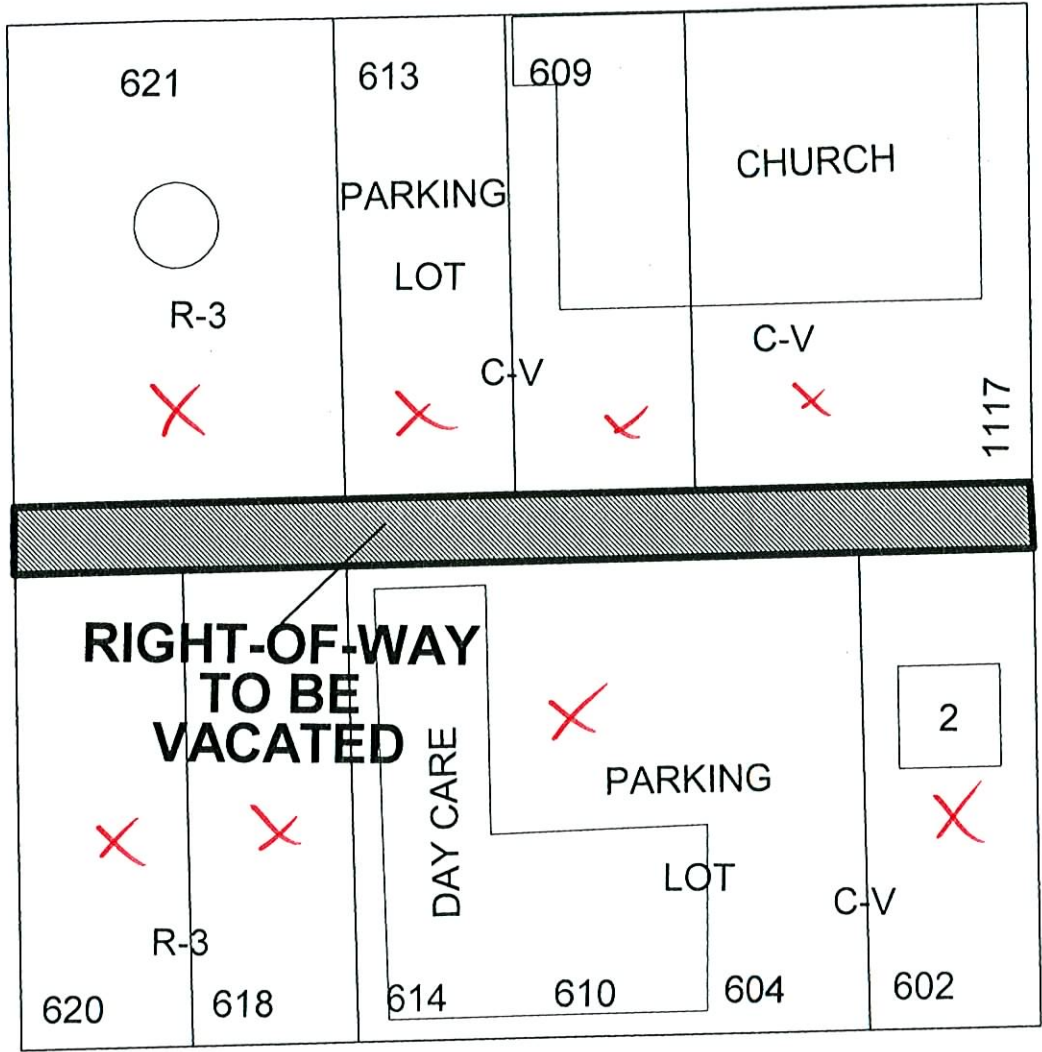

ST
G

ST
F

**RIGHT-OF-WAY
TO BE
VACATED**

JEFFERSON AVE

_____ R-3 _____

0 1020 Feet



CASE: VAC-24711

