



PLANNING & DEVELOPMENT DEPARTMENT

STATEMENT OF FINANCIAL INTEREST

Case Number: **SUP-25460** APN: 162-05-818-002
 Name of Property Owner: SAHARA-SAB-NEVADA LLC
 Name of Applicant: MIKE'S LIQUOR, LLC
 Name of Representative: MARC BISHMAN

To the best of your knowledge, does the Mayor or any member of the City Council or Planning Commission have any financial interest in this or any other property with the property owner, applicant, the property owner or applicant's general or limited partners, or an officer of their corporation or limited liability company?

_____ Yes

X No

If yes, please indicate the member of the City Council or Planning Commission who is involved and list the name(s) of the person or persons with whom the City Official holds an interest. Also list the Assessor's Parcel Number if the property in which the interest is held is different from the case parcel.

City Official: _____

Partner(s): _____

APN: _____

Signature of Property Owner: SAHARA-SAB NEVADA LLC BY [Signature]


Print Name: SIMON SABER

Subscribed and sworn before me

This 02 day of November, 2007
California, La. CA.


Notary Public in and for said County and State

Marine Pogosyan

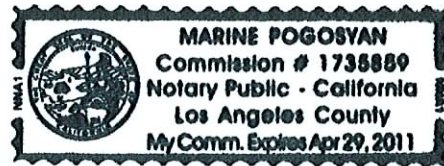

RECEIVED

NOV 05 2007

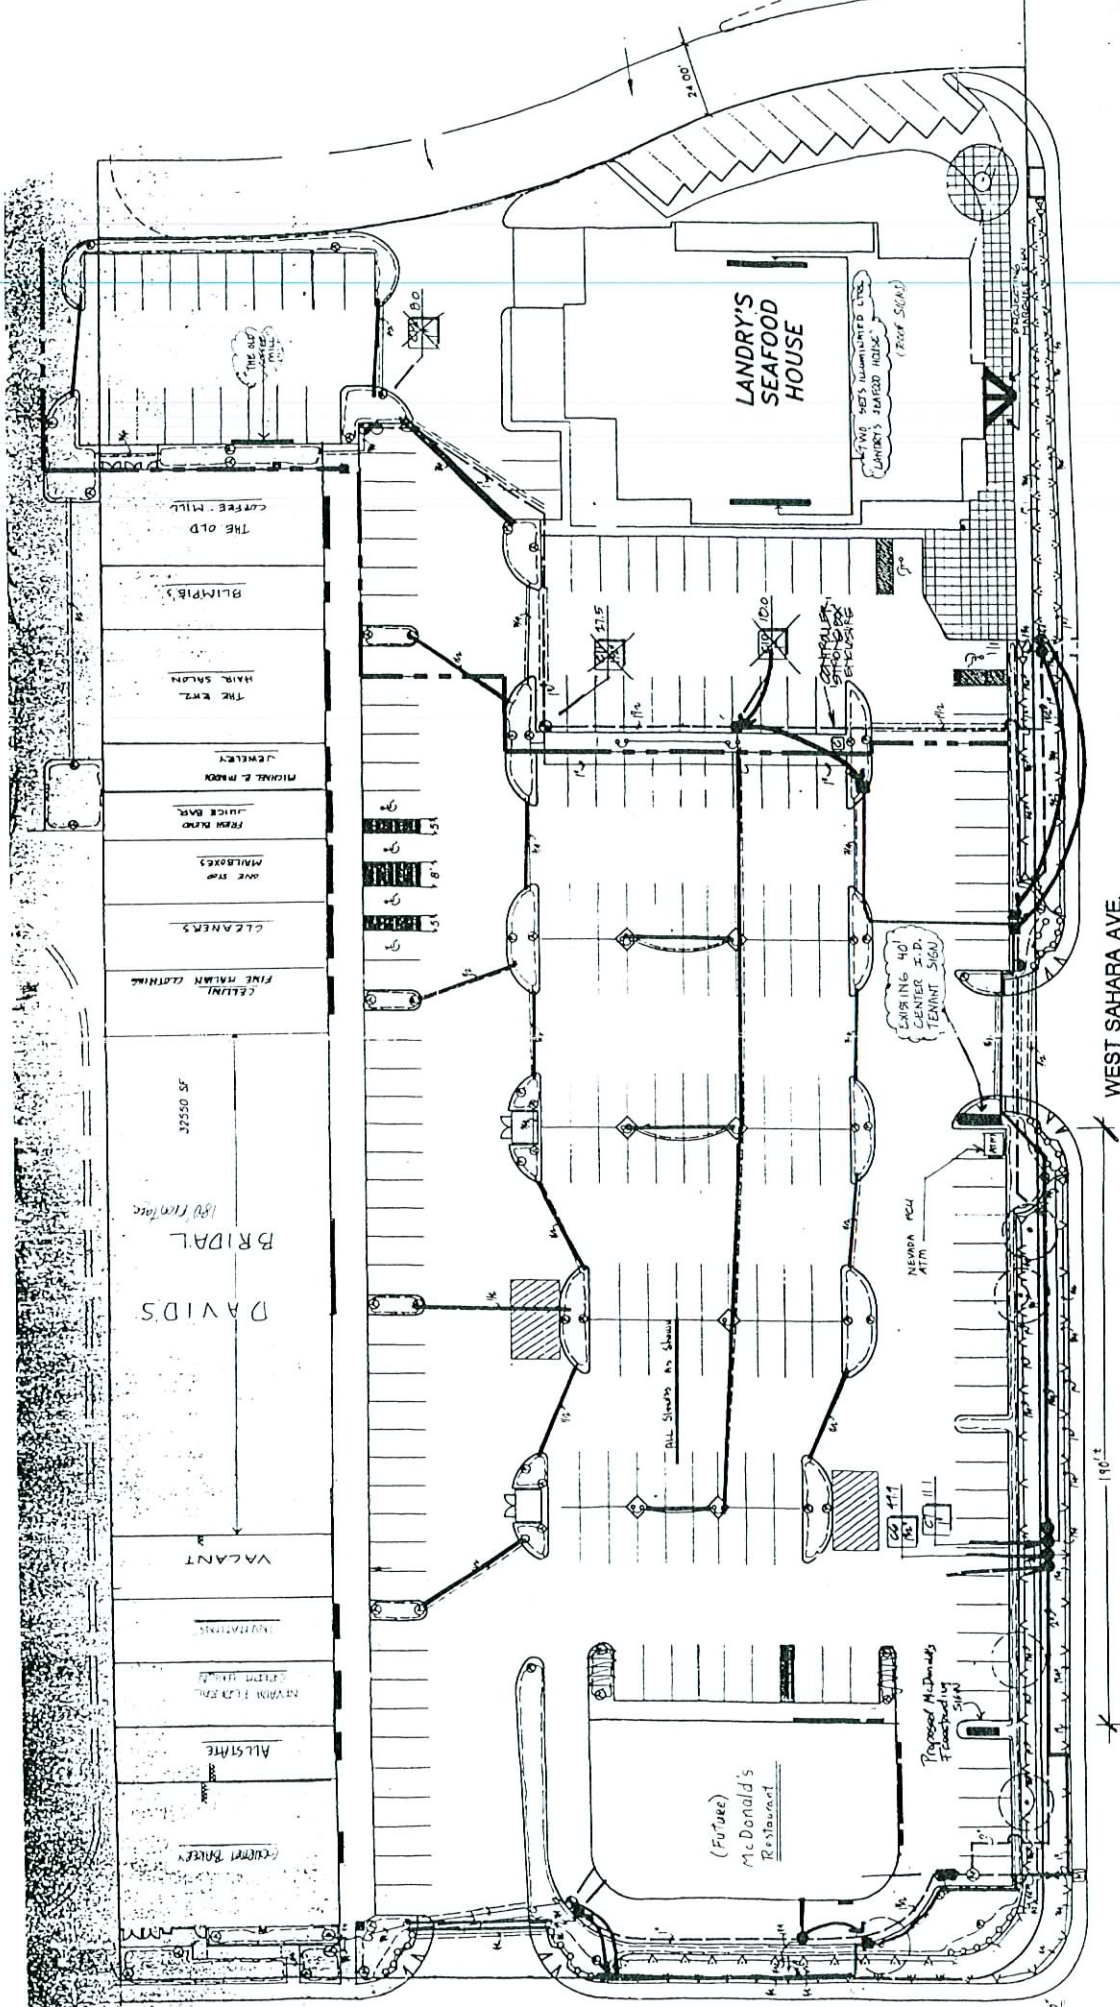

PASEO DEL PRADO

WEST SAHARA AVE.


RECEIVED
 NOV 05 2007
 SUP-25460
 12/20/07 PC

SAE 1/20
 Prepared
 11-20-07

PARKING ANNY 12
 GFA SUITE 103 9/04 = 2800 SF
 PARKING REQUIRED $\frac{2800}{250} = 12$ NOS
 PARKING PROVIDED = 19 NOS

2600 W SAHARA
 STE 103, 104
 LAS VEGAS, NV 89102

RECEIVED
 NOV 05 2007

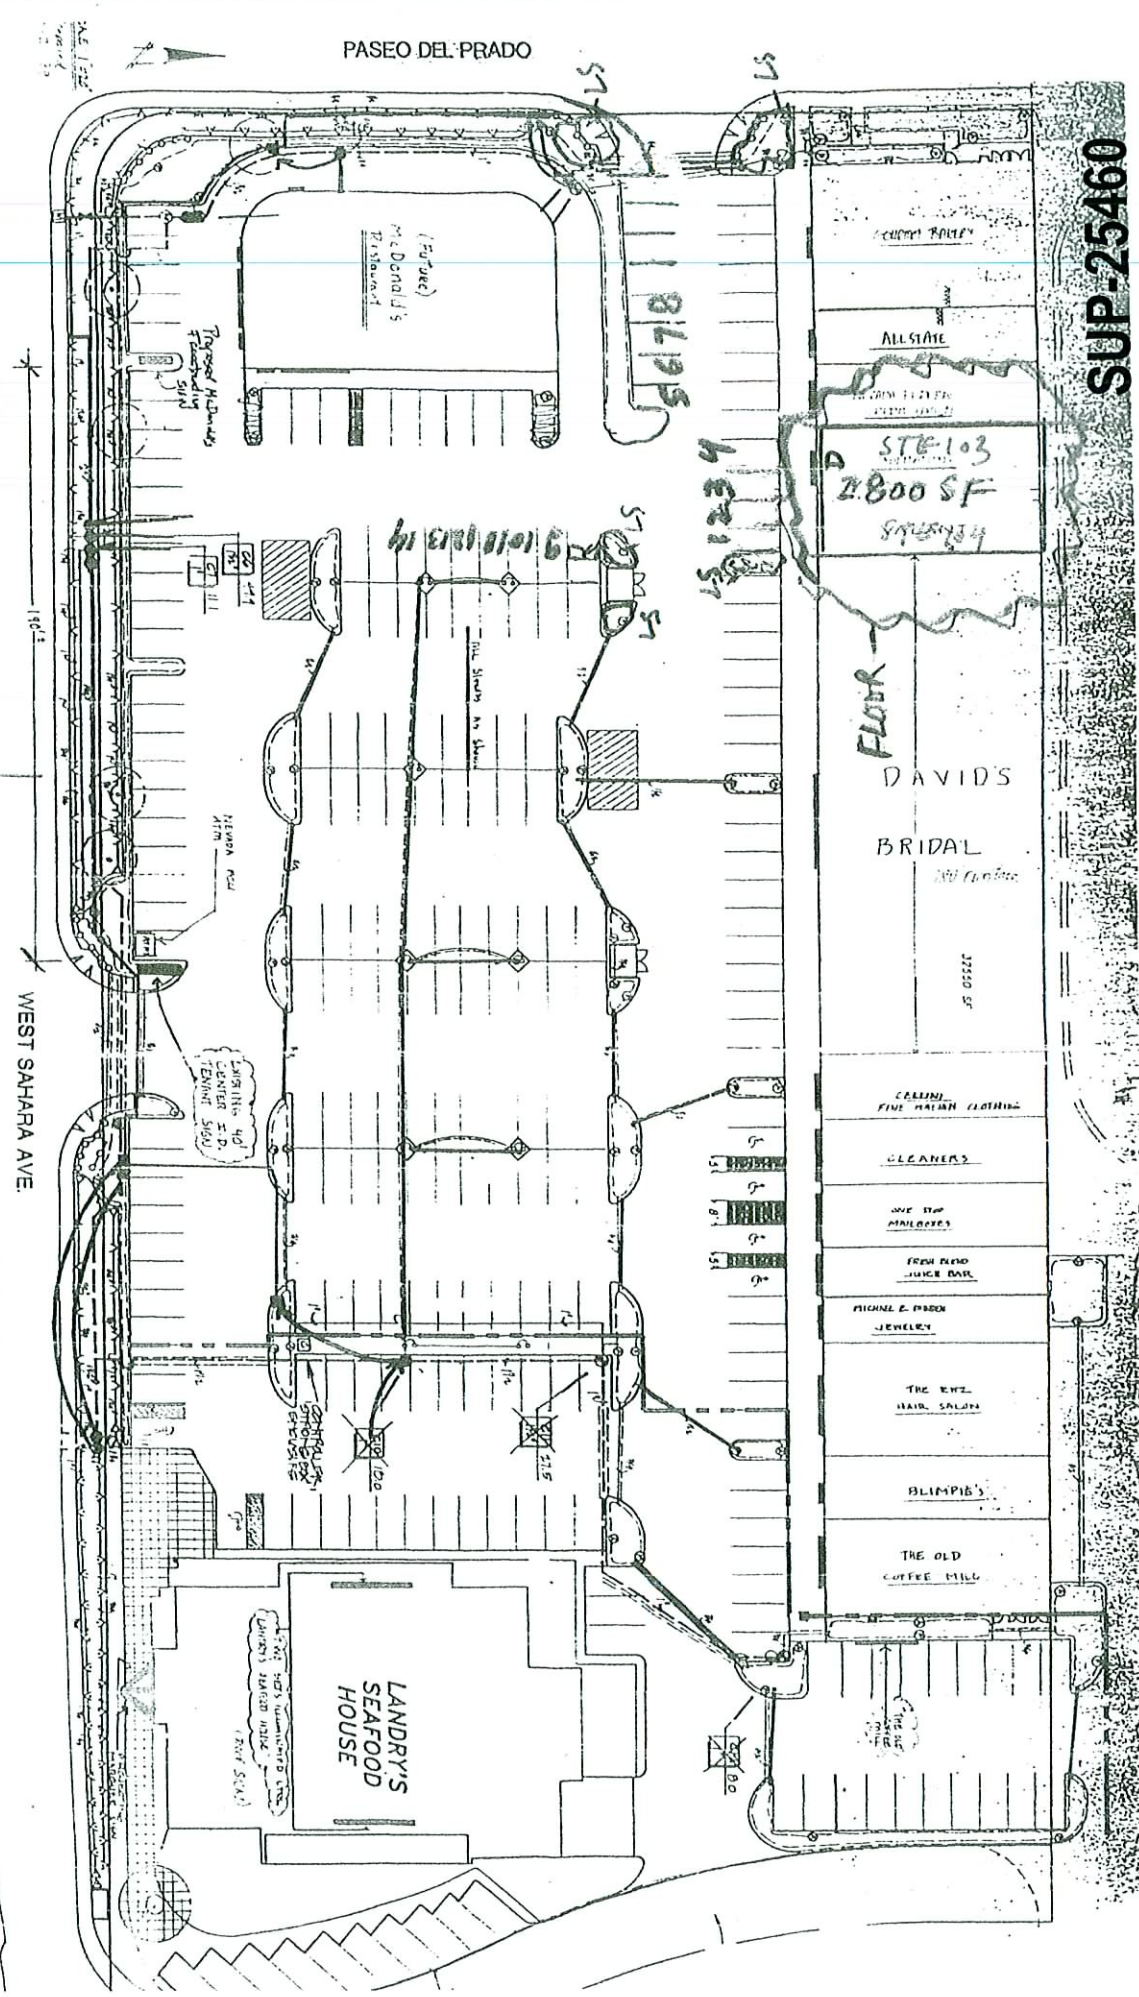


SUP-25460

12/20/07 PC



GROSS AREA 2800 SQ FT
 BATH 1 (+) 128 SQ FT ROOMS
 OFFICE (-) 75 SQ FT
 STORAGE (-) 210 SQ FT AREA
 WALK IN COOLER (-) 336 SQ FT
 FREEZER (-) 36 SQ FT
 GAMING (+) 30 SQ FT ATM
 NET AREA 1985 SQ FT

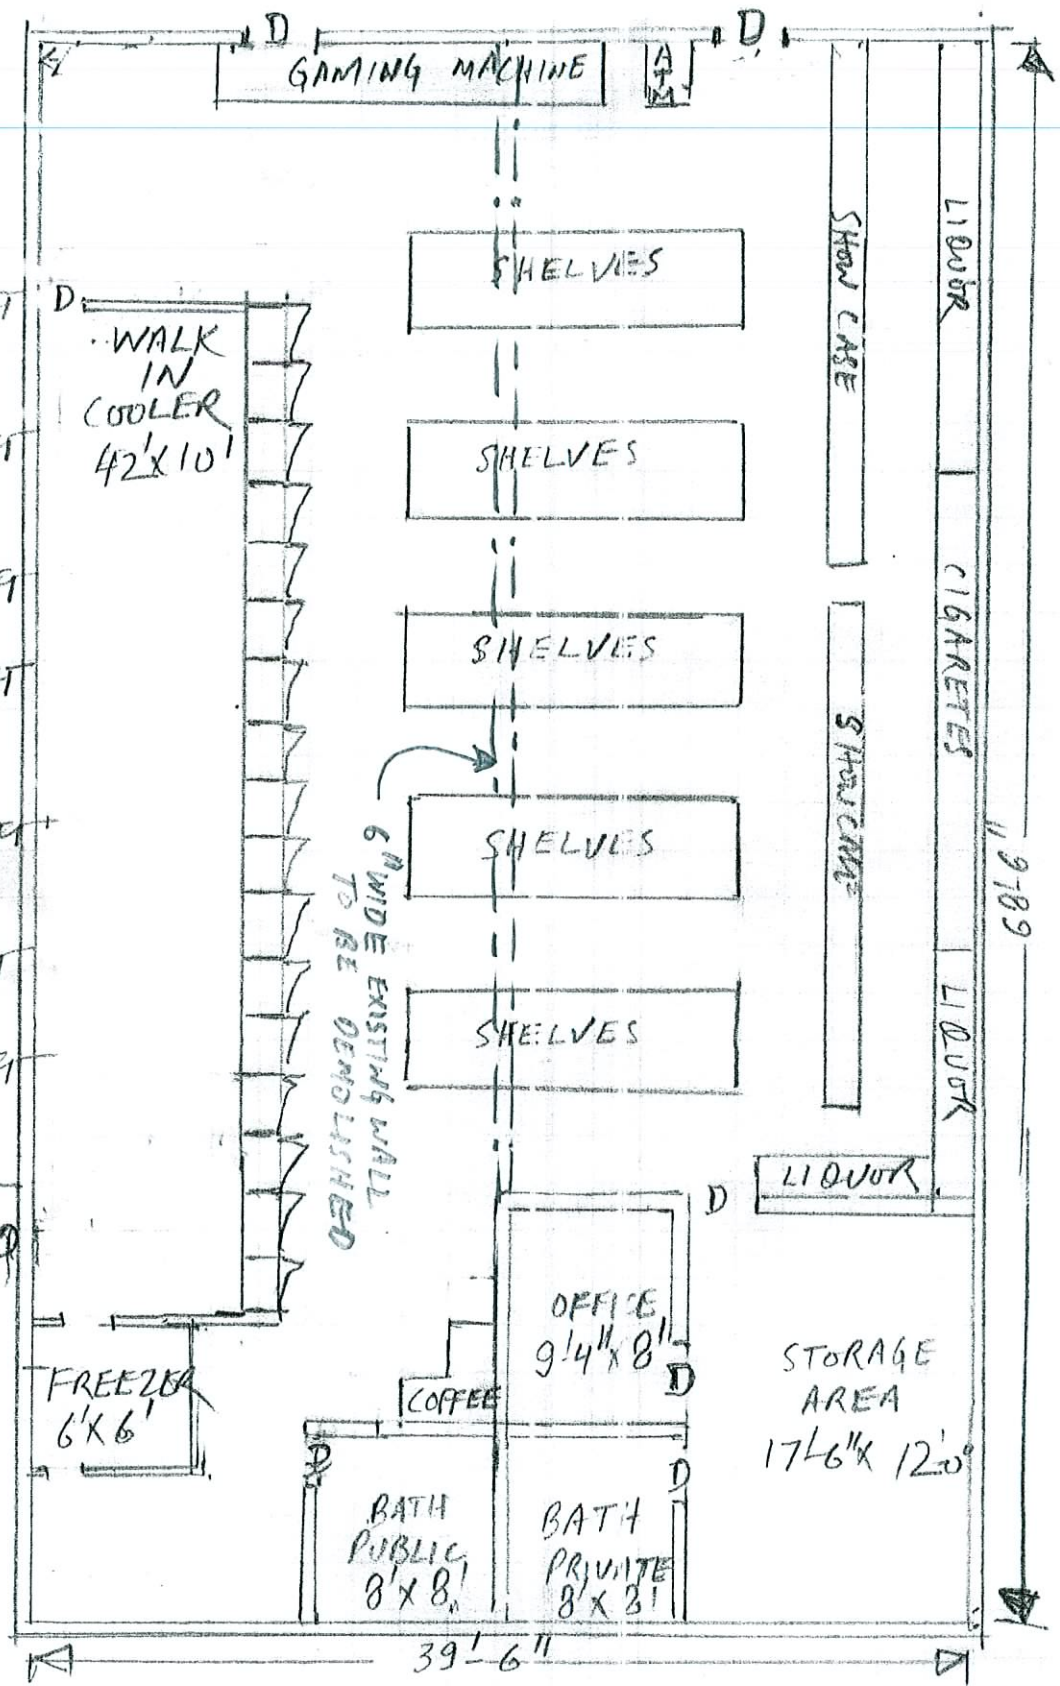

2600 W. SAHARA, STE 103, 104
 LAS VEGAS 89102

RECEIVED

NOV 05 2007

SUP-25460
 12/20/07 PC