



PLANNING & DEVELOPMENT DEPARTMENT

STATEMENT OF FINANCIAL INTEREST

Case Number: **SUP-25476** APN: 138-15-402-001

Name of Property Owner: Tech Retail Center

Name of Applicant: Cashback

Name of Representative: Greater Nevada Planning, Inc.

To the best of your knowledge, does the Mayor or any member of the City Council or Planning Commission have any financial interest in this or any other property with the property owner, applicant, the property owner or applicant's general or limited partners, or an officer of their corporation or limited liability company?

 Yes X No

If yes, please indicate the member of the City Council or Planning Commission who is involved and list the name(s) of the person or persons with whom the City Official holds an interest. Also list the Assessor's Parcel Number if the property in which the interest is held is different from the case parcel.

City Official: N/A

Partner(s): N/A

APN: N/A


Signature of Property Owner: *[Signature]*

Print Name: Dale Downs

Subscribed and sworn before me

This 29th day of OCTOBER, 2007

Tina West
Notary Public in and for said County and State

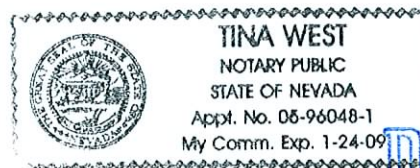


Site Data

ASSESSOR'S PARCEL NUMBER (APN)	138 15-02-001
CURRENT ZONING	U
PROPOSED ZONING	C-1
TOTAL PARKING REQUIRED	113 SPACES

Owner / Developer

INVESTMENT EQUITY BUILDERS
 4560 S. DECATUR, SUITE 200
 LAS VEGAS, NEVADA 89103
 DAVID L. INMAN (702) 871-4545

Vicinity Map

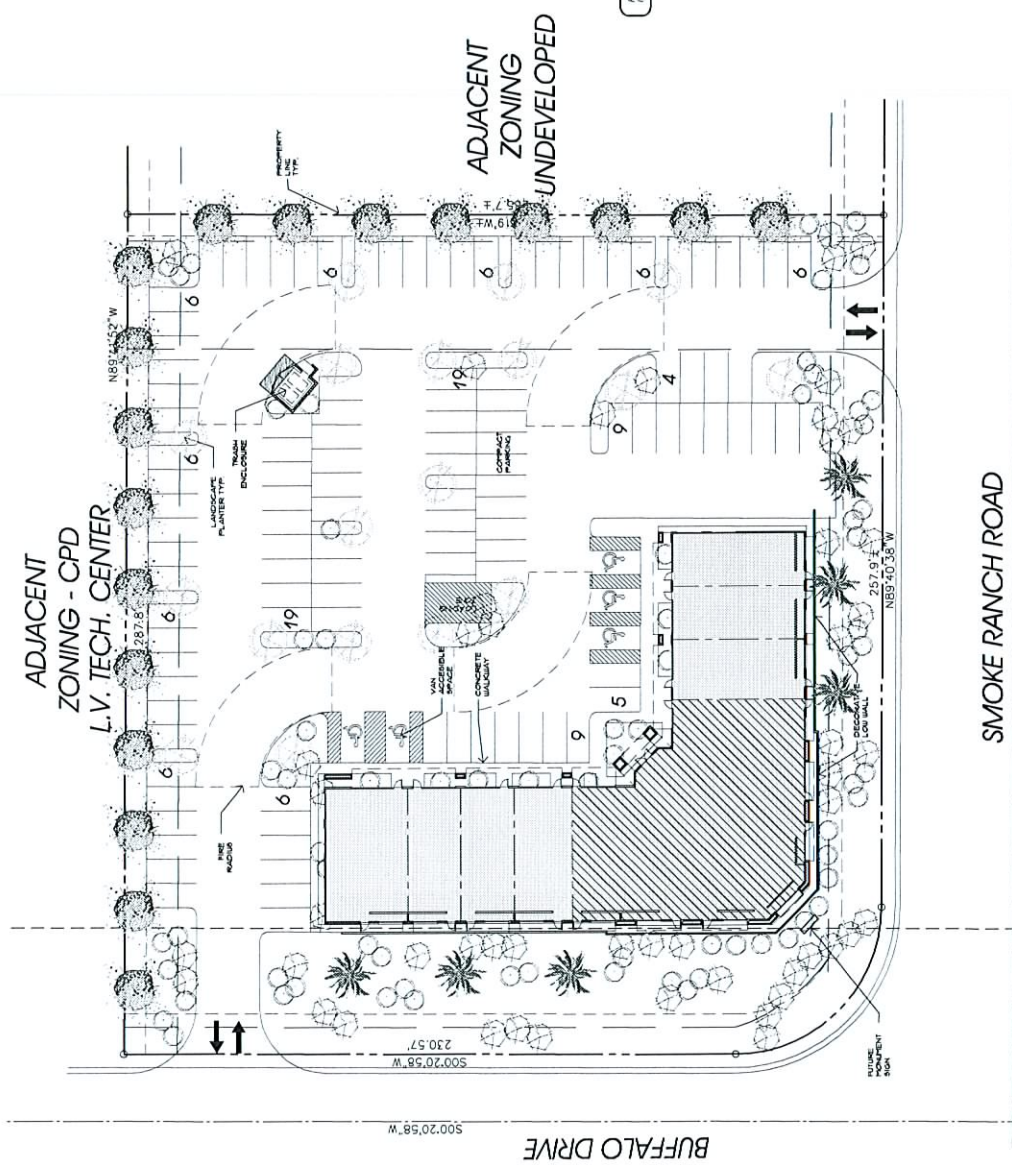

Site Plan
 Scale: 1" = 20'-0"

Tech Retail Center I

Schematic Design
 © Copyright Ingigo Architecture, Inc. 2004

February 3, 2004


Las Vegas, Nevada



RECEIVED
 NOV 06 2007

SUP-25476
12/20/07 PC

Note: This plan is Conceptual in Nature and No Guarantor of its accuracy is implied.

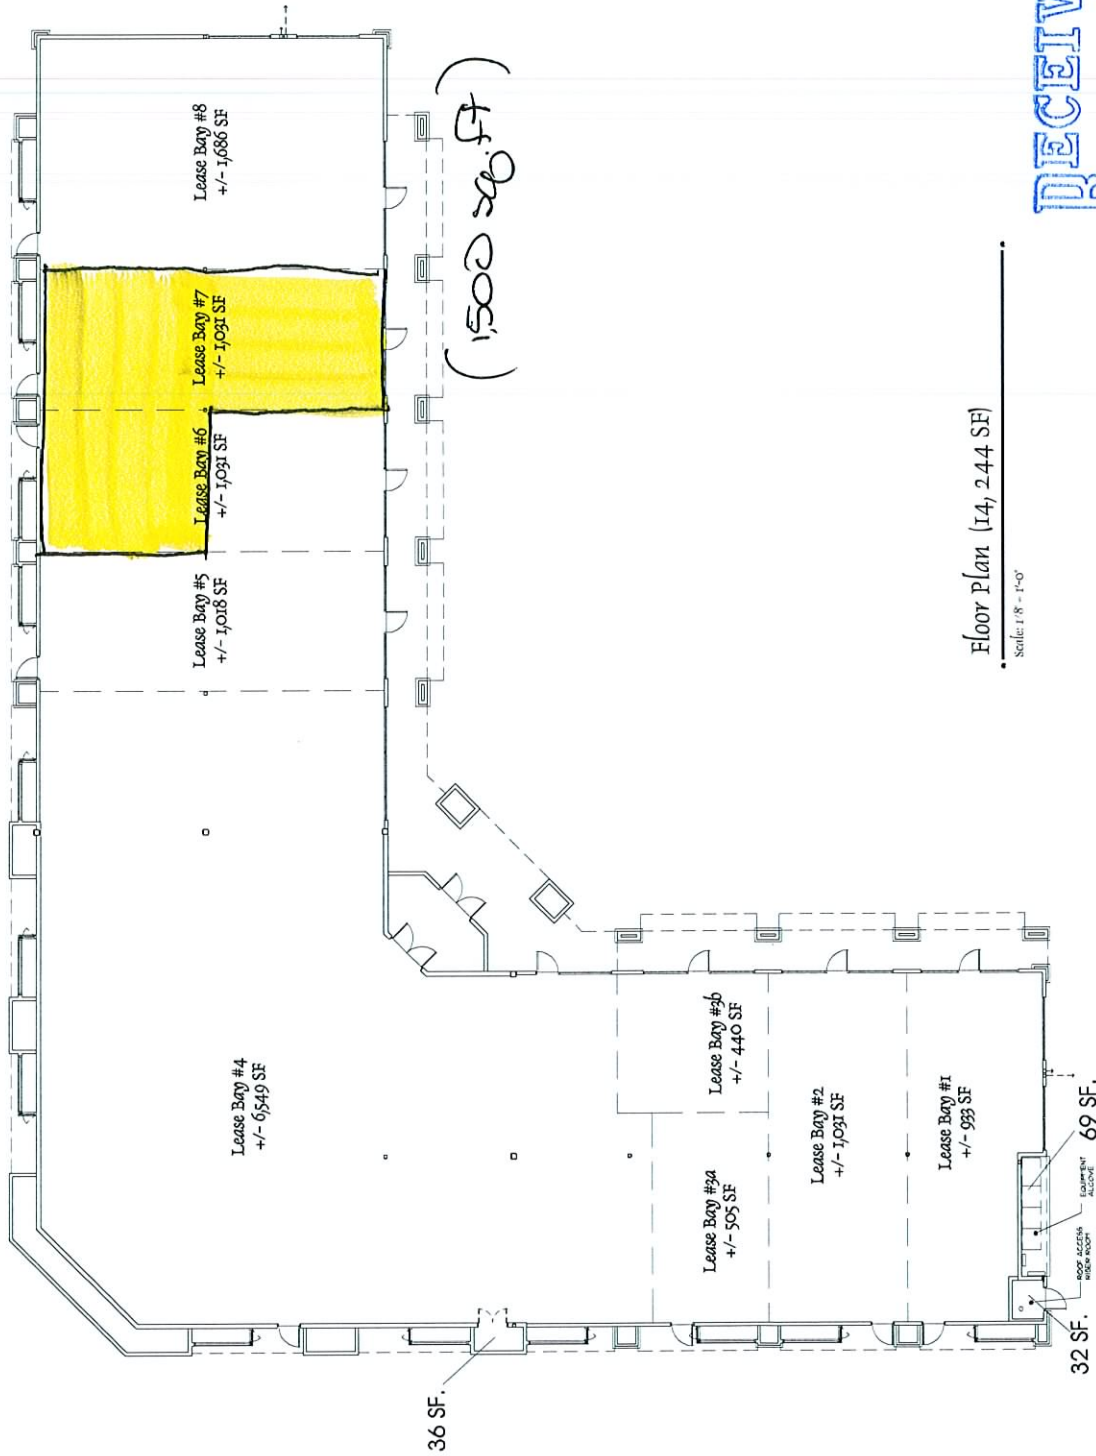

Floor Plan (14, 244 SF)
Scale: 1/8" = 1'-0"

Tech Retail Center I

Schematic Design
© Copyright 2007, Indigo Architecture, Inc. 2006

RECEIVED
NOV 06 2007
04:18p

SUP-25476
12/20/07 PC



Note: This design is Conceptual in Nature, and No Guarantee of its accuracy is supplied.



Indigo Architecture, Inc.
810 S. Maryland Ave., Suite 100
Las Vegas, Nevada 89101
702.496.2772



Project No. 04189
 Drawn By: ASBY, CES
 Date: June 10, 2004
 Scale: AS NOTED
 Sheet No. A5.02

PROJECT NAME: Tech Retail Center
 PROJECT TITLE: Smoke Ranch Road at Buffalo Drive
 PHASE I
 EXTERIOR ELEVATIONS
 CONSULTANTS

 Scale: 1/8" = 1'-0"

RECEIVED
 NOV 06 2007

SUP-25476
 12/20/07 PC