



**PLANNING & DEVELOPMENT DEPARTMENT**

**STATEMENT OF FINANCIAL INTEREST**

Case Number: **SUP-25255** APN: \_\_\_\_\_

Name of Property Owner: KIRKORIAN ENTERPRISES, LLC, AS AGENT FOR  
SUMMERHILL PLAZA PARTNERS, LLC

Name of Applicant: Mat and Stephanie Fournier

Name of Representative: \_\_\_\_\_

To the best of your knowledge, does the Mayor or any member of the City Council or Planning Commission have any financial interest in this or any other property with the property owner, applicant, the property owner or applicant's general or limited partners, or an officer of their corporation or limited liability company?

Yes  No

If yes, please indicate the member of the City Council or Planning Commission who is involved and list the name(s) of the person or persons with whom the City Official holds an interest. Also list the Assessor's Parcel Number if the property in which the interest is held is different from the case parcel.

City Official: \_\_\_\_\_

Partner(s): \_\_\_\_\_

APN: \_\_\_\_\_

Signature of Property Owner: [Handwritten Signature]

Print Name: JOHN KIRKORIAN


Subscribed and sworn before me

This 22<sup>ND</sup> day of OCTOBER, 2007

Steven Grier

Notary Public in and for said County and State



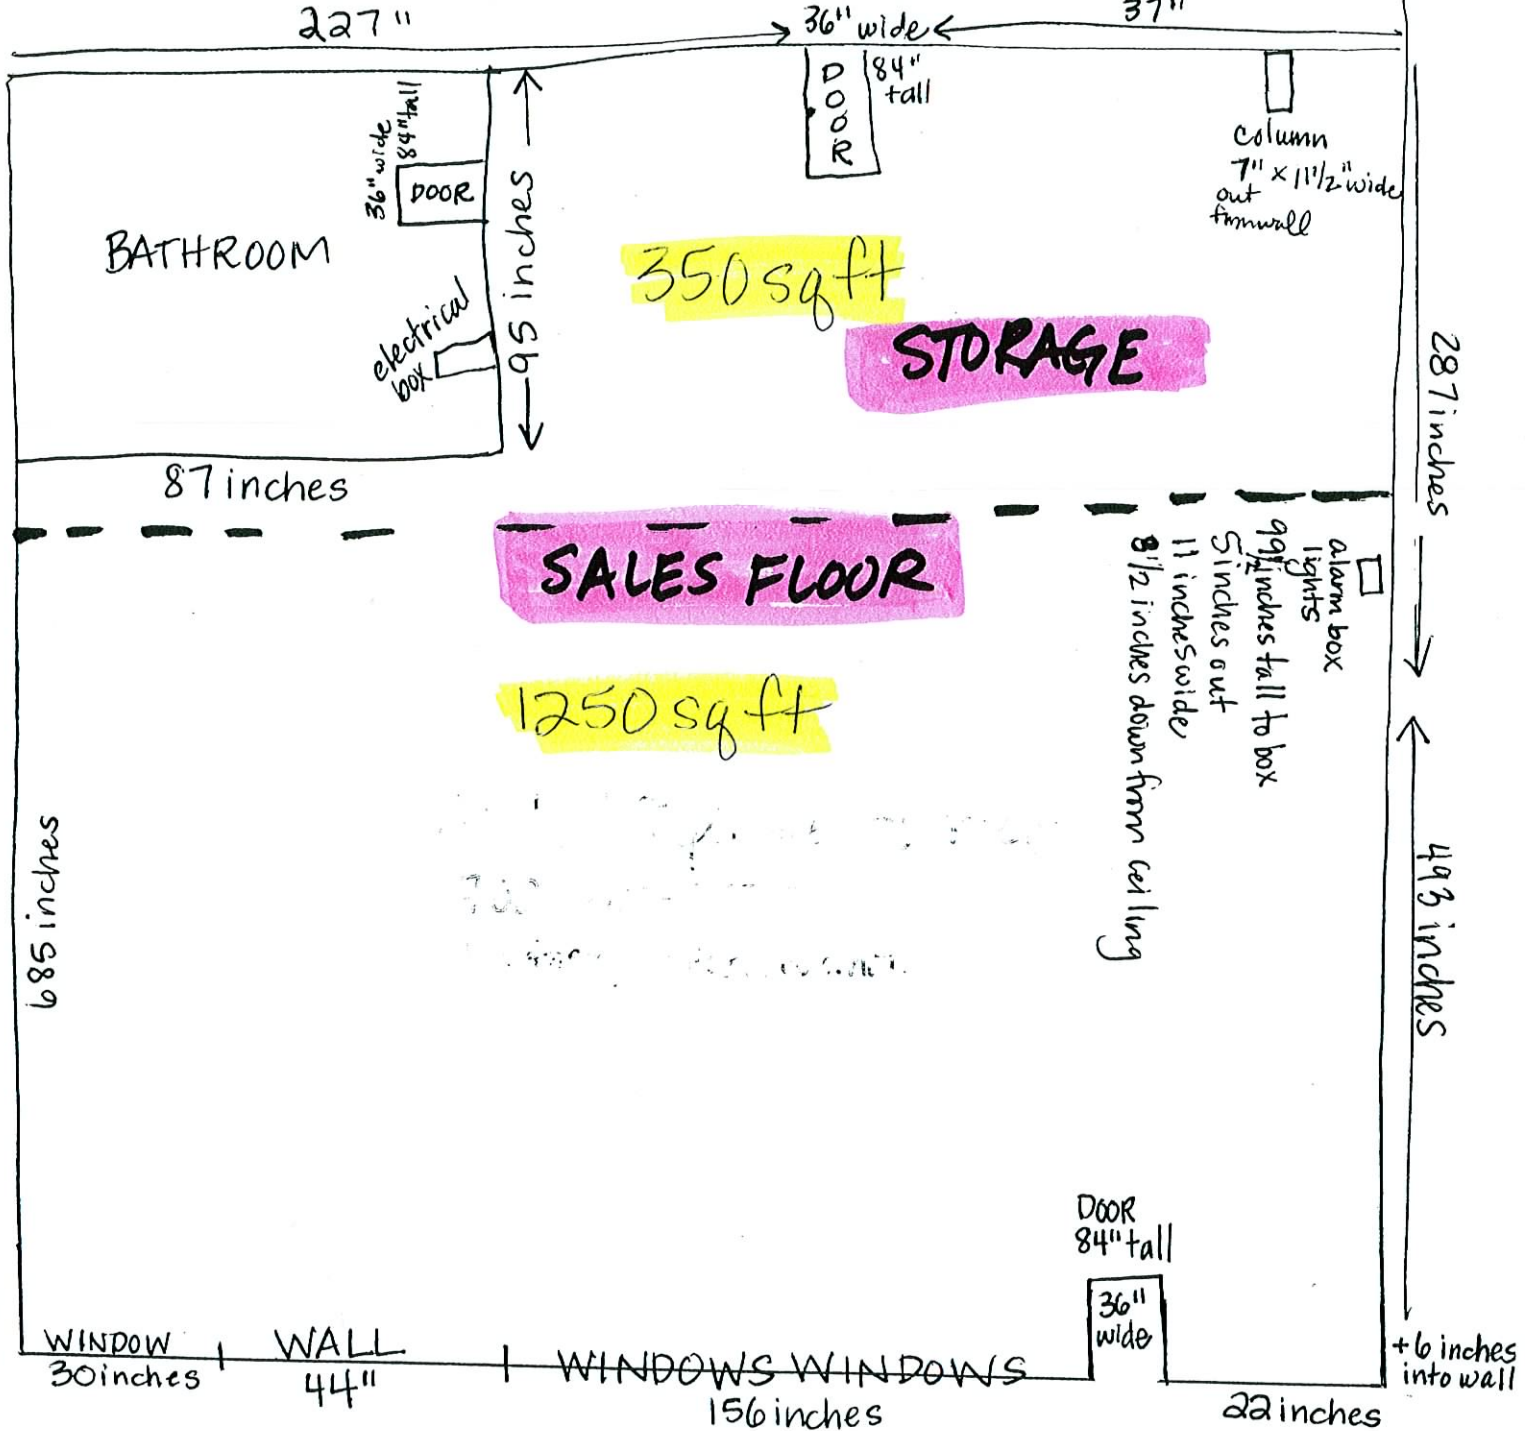

STOREFRONT

**CHILDREN'S ORCHARD**

1600 sq ft

25 x 65

SUP-25255 RECEIVED




12/06/07 PC OCT 23 2007

Ceiling is 9ft tall throughout. Windows in front extend up 9ft. There are add'l windows over door - extending up to 9ft.

7501 W. Lake Mead Blvd  
 Suite #118  
 Las Vegas, NV 89128

Exhibit "A"

SITE PLAN & TYPICAL LEASE SPACE

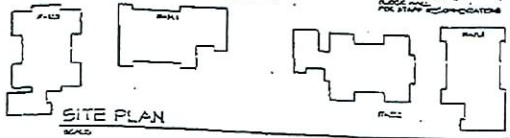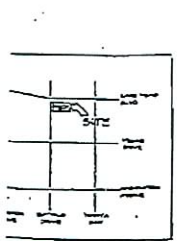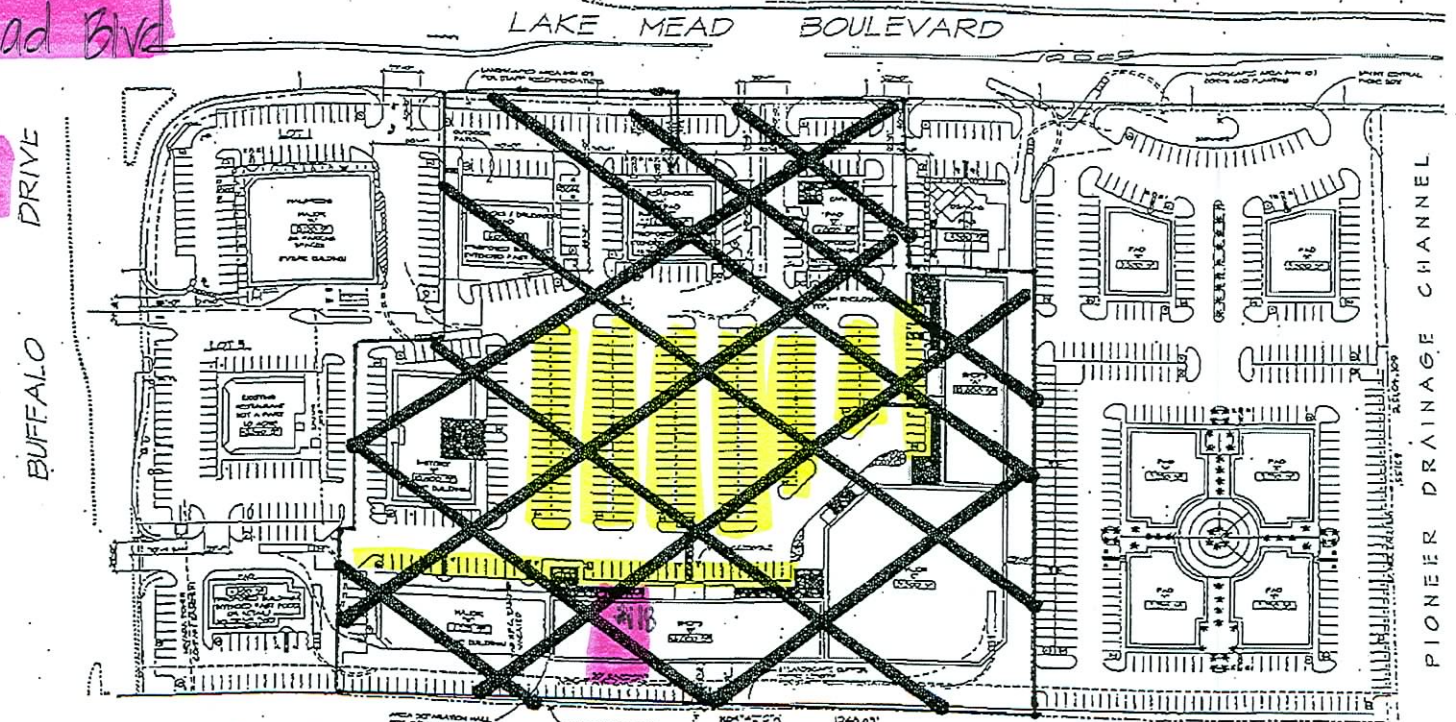




1600 sq ft  
 25x65  
 350 sq ft backroom  
 (250 retail space)

PARKING ANALYSIS  
 1 - 225 sq ft

RECEIVED  
 SUP-25255 OCT 23 2007  
 12/06/07 PC