



PLANNING & DEVELOPMENT DEPARTMENT

STATEMENT OF FINANCIAL INTEREST

Case Number: **SUP-23924** APN: 162-06-402-001

Name of Property Owner: PK II Sahara Pavilion North LLC

Name of Applicant: Regina Edwards

Name of Representative: _____

To the best of your knowledge, does the Mayor or any member of the City Council or Planning Commission have any financial interest in this or any other property with the property owner, applicant, the property owner or applicant's general or limited partners, or an officer of their corporation or limited liability company?

☐ Yes

☒ No

If yes, please indicate the member of the City Council or Planning Commission who is involved and list the name(s) of the person or persons with whom the City Official holds an interest. Also list the Assessor's Parcel Number if the property in which the interest is held is different from the case parcel.

City Official: _____

Partner(s): _____

APN: _____

Signature of Property Owner: PLEASE SEE ATTACHED.

Print Name: _____

Subscribed and sworn before me

This _____ day of _____, 20____

Notary Public in and for said County and State

LAS VEGAS, NV 1510

[illegible]

Sahara Avenue

4/11/07

4/11/07

RECEIVED

AUG 14 2007




Kimco Realty
Corporation

SUP-23924
09/27/07 PC

For more information contact
Doranna Buxton
702-258-4330
dbuxton@kimcorealty.com

Caylix Supper Club

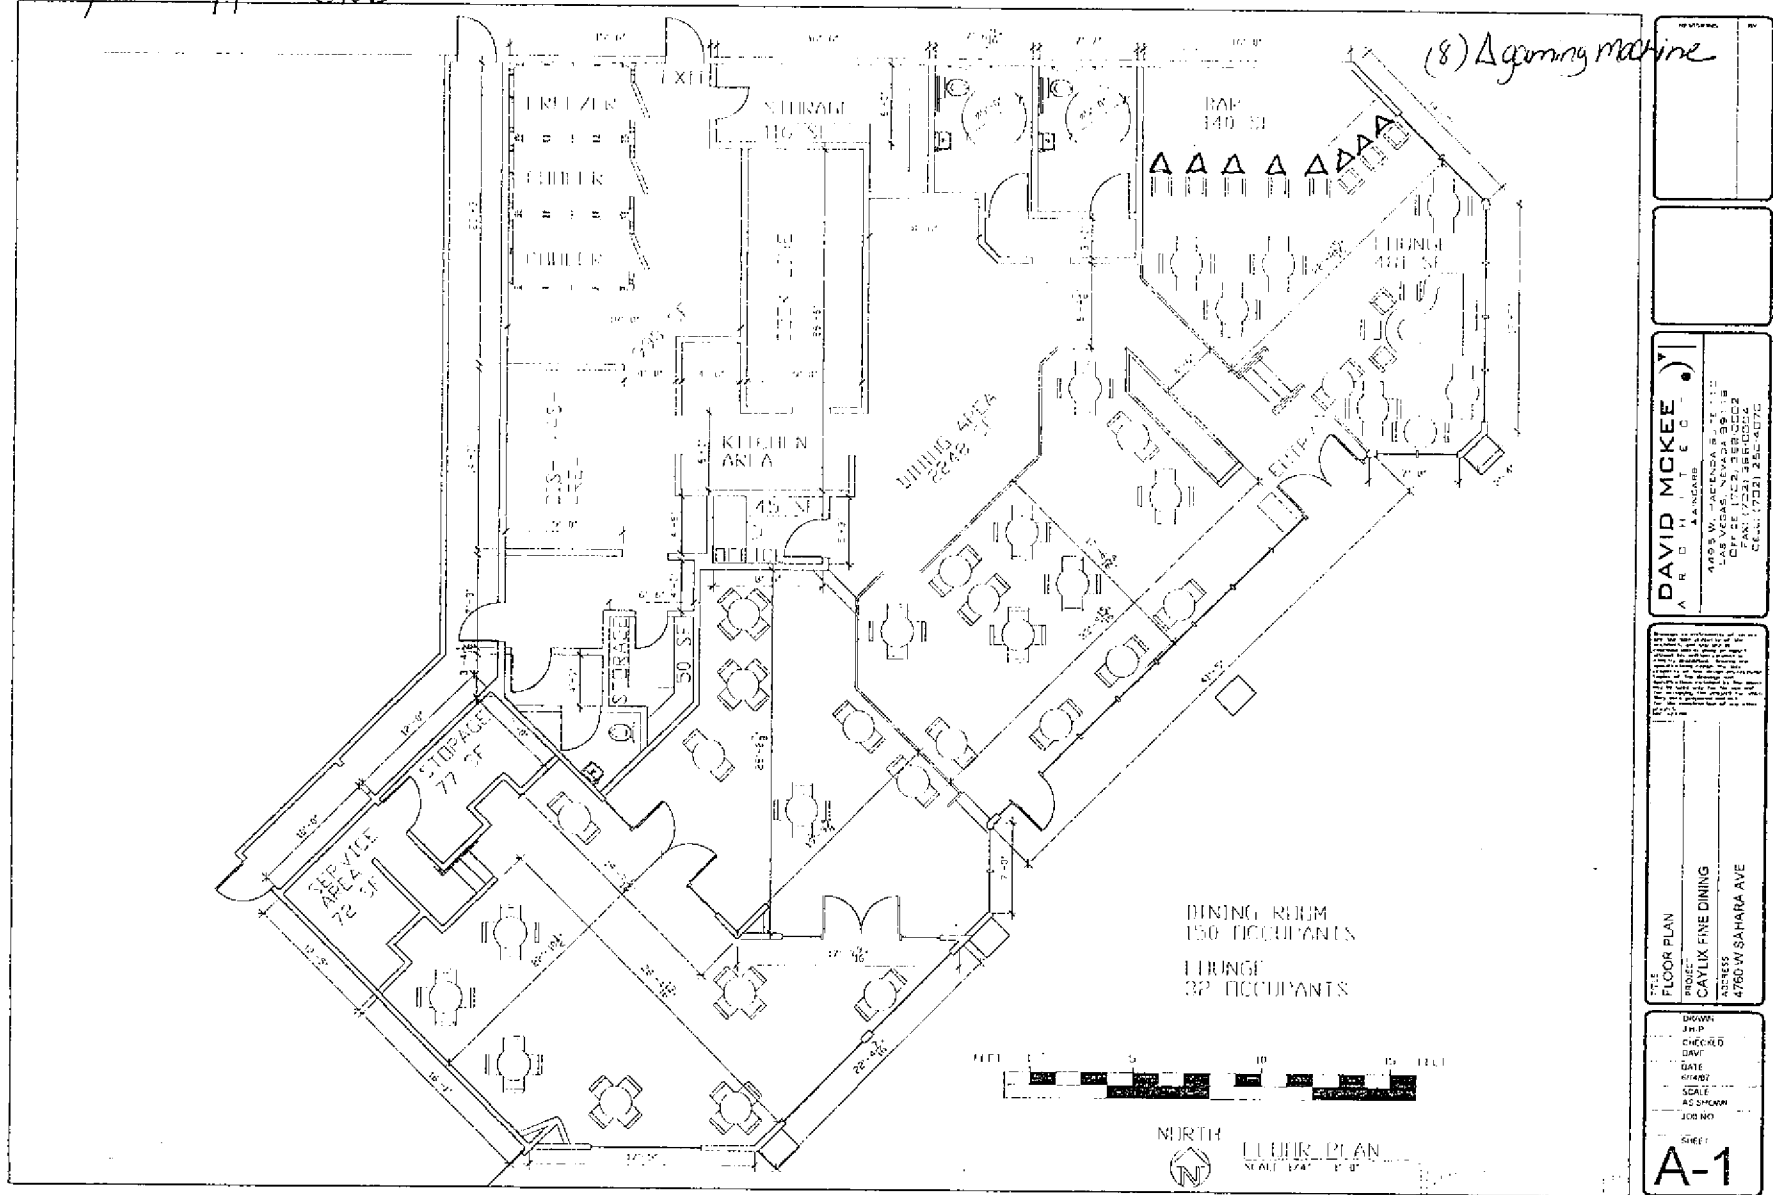

AUG 20 2007

SUP-23924
09/27/07 PC