



PLANNING & DEVELOPMENT DEPARTMENT

STATEMENT OF FINANCIAL INTEREST

Case Number: **RQR-23916** APN: 162-06-211-001
Name of Property Owner: Ernest Becker III MEB Family Trust
Name of Applicant: Lamar Outdoor Advertising

To the best of your knowledge, does the Mayor or any member of the City Council or Planning Commission have any financial interest in this or any other property with the property owner, applicant, the property owner or applicant's general or limited partners, or an officer of their corporation or limited liability company?

☒ Yes

☒ No

If yes, please indicate the member of the City Council or Planning Commission who is involved and list the name(s) of the person or persons with whom the City Official holds an interest. Also list the Assessor's Parcel Number if the property in which the interest is held is different from the case parcel.

City Official: _____

Partner(s): _____

APN _____

Signature of Property Owner: [Signature]

Print Name: Scott Nafziger

Subscribed and sworn before me


on behalf of owner

This 14 day of August, 20 07


[Signature]
Notary Public in and for said County and State

RECEIVED

AUG 14 2007

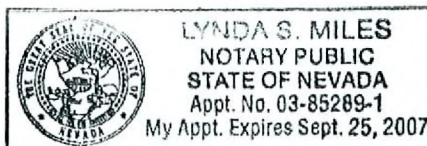

PELICAN COVE APARTMENTS

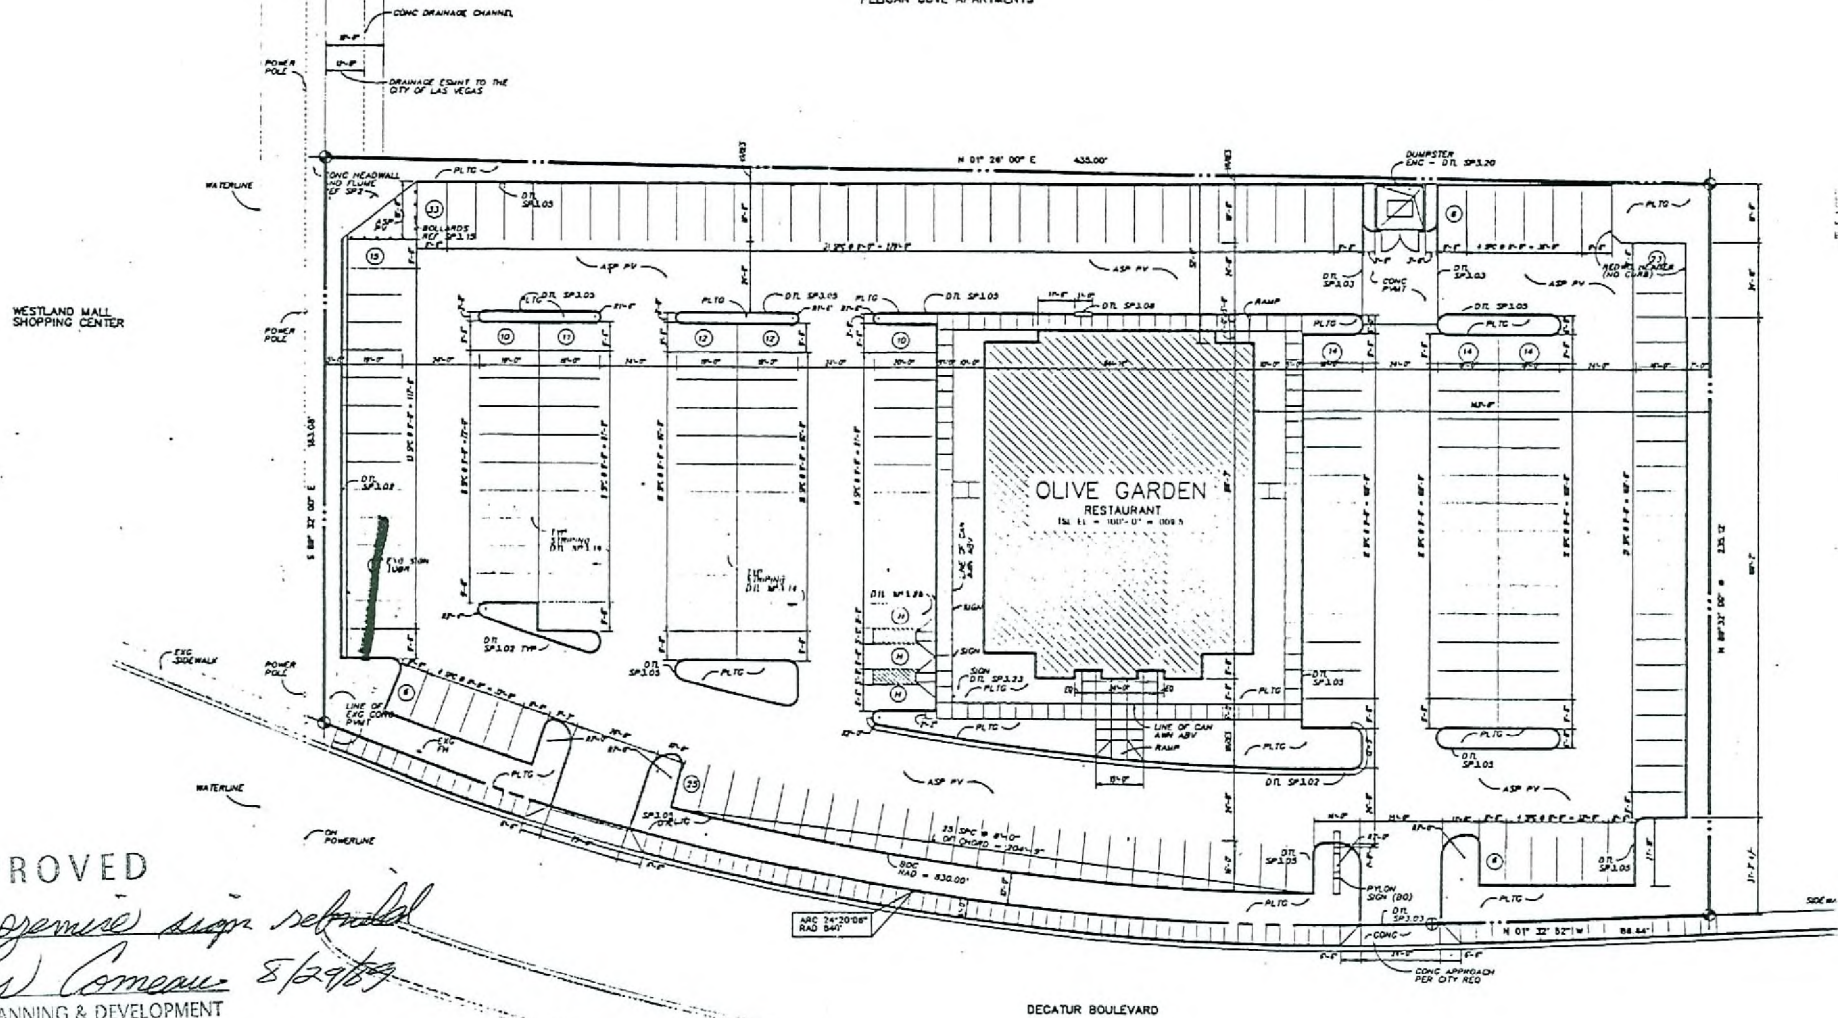

APPROVED

Off premise sign rebuild
 By: Les Comeau 8/29/07
 COMMUNITY PLANNING & DEVELOPMENT
 City of Las Vegas

RECEIVED

AUG 14 2007

RQR-23916
 09/27/07 PC