

To Whom It May Concern

The Purpose of This Request
is To Ask For A Variance For
A Detached Garage That Has Already
Been Constructed on my property.
I Take Full Responsibility For
Having Constructed This Garage
Without The Proper Permits


Respectfully


RECEIVED
MAY 23 2007

VAR-22167
07/12/07 PC

JUSTIFICATION LETTER
HEIGHT OF EXISTING RESIDENCE

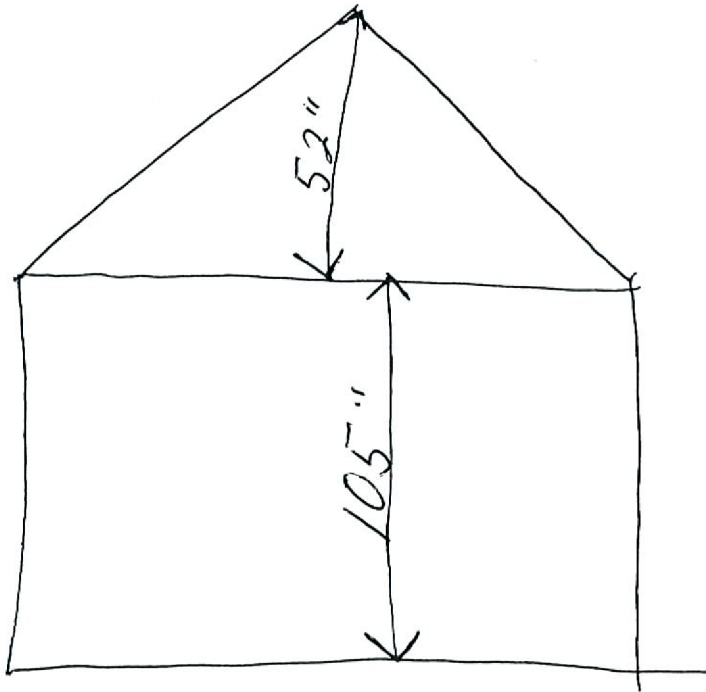

RECEIVED
MAY 23 2007

RECEIVED

VAR-22167
07/12/07 PC