



PLANNING & DEVELOPMENT DEPARTMENT

STATEMENT OF FINANCIAL INTEREST

Case Number: **SUP-23594** APN: 139-34-210-003

Name of Property Owner: GBSS Properties, LLC.

Name of Applicant: New Genesis

Name of Representative: Kelly Charles

To the best of your knowledge, does the Mayor or any member of the City Council or Planning Commission have any financial interest in this or any other property with the property owner, applicant, the property owner or applicant's general or limited partners, or an officer of their corporation or limited liability company?

☐ Yes

☒ No

If yes, please indicate the member of the City Council or Planning Commission who is involved and list the name(s) of the person or persons with whom the City Official holds an interest. Also list the Assessor's Parcel Number if the property in which the interest is held is different from the case parcel.

City Official: _____

Partner(s): _____

APN: _____


Signature of Property Owner: *Glenda Shaw* GBSS PROPERTIES LLC
Print Name: Glenda Shaw

Subscribed and sworn before me

This 30 day of July, 2007
Garnette Y. Klukoske
Notary Public in and for said County and State



BRIDGER AVE.

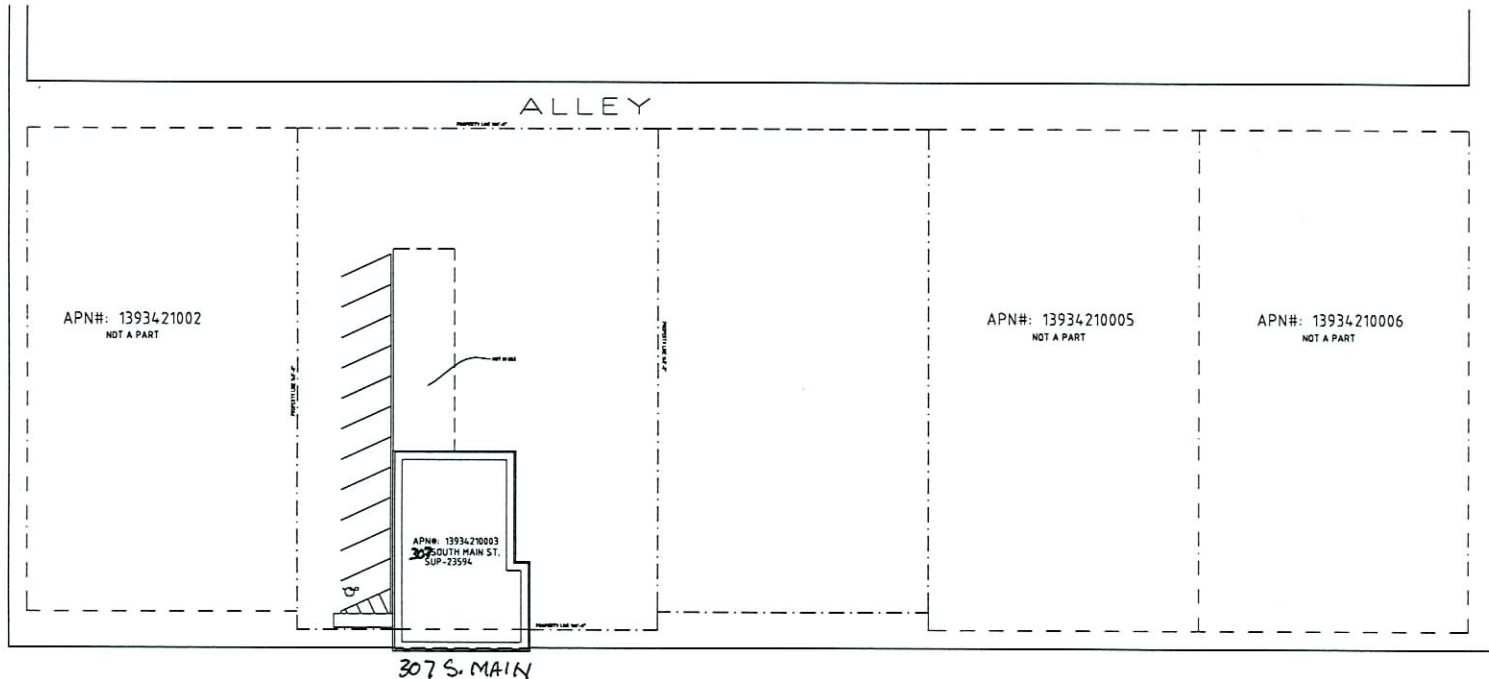

PARKING ANALYSIS	
SOCIAL SERVICE PROVIDER GROSS SQUARE FOOTAGE = 293	
TOTAL REQUIRED SPACES = 1	
TOTAL SPACES PROVIDED = 1	

RECEIVED
OCT 17 2007

AA SITE PLAN
1/10"




VICINITY MAP
NA




DRAWN BY : ALP		SITE PLAN SHEET	
DESIGNED BY :		SPECIAL USE PERMIT #23594	
CHECKED BY :		307 S. MAIN ST.	
DATE : 1.30.07		LAS VEGAS, NEVADA	
JOB NO :			
SCALE : 1/8" = 1'-0"			
SHEET			
AS1			


SUP-23594
11/29/07 PC

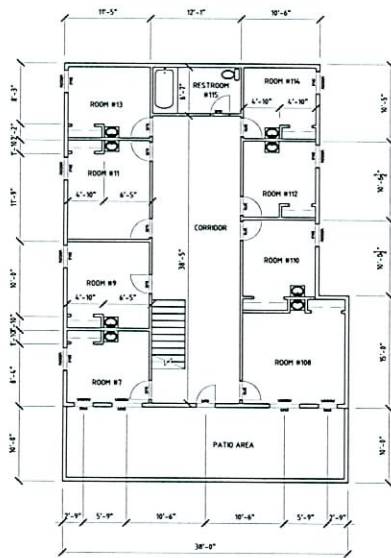

2 2ND FLOOR PLAN SHEET
1/8"

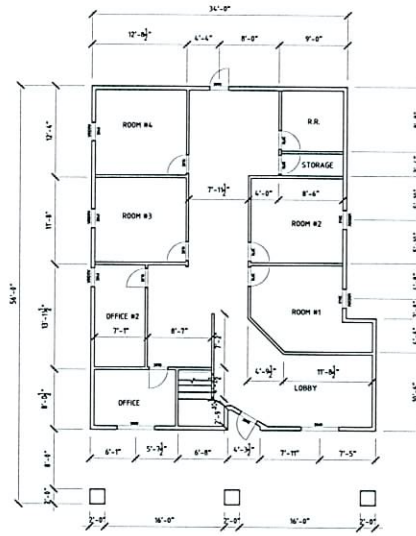

1 1ST FLOOR PLAN SHEET
1/8"

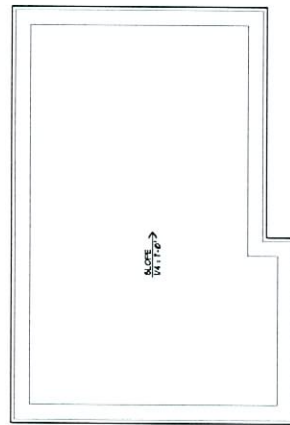

3 ROOF PLAN
1/8"



RECEIVED
AUG 16 2007

SUP-23594

DRAWN BY : A.L.V.		DESIGNED BY :		CHECKED BY :		DATE : 7/30/07		JOB No : 1/8" = 1'-0"		SCALE :	
307 S. MAINT ST. LAS VEGAS, NEVADA		1ST, 2ND & ROOF PLAN SHEET									
SHEET A1											
REV. DATE BY REVISION											