

**PLANNING & DEVELOPMENT DEPARTMENT****STATEMENT OF FINANCIAL INTEREST**Case Number: **SUP-25473** APN: **140-32-401-006**Name of Property Owner: **Metro Car Corporation**Name of Applicant: **Metro PCS**Name of Representative: **John Wright**

To the best of your knowledge, does the Mayor or any member of the City Council or Planning Commission have any financial interest in this or any other property with the property owner, applicant, the property owner or applicant's general or limited partners, or an officer of their corporation or limited liability company?


☐ Yes☒ No

If yes, please indicate the member of the City Council or Planning Commission who is involved and list the name(s) of the person or persons with whom the City Official holds an interest. Also list the Assessor's Parcel Number if the property in which the interest is held is different from the case parcel.

City Official: _____

Partner(s): _____

APN: _____

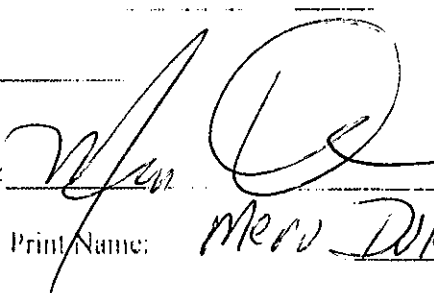
Signature of Property Owner: Print Name: **Merv DUKATI**

Subscribed and sworn before me

This **2nd** day of **November**, 20**07**

Notary Public in and for said County and State

Official Seal
Steven H. Dukat
Notary Public State of Illinois
My Commission Expires 05/16/2009

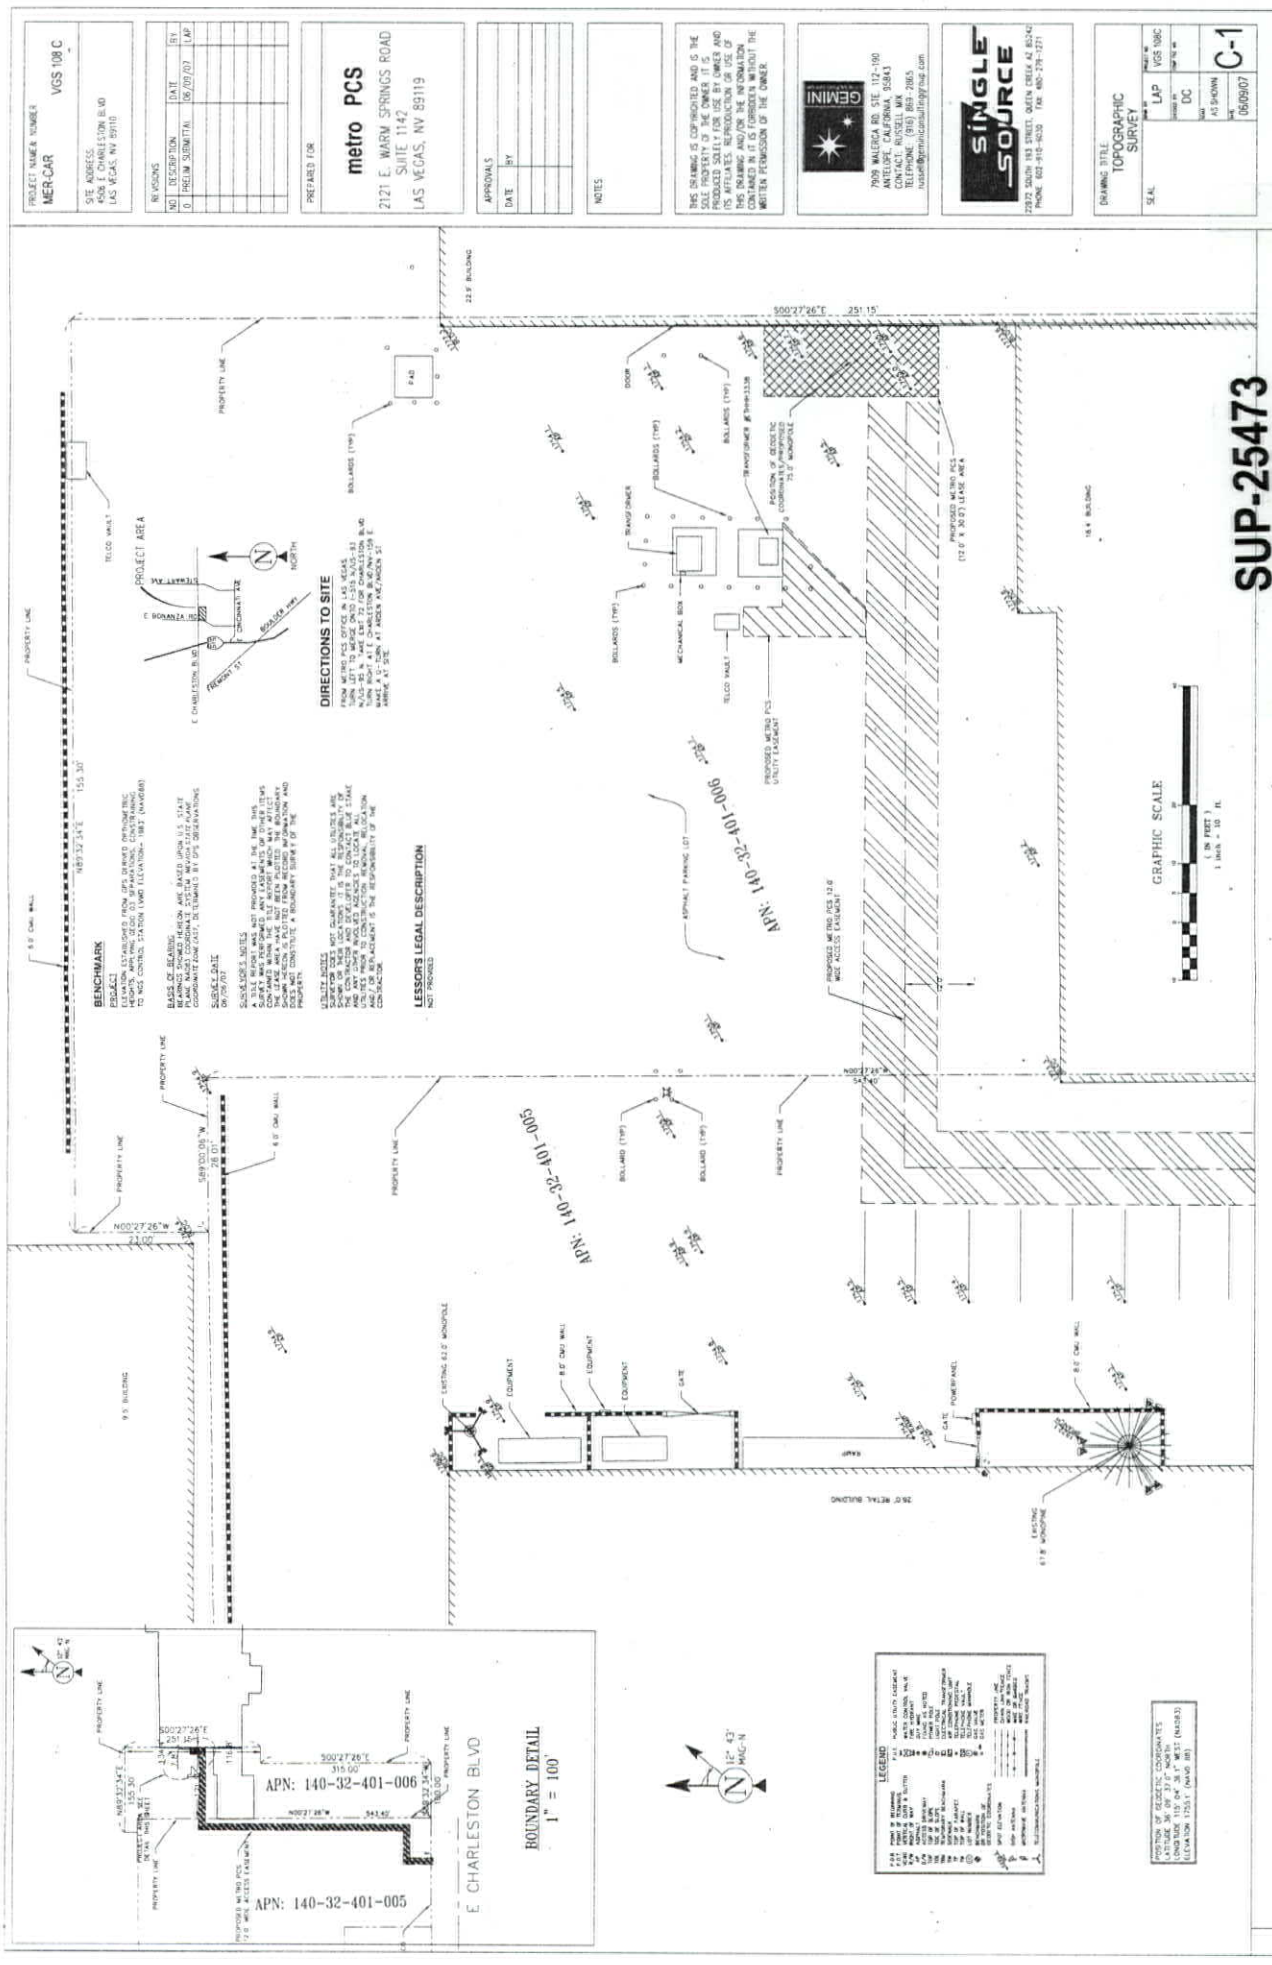

PROJECT NUMBER: VGS 108 C
MER-CAR
SITE ADDRESS:
4508 E CHARLESTON BLVD
LAS VEGAS, NV 89110

NO.	DESCRIPTION	DATE	BY

metro PCS
2121 E. WARM SPRINGS ROAD
SUITE 1142
LAS VEGAS, NV 89119

APPROVALS	DATE	BY

NOTES

THIS DRAWING IS COPYRIGHTED AND IS THE
SOLE PROPERTY OF THE OWNER. IT IS
TO BE USED ONLY FOR THE PROJECT AND
ITS AFFILIATES. REPRODUCTION OR USE OF
THIS DRAWING AND/OR THE INFORMATION
CONTAINED IN IT IS FORBIDDEN WITHOUT THE
WRITTEN PERMISSION OF THE OWNER.

GEMINI

SINGLE
SOURCE

DRAWING TITLE	
TOPOGRAPHIC SURVEY	
SEAL	LAP
VGS 108 C	DC
AS SHOWN	C-1
06/07/07	

RECEIVED
NOV 29 2007

SUP-25473
REVISED
12/20/07 PC













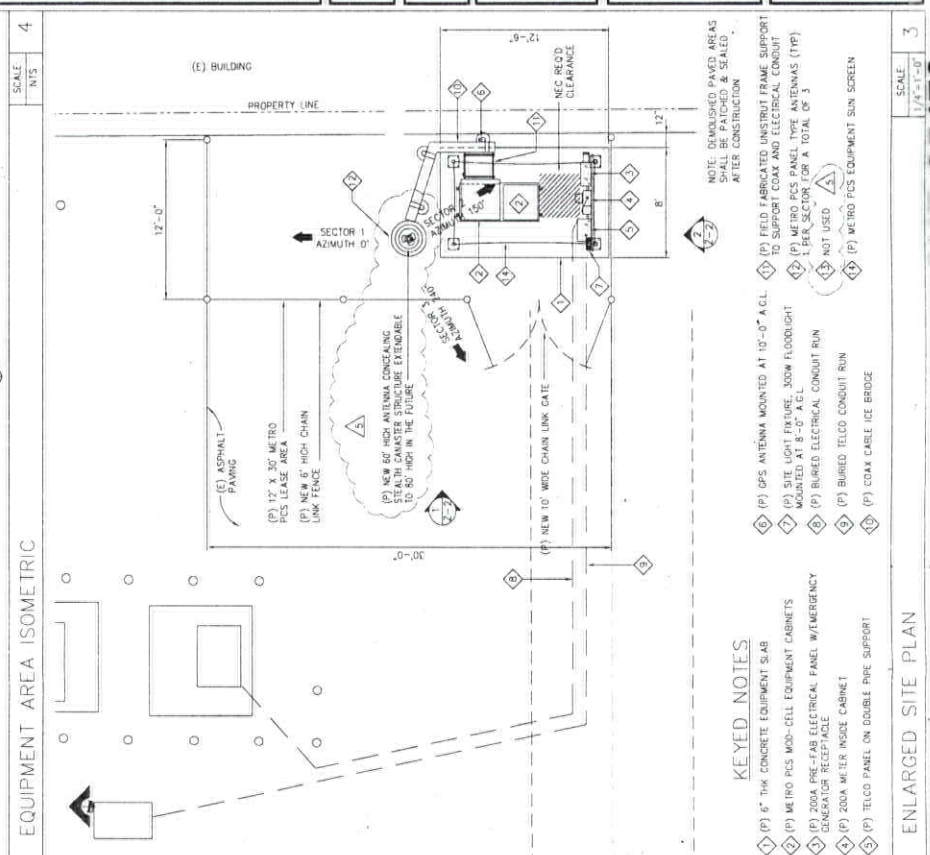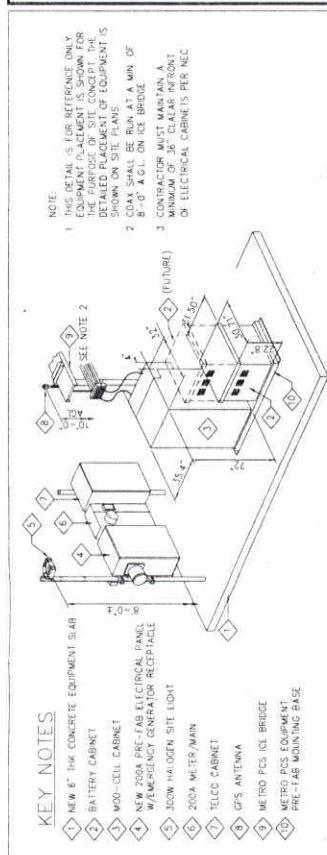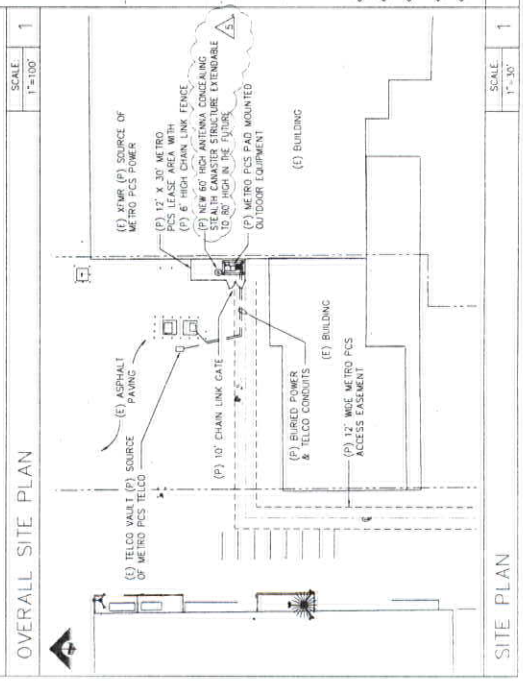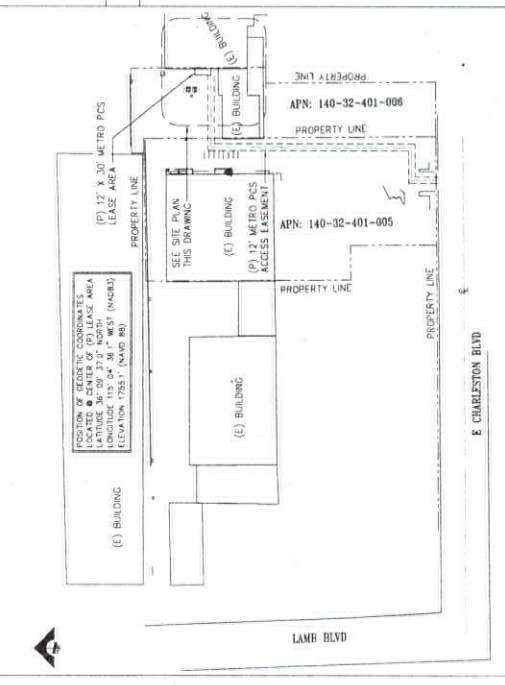

PROJECT NAME & NO.

MER-CAH

***VGS-108C**

REVISIONS

NO.	DESCRIPTION	DATE	BY
1	ZONING DOCS 902	07/01/07	MRF
2	ZONING DOCS 100A	07/01/07	MRF
3	CHANGED HEIGHT	08/01/07	MRF
4	ROTATED EQUIP	08/01/07	MRF
5	ZONING REVISIONS	11/20/07	MRF

PREPARED FOR:

metro PCS

2121 E. WILSON SPRINGS RD
LAS VEGAS, NEVADA 89119

APPROVALS

DATE	BY

SINGLE SOURCE

22975 SOUTH 103 STREET, GREEN CREEK AT 8543
PHONE: 602-410-1020 FAX: 480-279-1271

A/E Services

ARCHITECTURAL & ENGINEERING

1539 E. BREEZY DR
PHOENIX, AZ 85096
PHONE: (602) 234-7746
FAX: (602) 485-5503

ZONING SITE PLANS

NO.	DESCRIPTION	DATE	BY
1	ZONING DOCS 902	07/01/07	MRF
2	ZONING DOCS 100A	07/01/07	MRF
3	CHANGED HEIGHT	08/01/07	MRF
4	ROTATED EQUIP	08/01/07	MRF
5	ZONING REVISIONS	11/20/07	MRF

RECEIVED

NOV 29 2007

SUP-25473

REVISED

12/20/07 PC

[illegible]

SITE ELEVATION (LOOKING EAST)

SITE ELEVATION (LOOKING NORTH)

ANTENNA DETAILS