



**PLANNING & DEVELOPMENT DEPARTMENT**

RECEIVED  
DEC 28 2007

**STATEMENT OF FINANCIAL INTEREST**

Case Number: VAR-26243 APN: 139-32-601-023

Name of Property Owner: Allen Teles Revocable Trust

Name of Applicant: Joseph Miller (trustee)

Name of Representative: \_\_\_\_\_

To the best of your knowledge, does the Mayor or any member of the City Council or Planning Commission have any financial interest in this or any other property with the property owner, applicant, the property owner or applicant's general or limited partners, or an officer of their corporation or limited liability company?

\_\_\_\_\_ Yes  No

If yes, please indicate the member of the City Council or Planning Commission who is involved and list the name(s) of the person or persons with whom the City Official holds an interest. Also list the Assessor's Parcel Number if the property in which the interest is held is different from the case parcel.

City Official: \_\_\_\_\_

Partner(s): \_\_\_\_\_

APN: \_\_\_\_\_


Signature of Property Owner: J. T. Miller III

Print Name: J. T. Miller III


Subscribed and sworn before me

This 28<sup>th</sup> day of December, 2007


Lindsay Sharbono  
Notary Public in and for said County and State

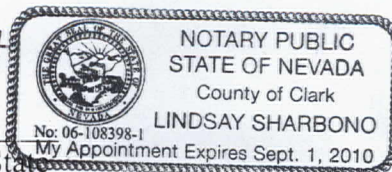

1500 RANCHO CIRCLE  
 PARCEL # 139 32 601 023  
 SITE PLAN

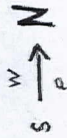


RECEIVED  
 DEC 28 2007

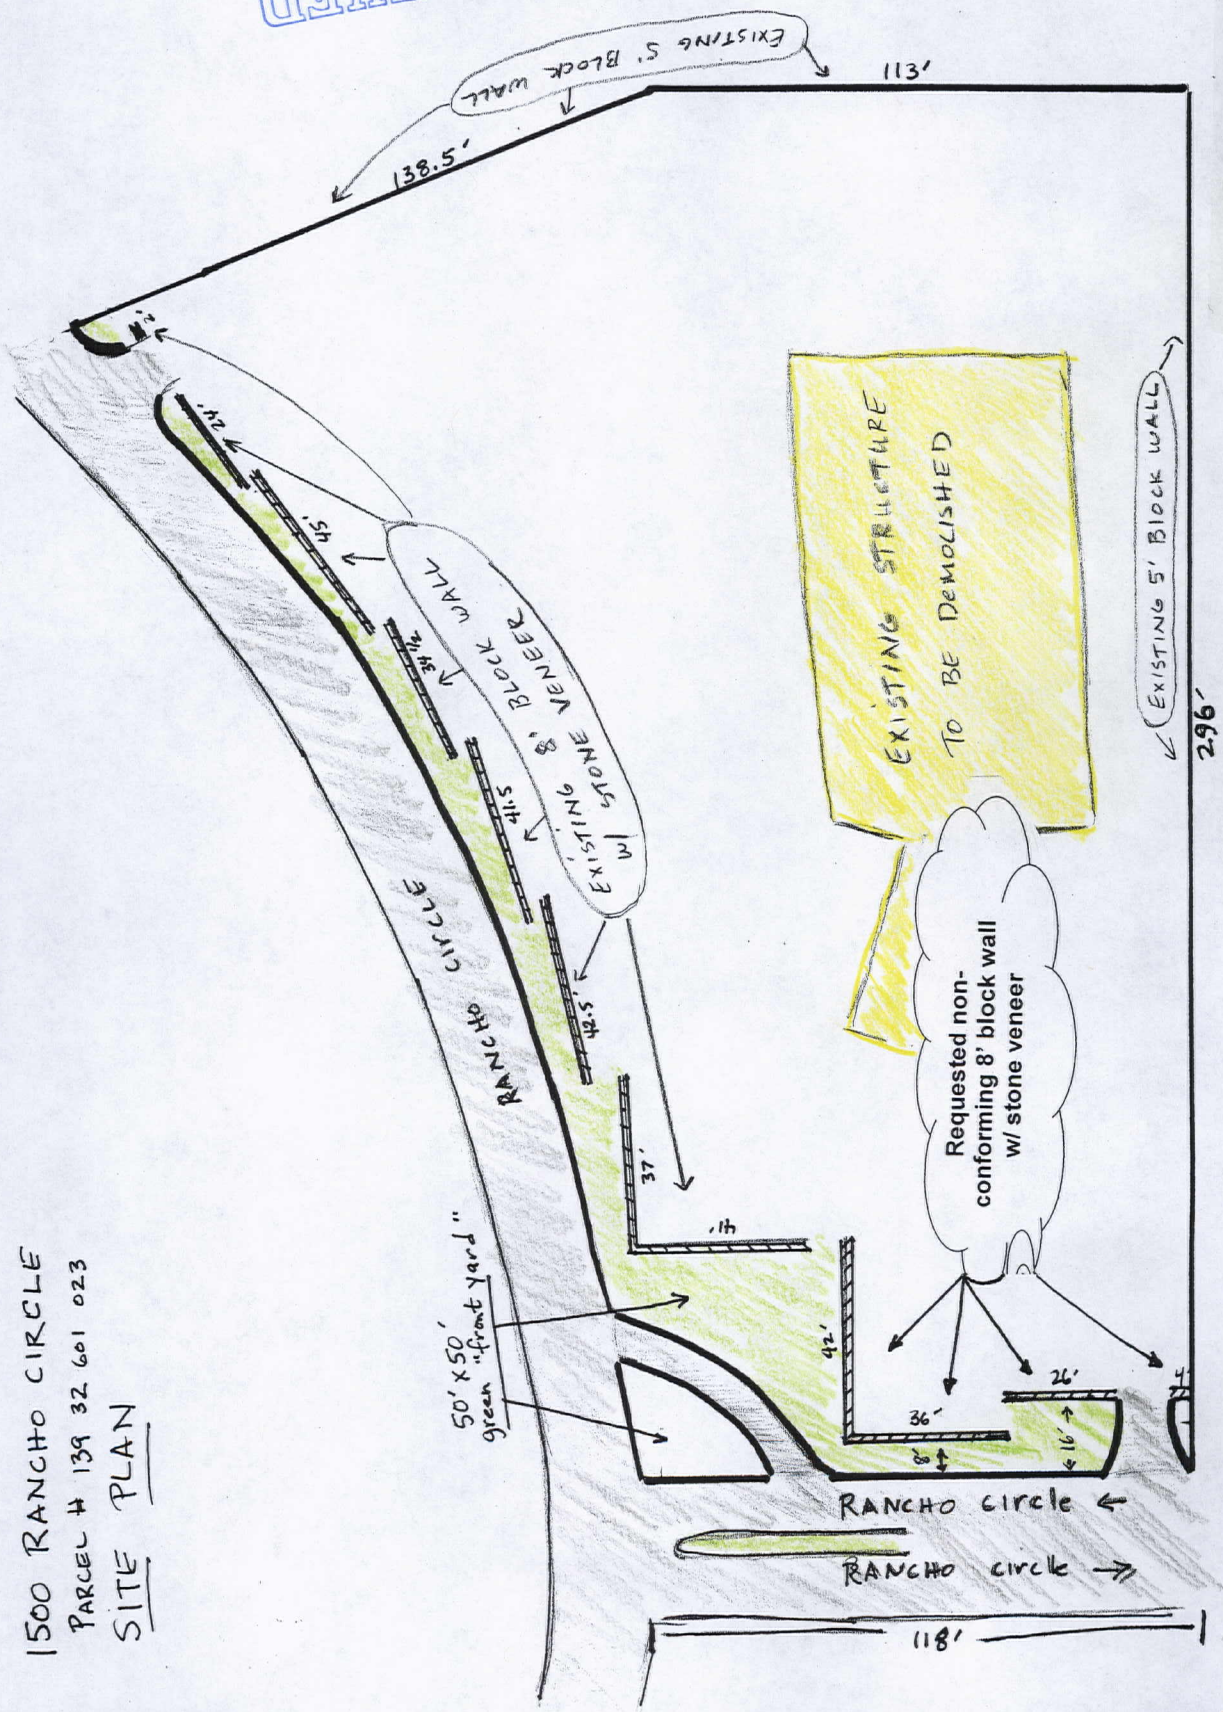


VAR-26243  
 02/14/08 PC

Block Wall Elevation  
1500 Rancho Circle  
Parcel # 139 32 601 023

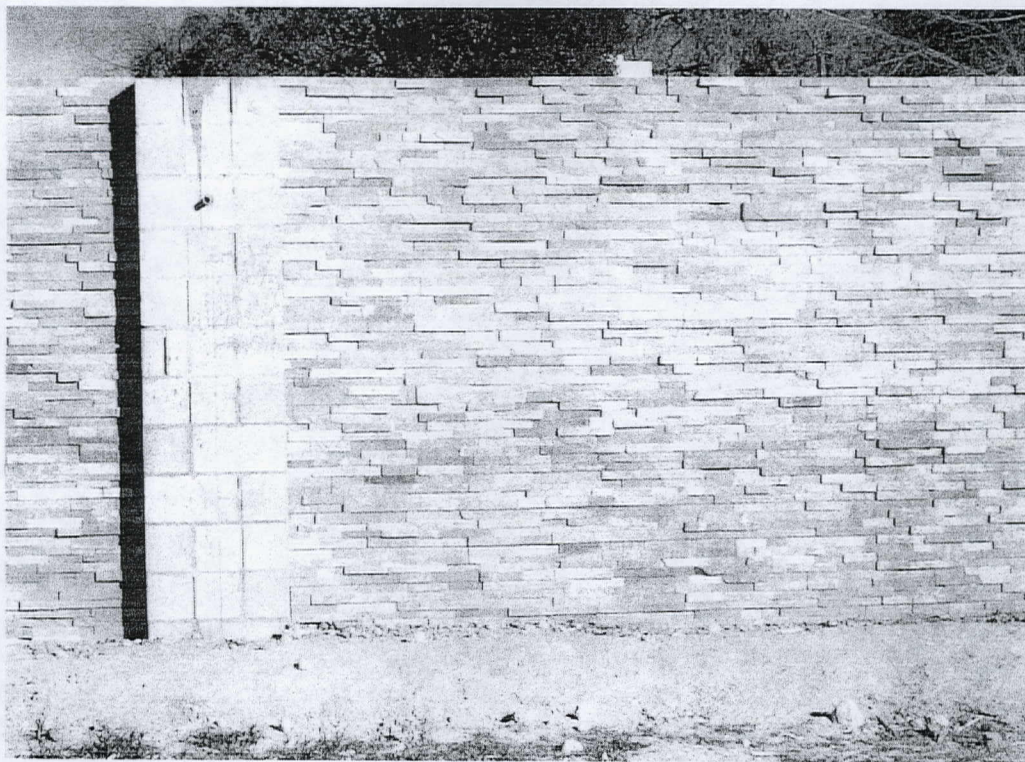

8'  
MAS.  
CONST.

Requested wall: - identical to existing wall (see site plan)  
- 8' tall - block construction (to city code)  
- stone veneer  
- set back from front property line 8' + 16' with vertical spacing as seen below.

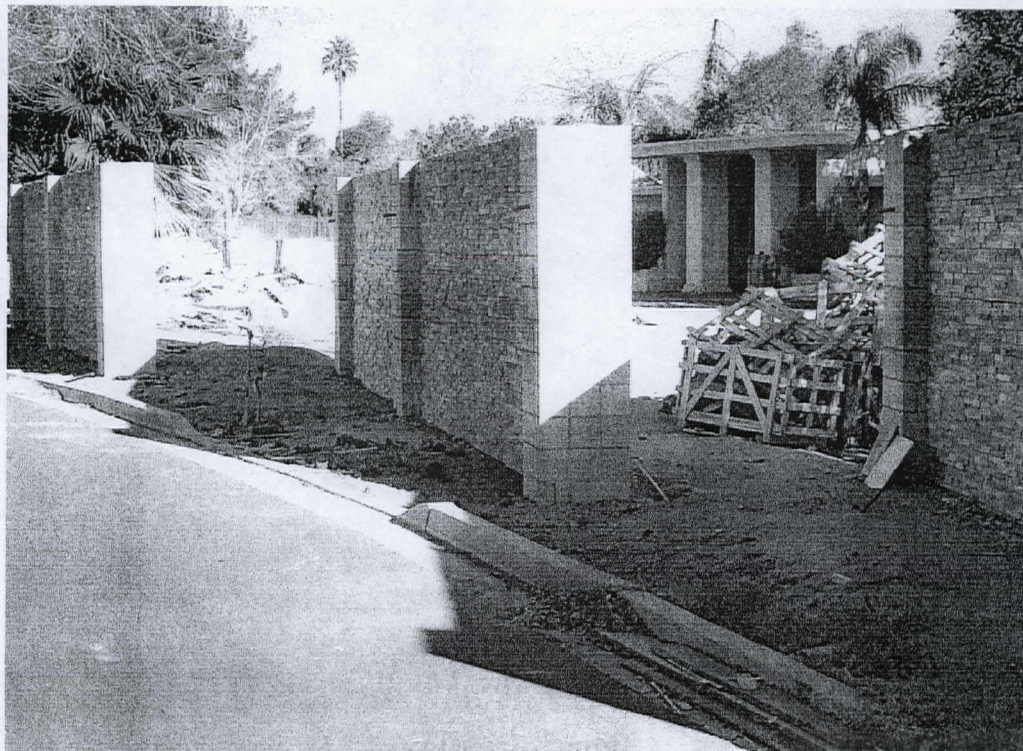

View of existing 8' block wall w/ stone veneer running down side of property (see site plan)

RECEIVED  
DEC 28 2007

VAR-26243  
02/14/08 PC