



PLANNING & DEVELOPMENT DEPARTMENT

STATEMENT OF FINANCIAL INTEREST

Case Number: EOT-26119 APN: 138-16-717-002

Name of Property Owner: WFTNV LLC

Name of Applicant: Lakeside Center

Name of Representative: The Skancke Company

To the best of your knowledge, does the Mayor or any member of the City Council or Planning Commission have any financial interest in this or any other property with the property owner, applicant, the property owner or applicant's general or limited partners, or an officer of their corporation or limited liability company?

Yes

No

If yes, please indicate the member of the City Council or Planning Commission who is involved and list the name(s) of the person or persons with whom the City Official holds an interest. Also list the Assessor's Parcel Number if the property in which the interest is held is different from the case parcel.

City Official: _____

Partner(s): _____

APN: _____

Signature of Property Owner: _____

Print Name: ERIK WATTS

Subscribed and sworn before me

This 17th day of Dec., 2007

Margaret Bruhns
Notary Public in and for said County and State



02-06-08 CC

LOT-26119



DEC 19 2007

RECEIVED

A11



EXISTING-BUILDING APPROVAL PLAN
SCALE 1/8" = 1'-0"

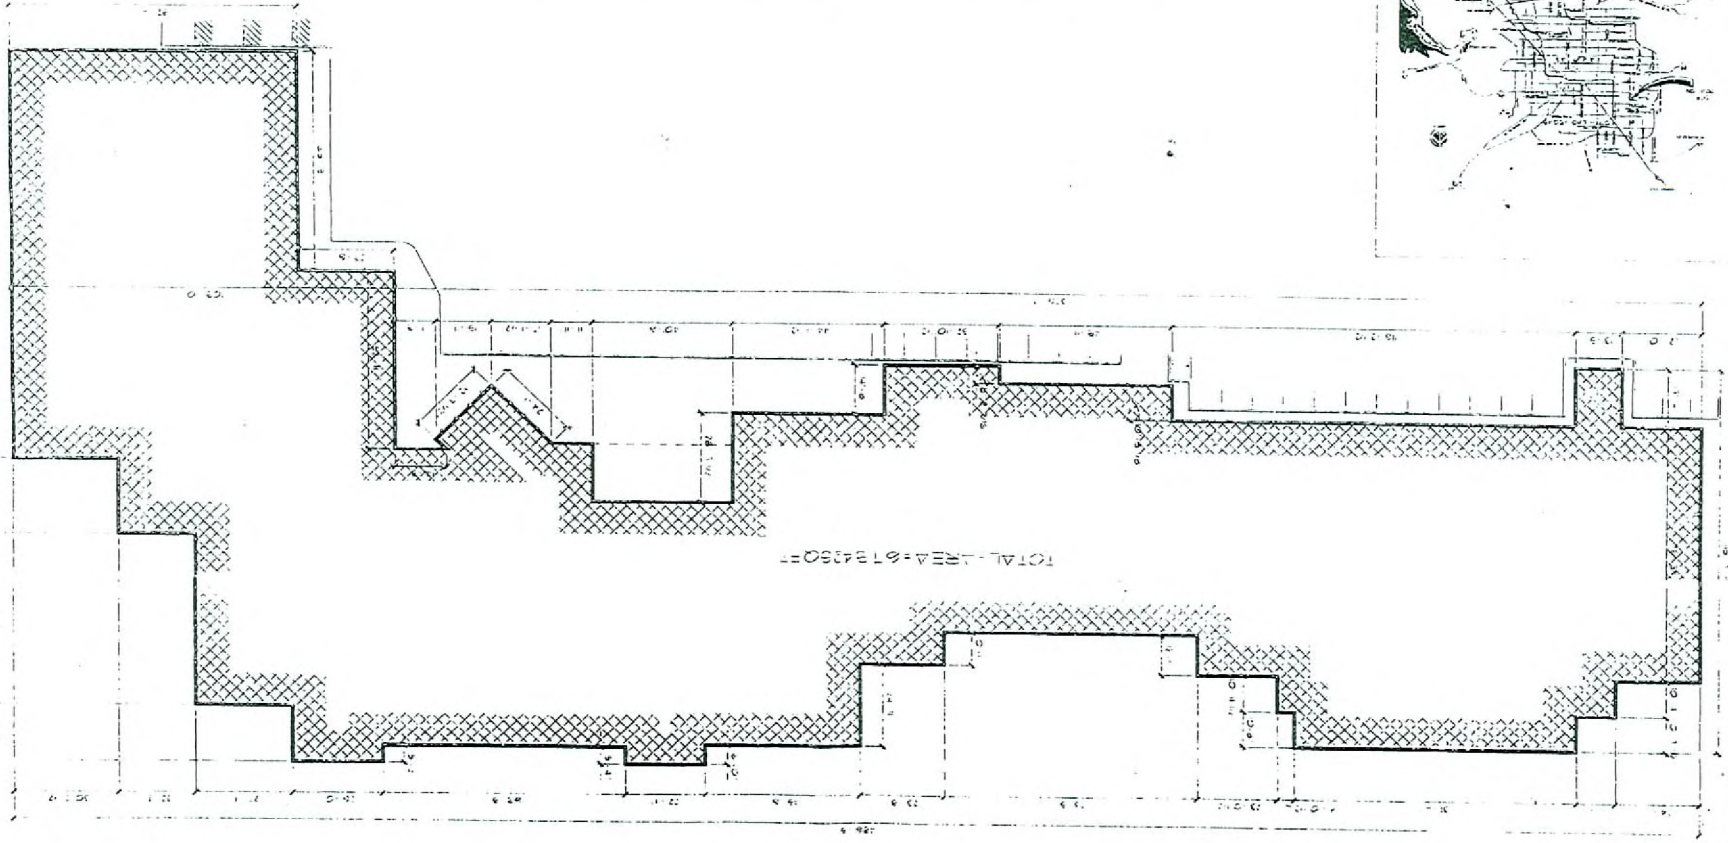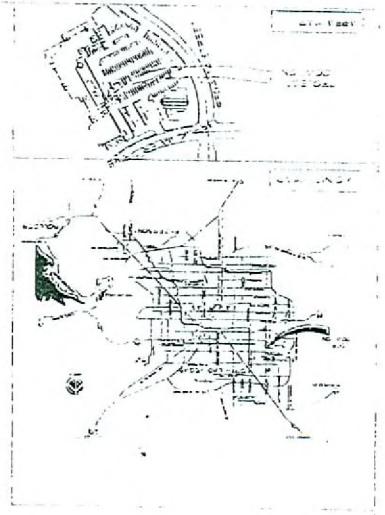

RECORD & REPAIR WORK
REVISIONS SHEET

1/8"