



PLANNING & DEVELOPMENT DEPARTMENT

STATEMENT OF FINANCIAL INTEREST

Case Number: VAC-25666 APN: 126-25-101-001, 002 & 005

Name of Property Owner: Fairfield Centennial L.L.C

Name of Applicant: FF Development L.P

Name of Representative: Shon Finch

To the best of your knowledge, does the Mayor or any member of the City Council or Planning Commission have any financial interest in this or any other property with the property owner, applicant, the property owner or applicant's general or limited partners, or an officer of their corporation or limited liability company?

☐ Yes

☒ No

If yes, please indicate the member of the City Council or Planning Commission who is involved and list the name(s) of the person or persons with whom the City Official holds an interest. Also list the Assessor's Parcel Number if the property in which the interest is held is different from the case parcel.

City Official: N/A

Partner(s): N/A

APN: N/A

Signature of Property Owner: [Signature]

Print Name: Jay S. Walker

Authorized Agent

Subscribed and sworn before me

This day of , 20

See attached

Notary Public in and for said County and State

RECEIVED

NOV 19 2007

CALIFORNIA JURAT WITH AFFIANT STATEMENT


STATE OF CALIFORNIA

COUNTY OF SAN DIEGO


Subscribed and sworn to (or affirmed) before me on this 7th day of
November, 2007 by Jay S. Walker personally known to me.

Name of signer(s)

WITNESS my hand and official seal.

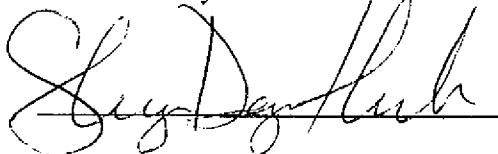

SIGNATURE OF NOTARY

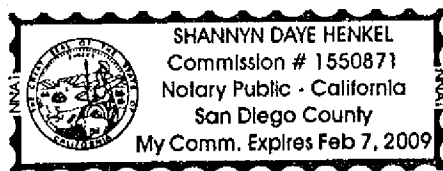

-OPTIONAL SECTION- CAPACITY CLAIMED BY SIGNER

Though statute does not require the Notary to fill in
the date below, doing so may prove invaluable to
persons relying on the document.

☐ INDIVIDUAL

☐ CORPORATE OFFICER(S)

TITLE(s)

☐ PARTNERS(S)

☐ LIMITED

☐ GENERAL

☐ ATTORNEY-IN-FACT

☐ TRUSTEE(S)

☐ GUARDIAN/CONSERVATOR

☐ OTHER:

SIGNER IS

REPRESENTING

NAME OF PERSON(S) OR ENTITY(IES)

OPTIONAL SECTION

THIS CERTIFICATE MUST BE ATTACHED TO THE
DOCUMENT DESCRIBED AT RIGHT:

Title or Type of Document:

Though the data requested here is not required by law, it could prevent
fraudulent reattachment of this form


Number of Pages:

Date of Document:

Signer(s) Other Than Named Above

RECEIVED

NOV 19 2007

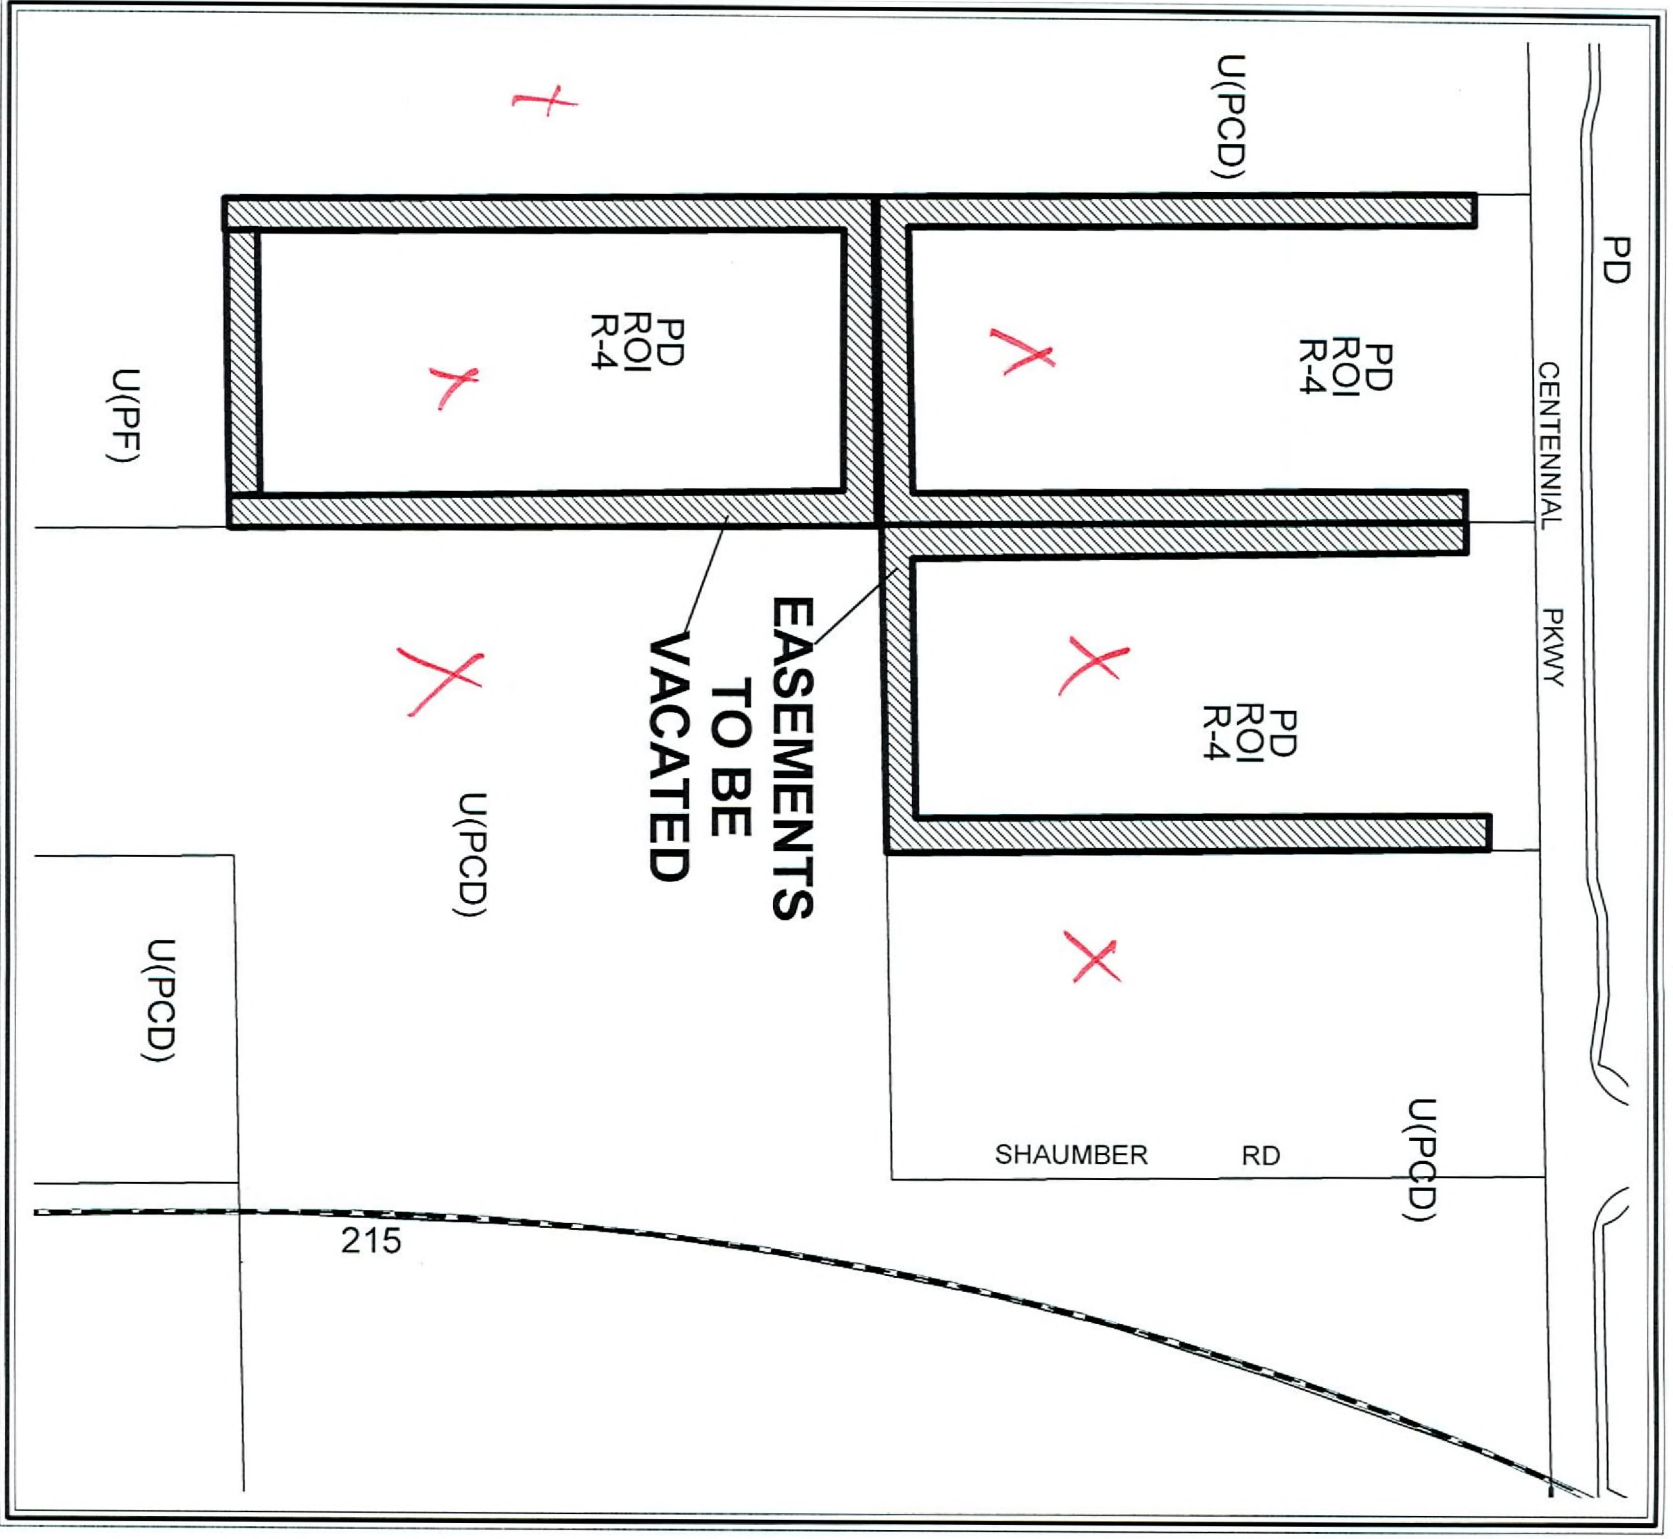

CASE: VAC-25666