



PLANNING & DEVELOPMENT DEPARTMENT

STATEMENT OF FINANCIAL INTEREST

Case Number: **VAR-24820** APN: 139-35-510-080

Name of Property Owner: Gil Martinez

Name of Applicant: Gil Martinez

Name of Representative: _____

To the best of your knowledge, does the Mayor or any member of the City Council or Planning Commission have any financial interest in this or any other property with the property owner, applicant, the property owner or applicant's general or limited partners, or an officer of their corporation or limited liability company?

☐ Yes

☒ No

If yes, please indicate the member of the City Council or Planning Commission who is involved and list the name(s) of the person or persons with whom the City Official holds an interest. Also list the Assessor's Parcel Number if the property in which the interest is held is different from the case parcel.

City Official: _____

Partner(s): _____


APN: _____

Signature of Property Owner: 

Print Name: Gil P. Martinez



Subscribed and sworn before me

This 20th day of August, 20 07

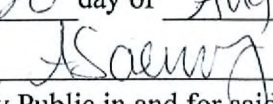
Notary Public in and for said County and State



CAR PORT

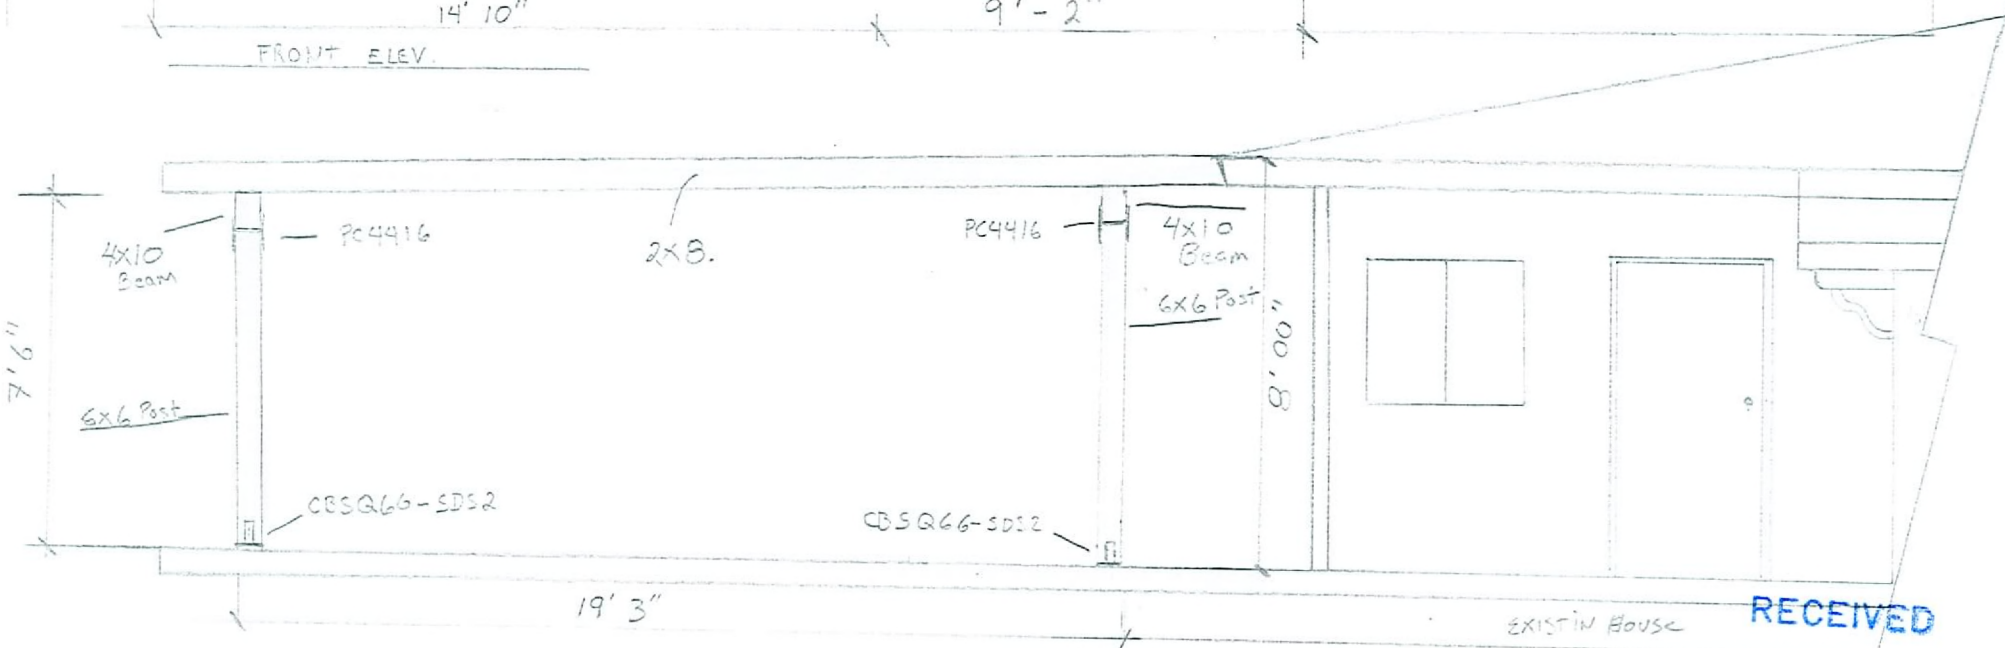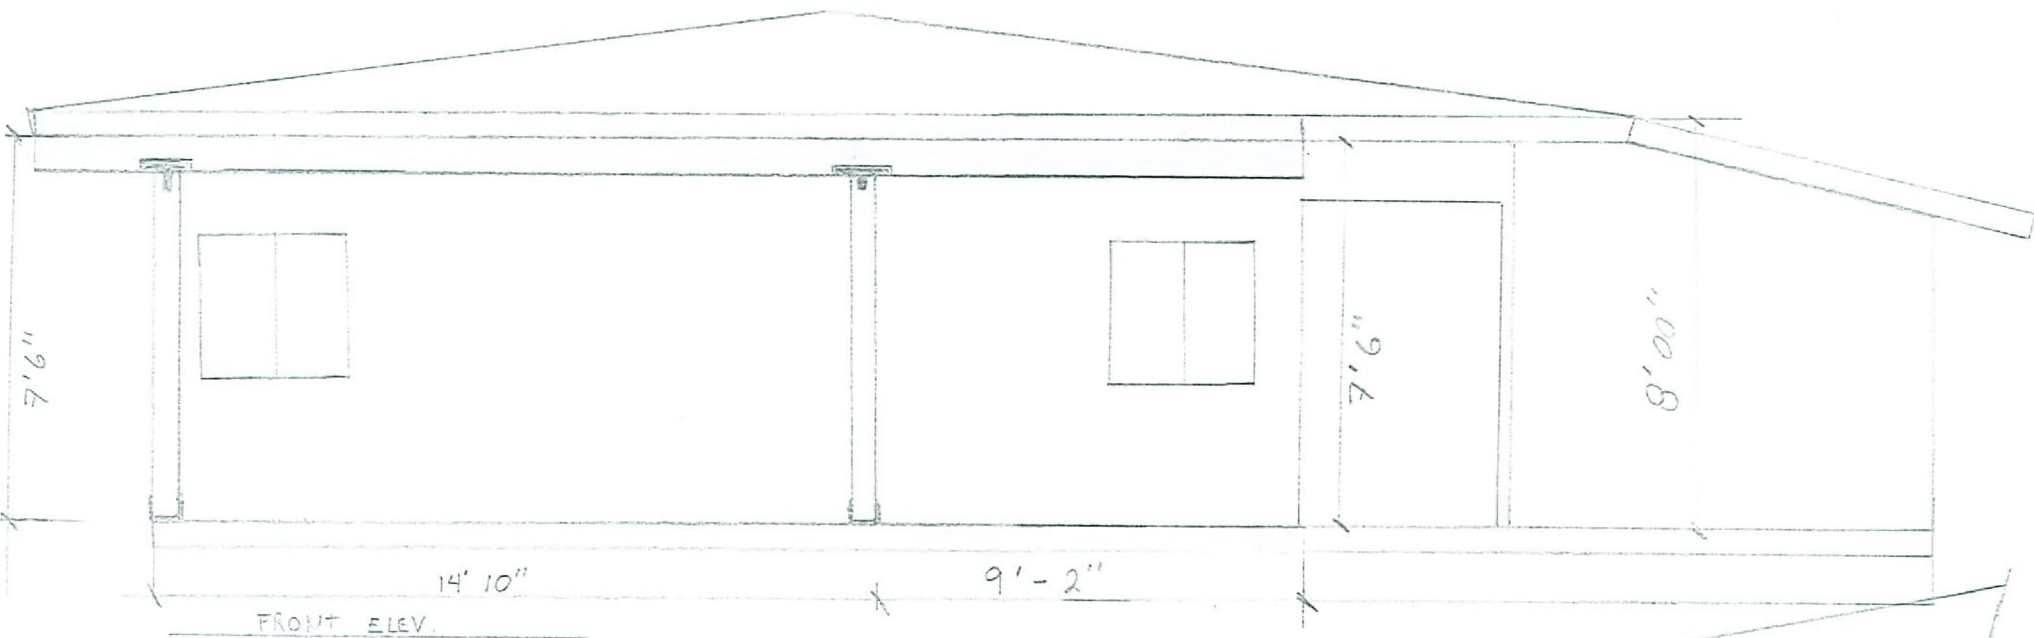


New Garage Port.


R. Elev Side

RECEIVED

VAR-24820 SEP 26 2007
11/29/07 PC

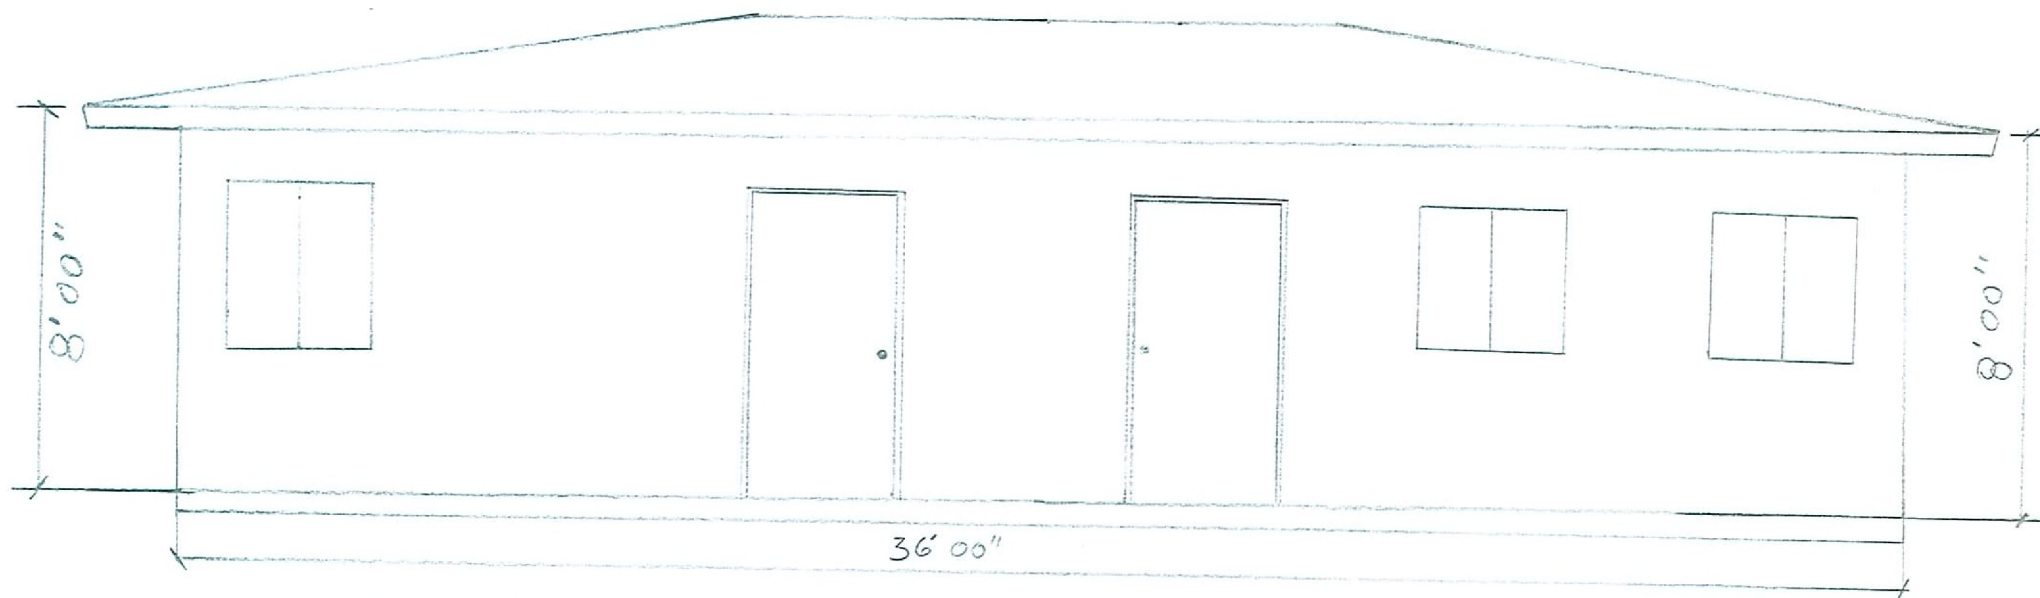

L. ELEV. SIDE. $\frac{1}{4}'' = 1'$

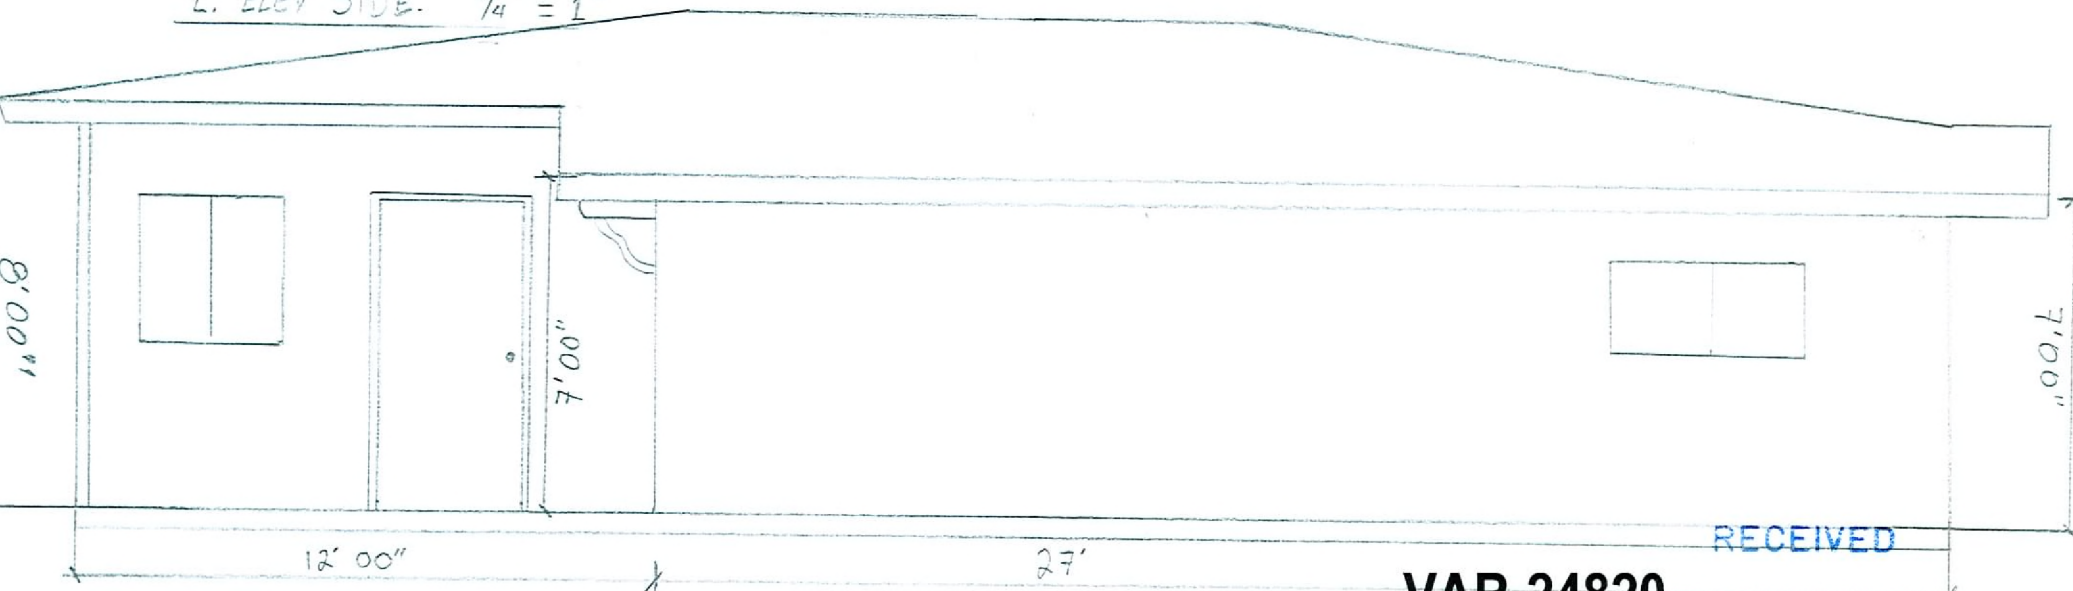


R. ELEV. SIDE $\frac{1}{4}'' = 1'$

RECEIVED

VAR-24820
11/29/07 PC

SEP 26 2007

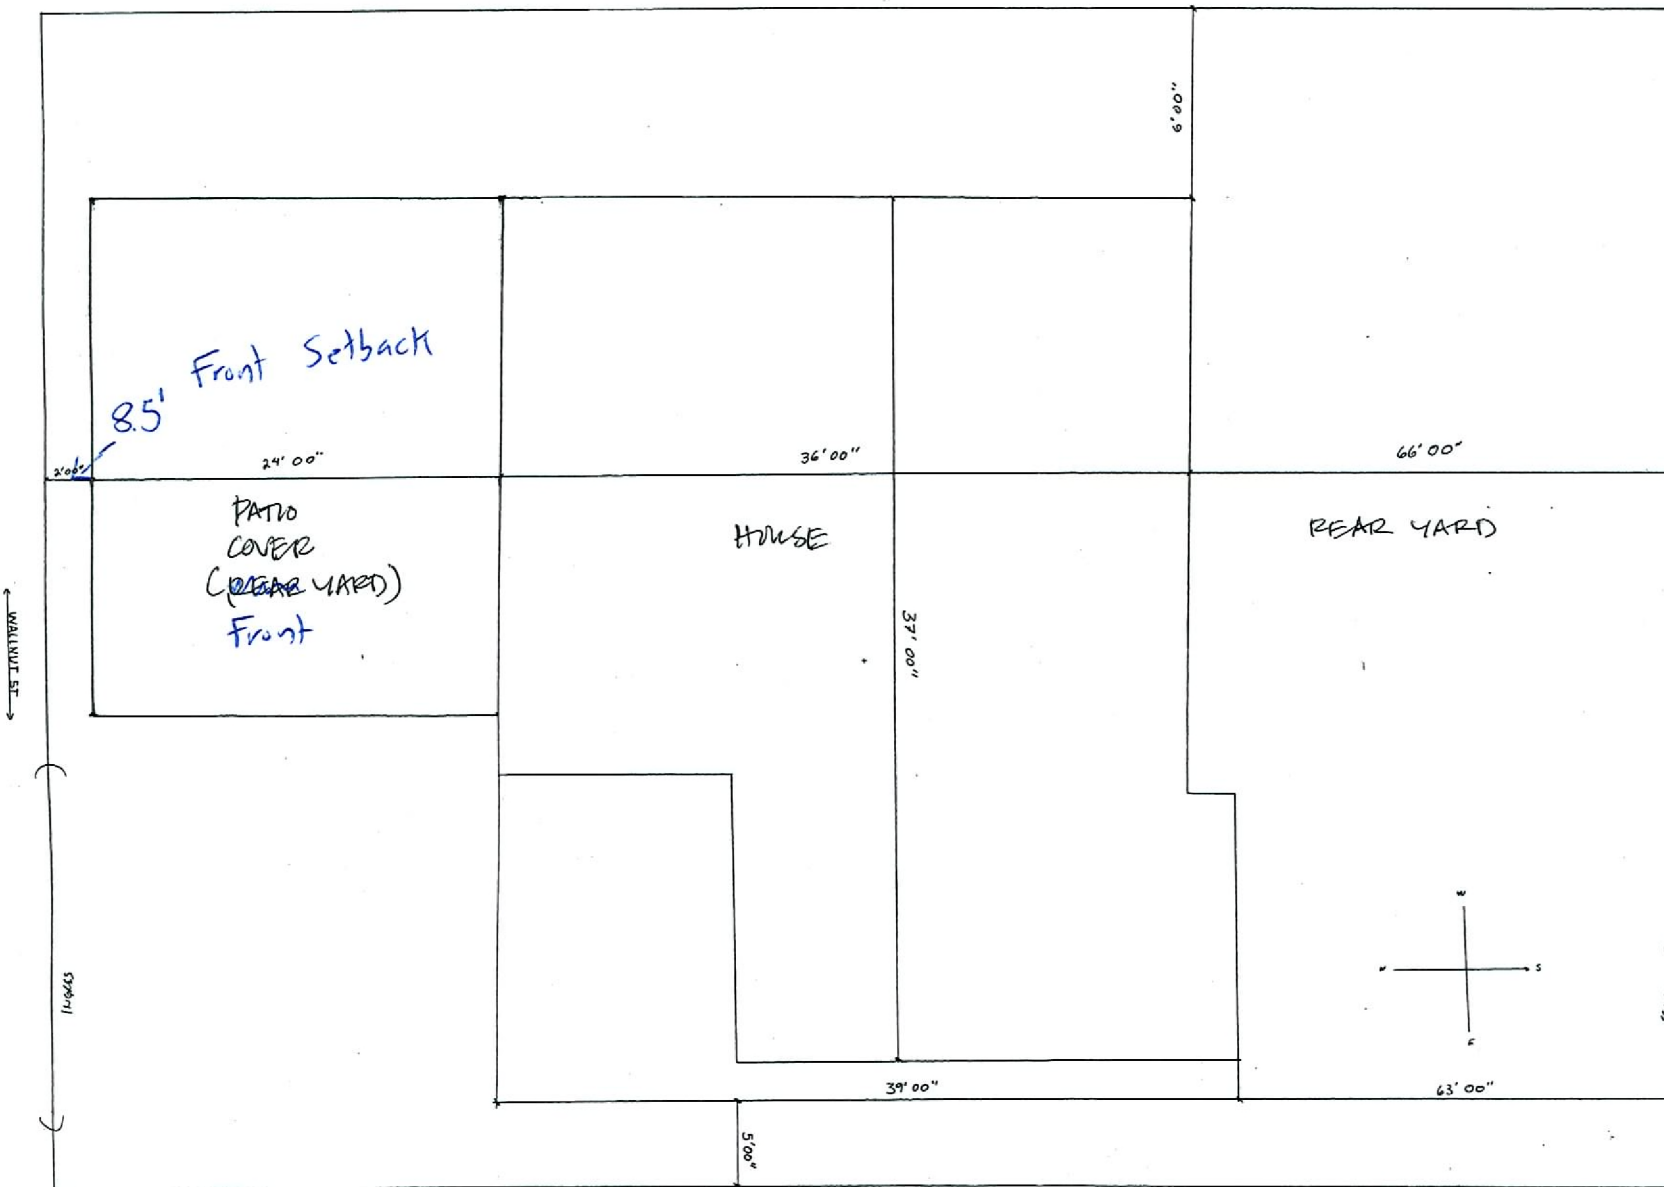

SITE PLAN

RECEIVED

SEP 26 2007

VAR-24820
11/29/07 PC