



## PLANNING & DEVELOPMENT DEPARTMENT

### STATEMENT OF FINANCIAL INTEREST

Case Number: **MSH-25695** APN: Please see attached

Name of Property Owner: Kyle Aquisition Group, LLC.

Name of Applicant: Kyle Aquisition Group, LLC.

Name of Representative: G.C. Wallace, Inc.

To the best of your knowledge, does the Mayor or any member of the City Council or Planning Commission have any financial interest in this or any other property with the property owner, applicant, the property owner or applicant's general or limited partners, or an officer of their corporation or limited liability company?

Yes

No

If yes, please indicate the member of the City Council or Planning Commission who is involved and list the name(s) of the person or persons with whom the City Official holds an interest. Also list the Assessor's Parcel Number if the property in which the interest is held is different from the case parcel.

City Official: \_\_\_\_\_

Partner(s): \_\_\_\_\_


APN: \_\_\_\_\_

Signature of Property Owner: \_\_\_\_\_

Print Name: Thomas J DeVore, Manager

Subscribed and sworn before me

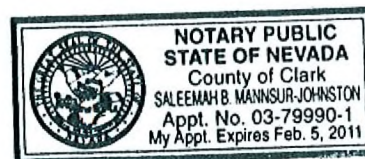


This 19<sup>th</sup> day of November, 2007  
Saleemah B. Mannsur-Johnston  
Notary Public in and for said County and State








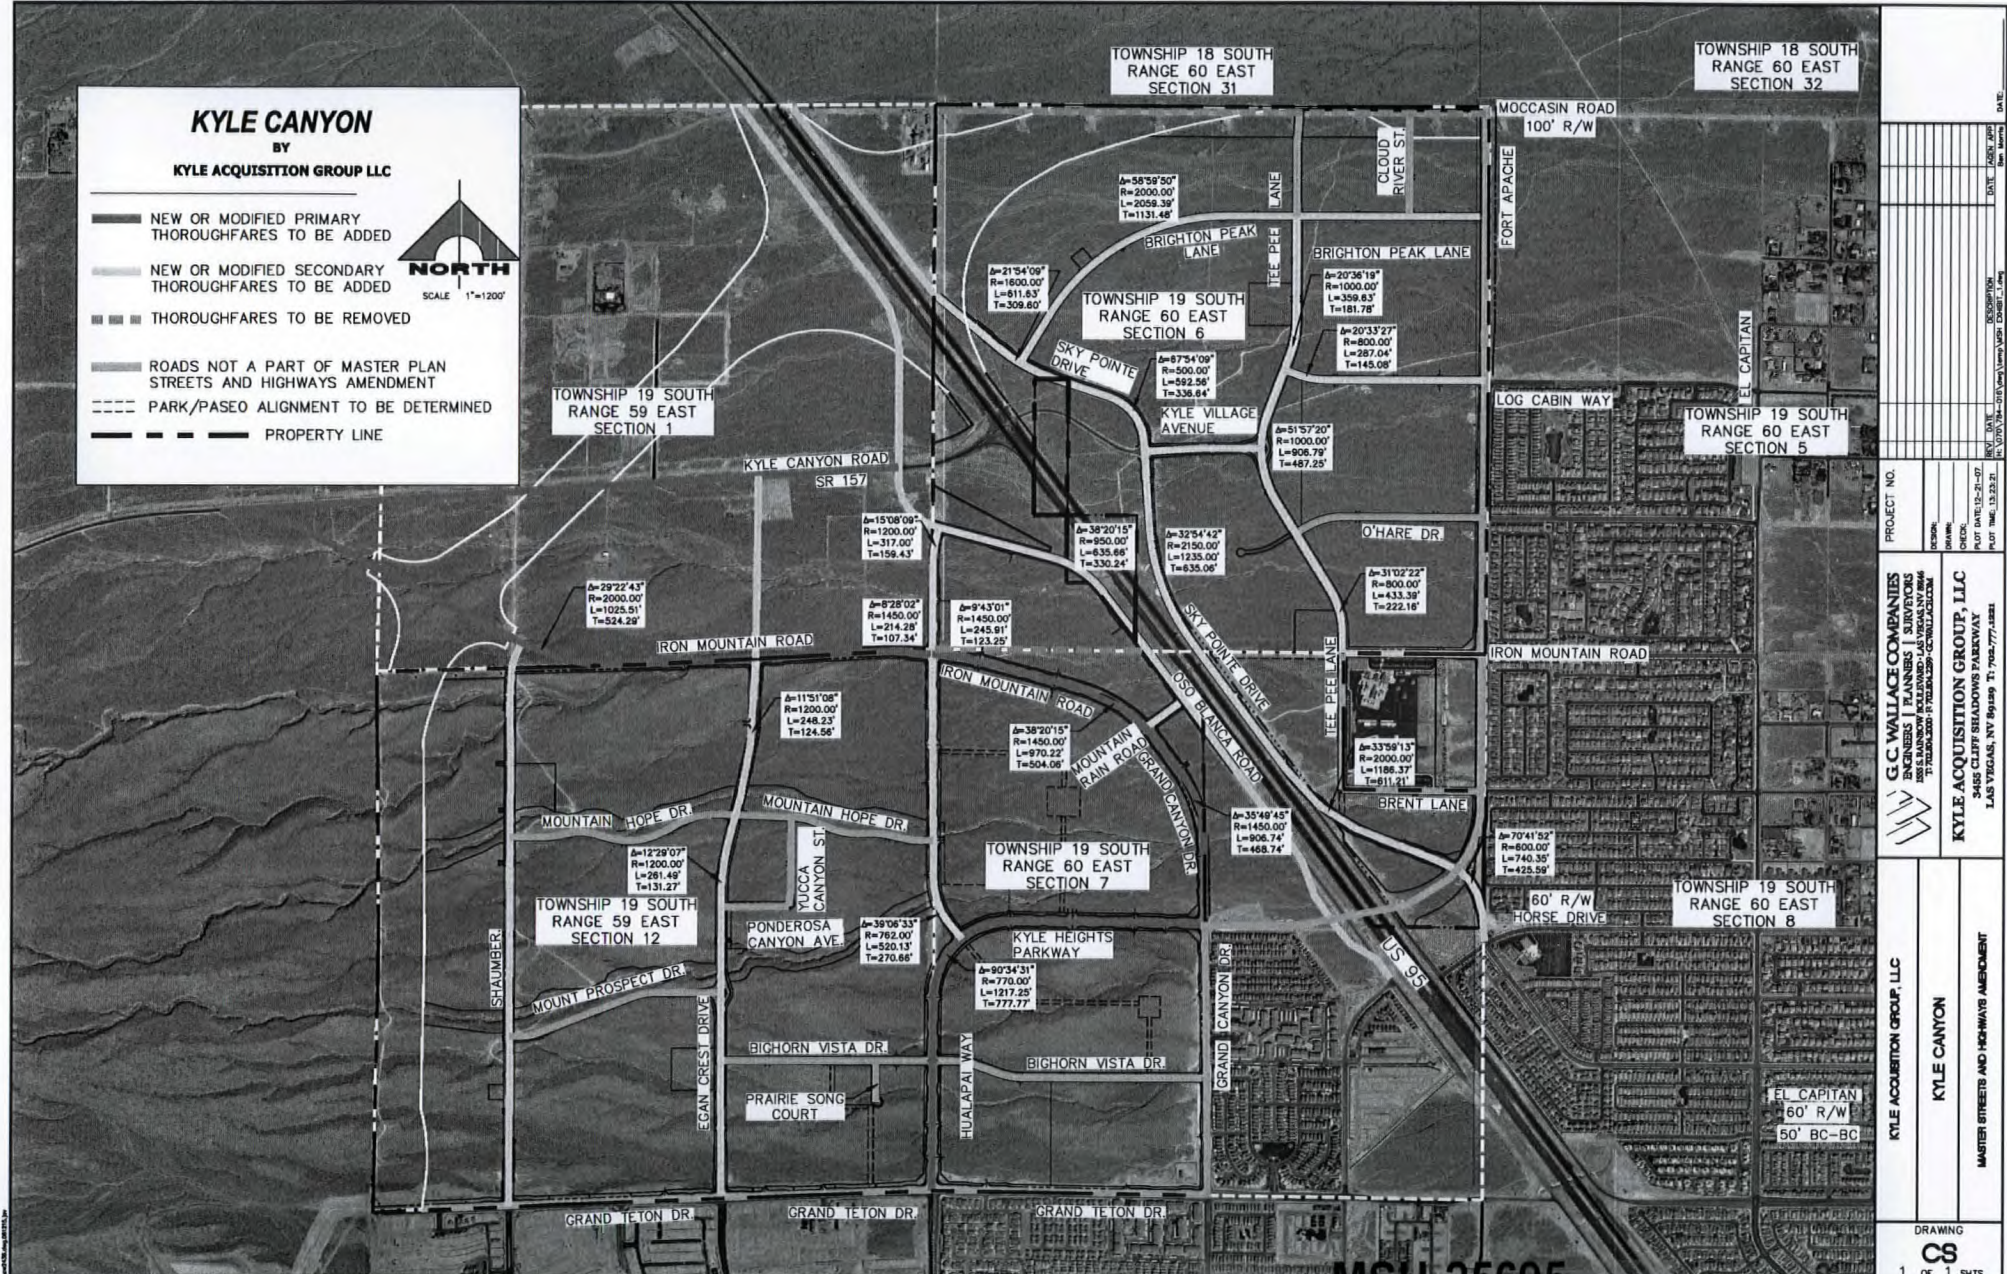
# KYLE CANYON

BY  
KYLE ACQUISITION GROUP LLC

-  NEW OR MODIFIED PRIMARY THOROUGHFARES TO BE ADDED
-  NEW OR MODIFIED SECONDARY THOROUGHFARES TO BE ADDED
-  THOROUGHFARES TO BE REMOVED



-  ROADS NOT A PART OF MASTER PLAN STREETS AND HIGHWAYS AMENDMENT
-  PARK/PASEO ALIGNMENT TO BE DETERMINED
-  PROPERTY LINE




	PROJECT NAME: DATE:
<b>KYLE ACQUISITION GROUP, LLC</b> 3465 CLIFF SHADOWS PARKWAY LAB VEGAS, NV 89149 TEL: 702.777.1881	DATE:
	DATE:
<b>KYLE ACQUISITION GROUP, LLC</b> <b>KYLE CANYON</b> MASTER STREETS AND HIGHWAYS AMENDMENT	DRAWING <b>CS</b> 1 OF 1 SHTS

MSH-25695  
REVISED  
01/10/08 PC

RECEIVED  
DEC 2 1 2007



#	NEW STREET NAME	OLD STREET NAME
1	MOUNTAIN HOPE DRIVE	ACAPELLA
2	MOUNT PROSPECT DRIVE	ADAGIO
3	YUCCA CANYON STREET	CHORALE
4	PONDEROSA CANYON AVENUE	DA CAPO
5	BIGHORN VISTA DRIVE	OSTINATO
6	PRAIRIE SONG COURT	FUGUE
7	KYLE VILLAGE AVENUE	KYLE GATE
8	BRIGHTON PEAK LANE	SONATINA
9	CLOUD RIVER STREET	VIBRATO
10	MOUNTAIN RAIN ROAD	LIBRETTO
11	KYLE HEIGHTS PARKWAY	HORSE DRIVE

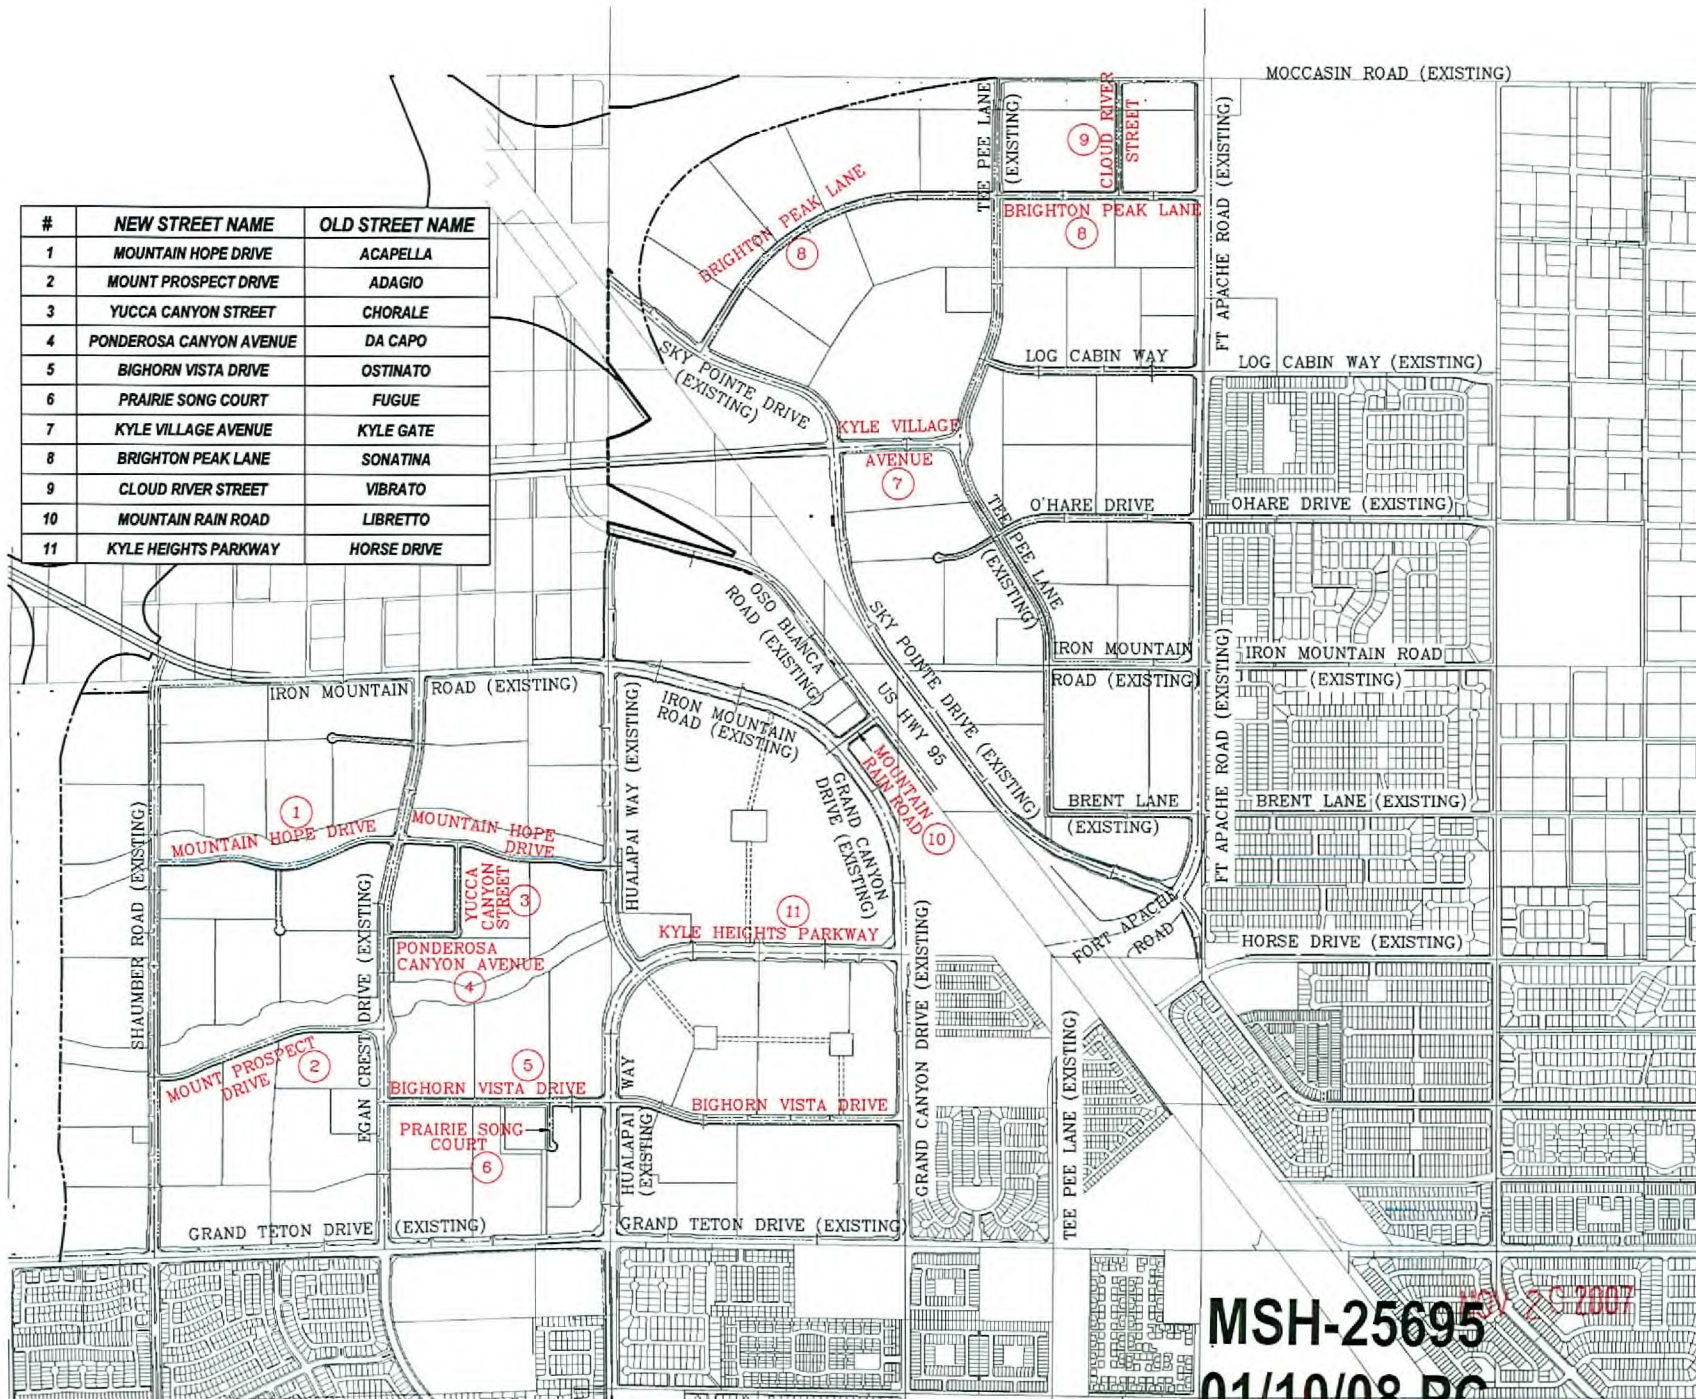

DATE: 11-06-07  
 KYLE CANYON GATEWAY  
 BY KYLE ACQUISITION GROUP, LLC  
 STREET NAME CHANGE KEY MAP

MSH-25695  
 01/10/08 PC