



PLANNING & DEVELOPMENT DEPARTMENT

STATEMENT OF FINANCIAL INTEREST

Case Number: GPA-27207 APN: 140-30-601-001

Name of Property Owner: City of Las Vegas

Name of Applicant: City of Las Vegas

Name of Representative: Melissa Hays

To the best of your knowledge, does the Mayor or any member of the City Council or Planning Commission have any financial interest in this or any other property with the property owner, applicant, the property owner or applicant's general or limited partners, or an officer of their corporation or limited liability company?

Yes No

If yes, please indicate the member of the City Council or Planning Commission who is involved and list the name(s) of the person or persons with whom the City Official holds an interest. Also list the Assessor's Parcel Number if the property in which the interest is held is different from the case parcel.

City Official: _____

Partner(s): _____

APN: _____

Signature of Property Owner: *Robin Yaakun*


Print Name: Robin Yaakun


Subscribed and sworn before me

This 10th day of March, 2008

Christina Strong

Notary Public in and for said County and State

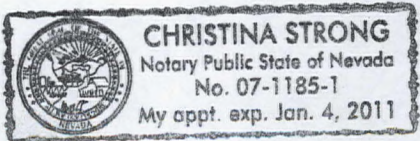

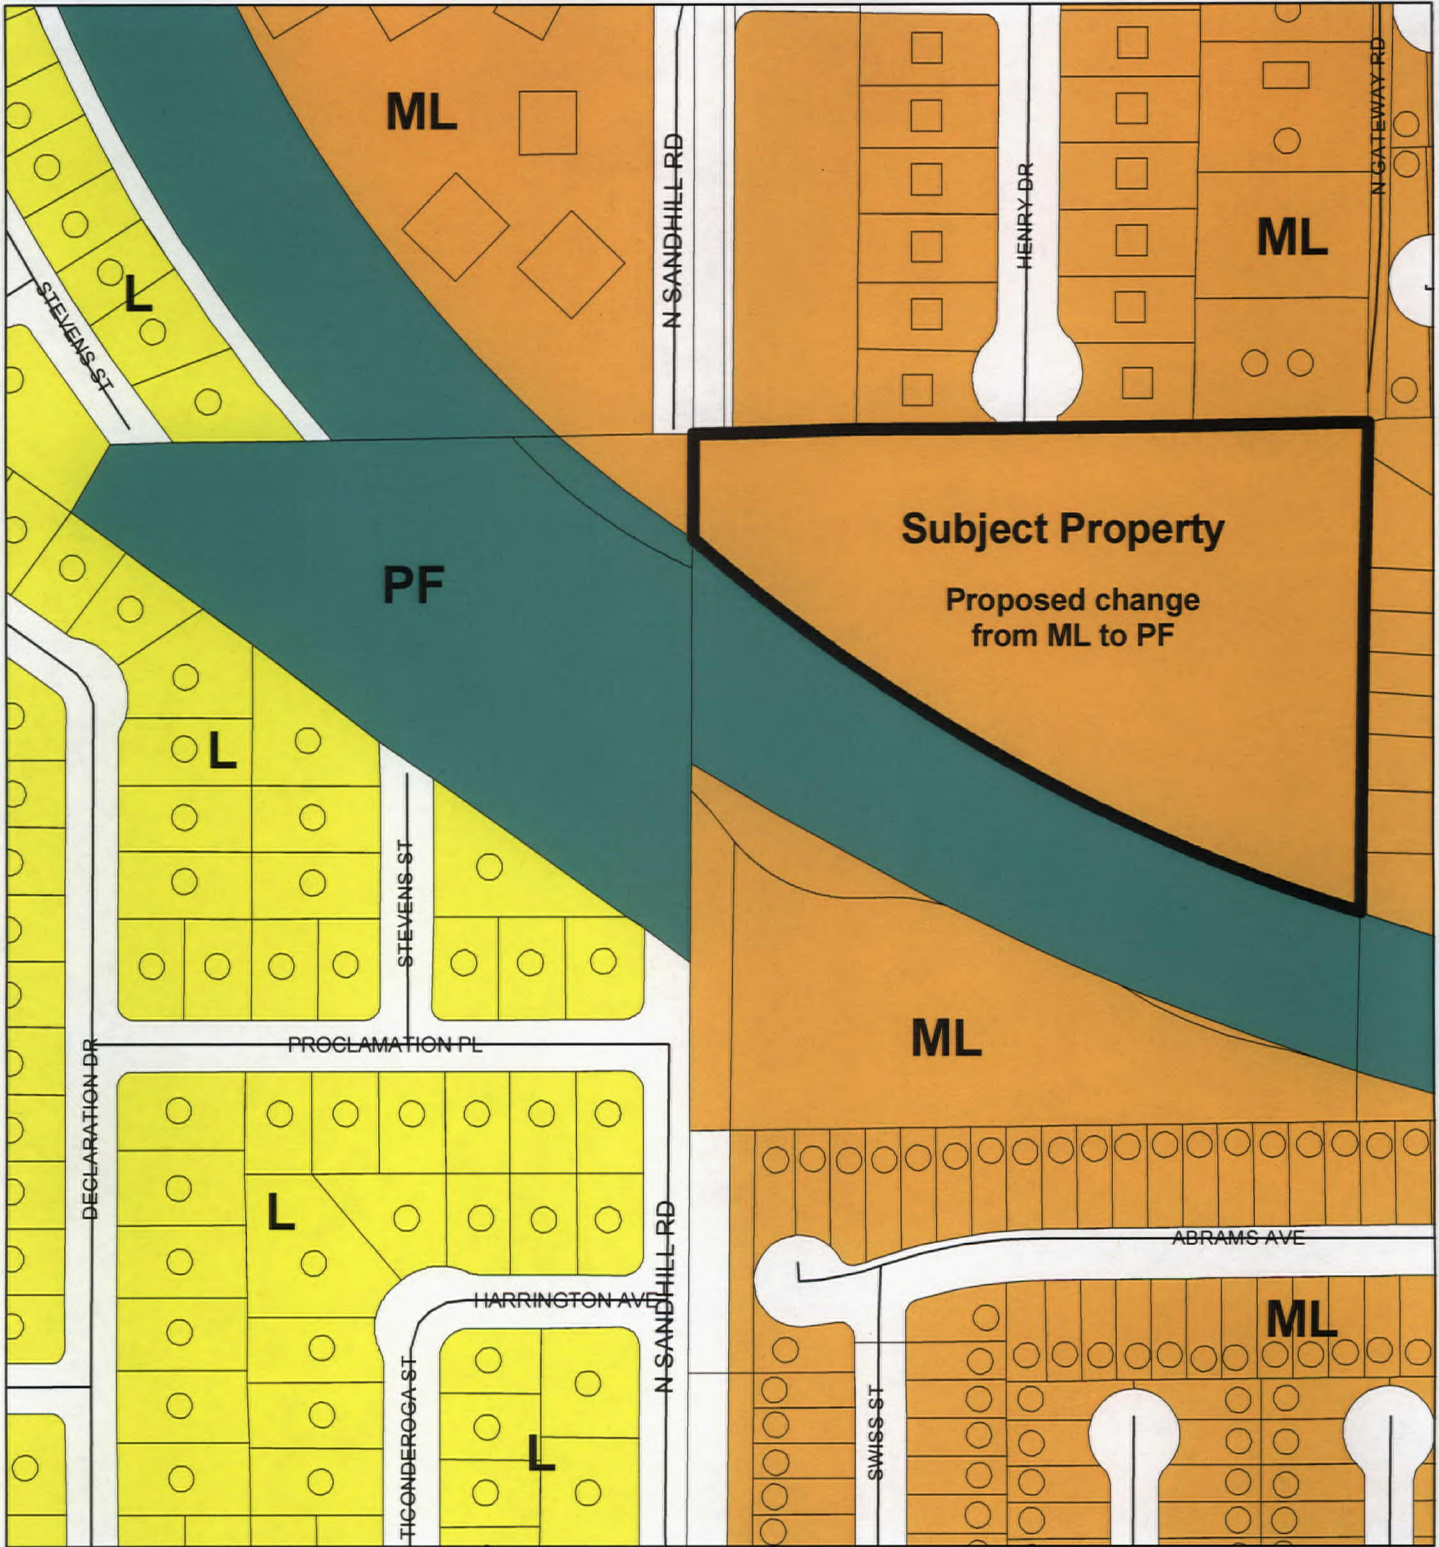

- | | | |
|---------------------------------|--------------------------------|--------------------------------|
| Rural Neighborhood Preservation | Office | Public Facility |
| Rural Estates | Service Commercial | Public Facility - School |
| Desert Rural | General Commercial | Public Facility - Clark County |
| Rural | Tourist Commercial | Town Center |
| Low | Las Vegas Medical District | Resource Conservation |
| Medium - Low | Light Industrial / Research | Downtown - Commercial |
| Medium - Low Attached | Planned Community Development | Downtown - Mixed Use |
| Medium | Downtown Redevelopment Area | Not in City |
| High | Park / Recreation / Open Space | Right - of - Way |

Subject Property



GIS maps are normally produced only to meet the needs of the City. Due to continuous development activity this map is for reference only. Geographic Information System Planning & Development Dept. 702-229-6301



Printed: March 10, 2008