



PLANNING & DEVELOPMENT DEPARTMENT

STATEMENT OF FINANCIAL INTEREST

Case Number: **SDR-27196** APN: 139-36-213-001

Name of Property Owner: Boys Club of Clark County Inc.

Name of Applicant: Lamar Outdoor Advertising

Name of Representative: _____

To the best of your knowledge, does the Mayor or any member of the City Council or Planning Commission have any financial interest in this or any other property with the property owner, applicant, the property owner or applicant's general or limited partners, or an officer of their corporation or limited liability company?

Yes

No

If yes, please indicate the member of the City Council or Planning Commission who is involved and list the name(s) of the person or persons with whom the City Official holds an interest. Also list the Assessor's Parcel Number if the property in which the interest is held is different from the case parcel.

City Official: _____

Partner(s): _____

APN: _____

Signature of Property Owner:


Print Name: Jim Richards


Subscribed and sworn before me

This 27th day of February, 2008


Kelley R. Grim

Notary Public in and for said County and State

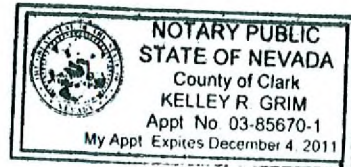


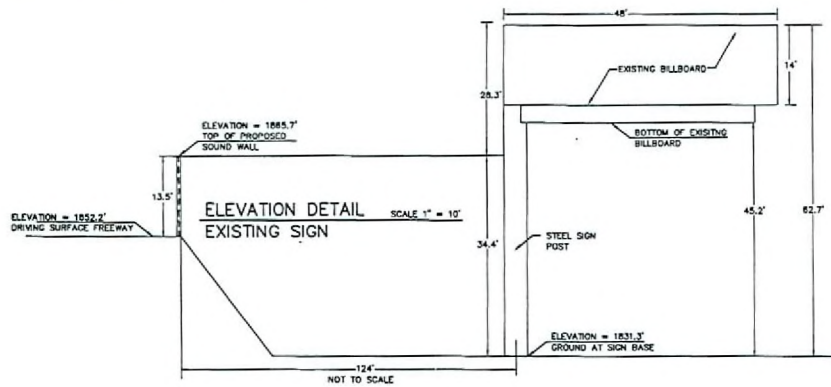

I 515

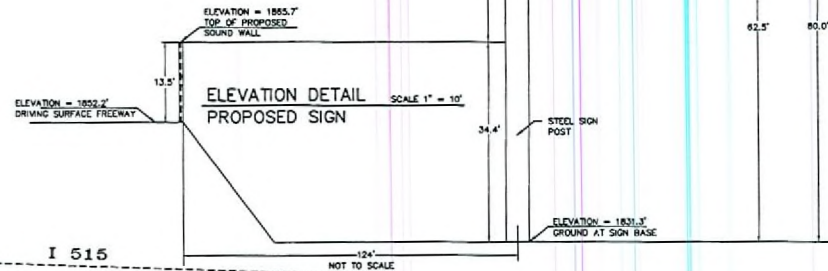

I 515

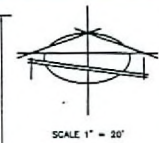

LEGEND

- STREET CENTERLINE
- PROPERTY LINE
- - - CHAIN LINK FENCE




VICINITY MAP NO SCALE

ZONING


R-4 APARTMENT RESIDENCE DISTRICT

LAMAR OUTDOOR ADVERTISING
873-4800

OWNER:
BOYS CLUBS OF CLARK COUNTY, INC.
SITE LOCATION:
2800 MARLIN AVE.

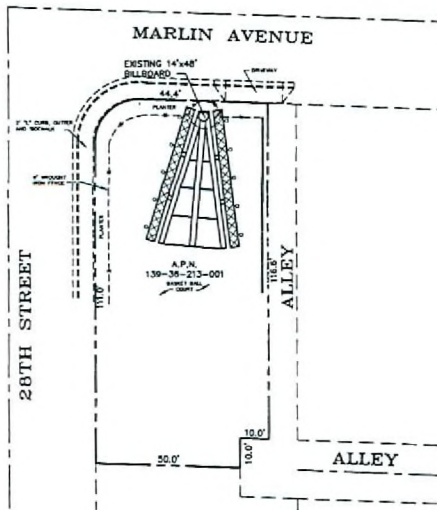

EXISTING BILLBOARD LOCATION
SCALE 1" = 20'

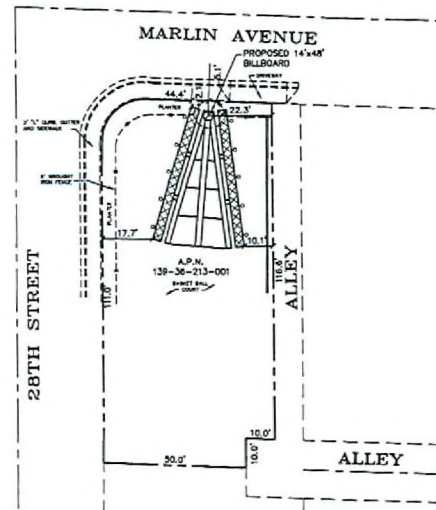

PROPOSED BILLBOARD LOCATION
SCALE 1" = 20'

RECEIVED
MAR 10 2008

SDR-27196
04/24/08 PC

DATE	BY	FOR
04/24/08	JM	REVISION
DATE	BY	FOR
PREPARED FOR: JONES MEDIA		
BAUGHMAN & TURNER, INC. 210 HOBSON STREET, SUITE 200, LAS VEGAS, NEVADA 89101 PH: (702) 894-8071 FAX: (702) 894-8288		
BILLBOARD REVISION PLAN A.P.N. 139-36-213-001 A PORTION OF THE NORTHWEST QUARTER (NW 1/4) OF SECTION 36, TOWNSHIP 20 SOUTH, RANGE 41 EAST, 4th D.M., CITY OF LAS VEGAS, CLARK COUNTY, NEVADA		
SCALE	1" = 20'	
PROJ. NO.	SDR-27196	