



**PLANNING & DEVELOPMENT DEPARTMENT**

**STATEMENT OF FINANCIAL INTEREST**

Case Number: **SUP-27313** APN: 138-25-404-004

Name of Property Owner: D & W Inc

Name of Applicant: 95 Pacific Supermart

Name of Representative: Andrew Lai

To the best of your knowledge, does the Mayor or any member of the City Council or Planning Commission have any financial interest in this or any other property with the property owner, applicant, the property owner or applicant's general or limited partners, or an officer of their corporation or limited liability company?

Yes  No

If yes, please indicate the member of the City Council or Planning Commission who is involved and list the name(s) of the person or persons with whom the City Official holds an interest. Also list the Assessor's Parcel Number if the property in which the interest is held is different from the case parcel.

City Official: \_\_\_\_\_

Partner(s): \_\_\_\_\_

APN: \_\_\_\_\_


Signature of Property Owner: \_\_\_\_\_  
By: Ronald L. Gerv Authorized Officer  
Price Development Company, Limited Partnership \*  
By: GGP Acquisition L.L.C., its general partner

Print Name: Ronald L. Gerv

\*As owner of most of the building improvements comprising Fremont Plaza and the Lessee under a long term Ground Lease.  
Subscribed and sworn before me

This 14<sup>th</sup> day of March, 2008  
Leslee C Tornabeni  
Notary Public in and for said County and State



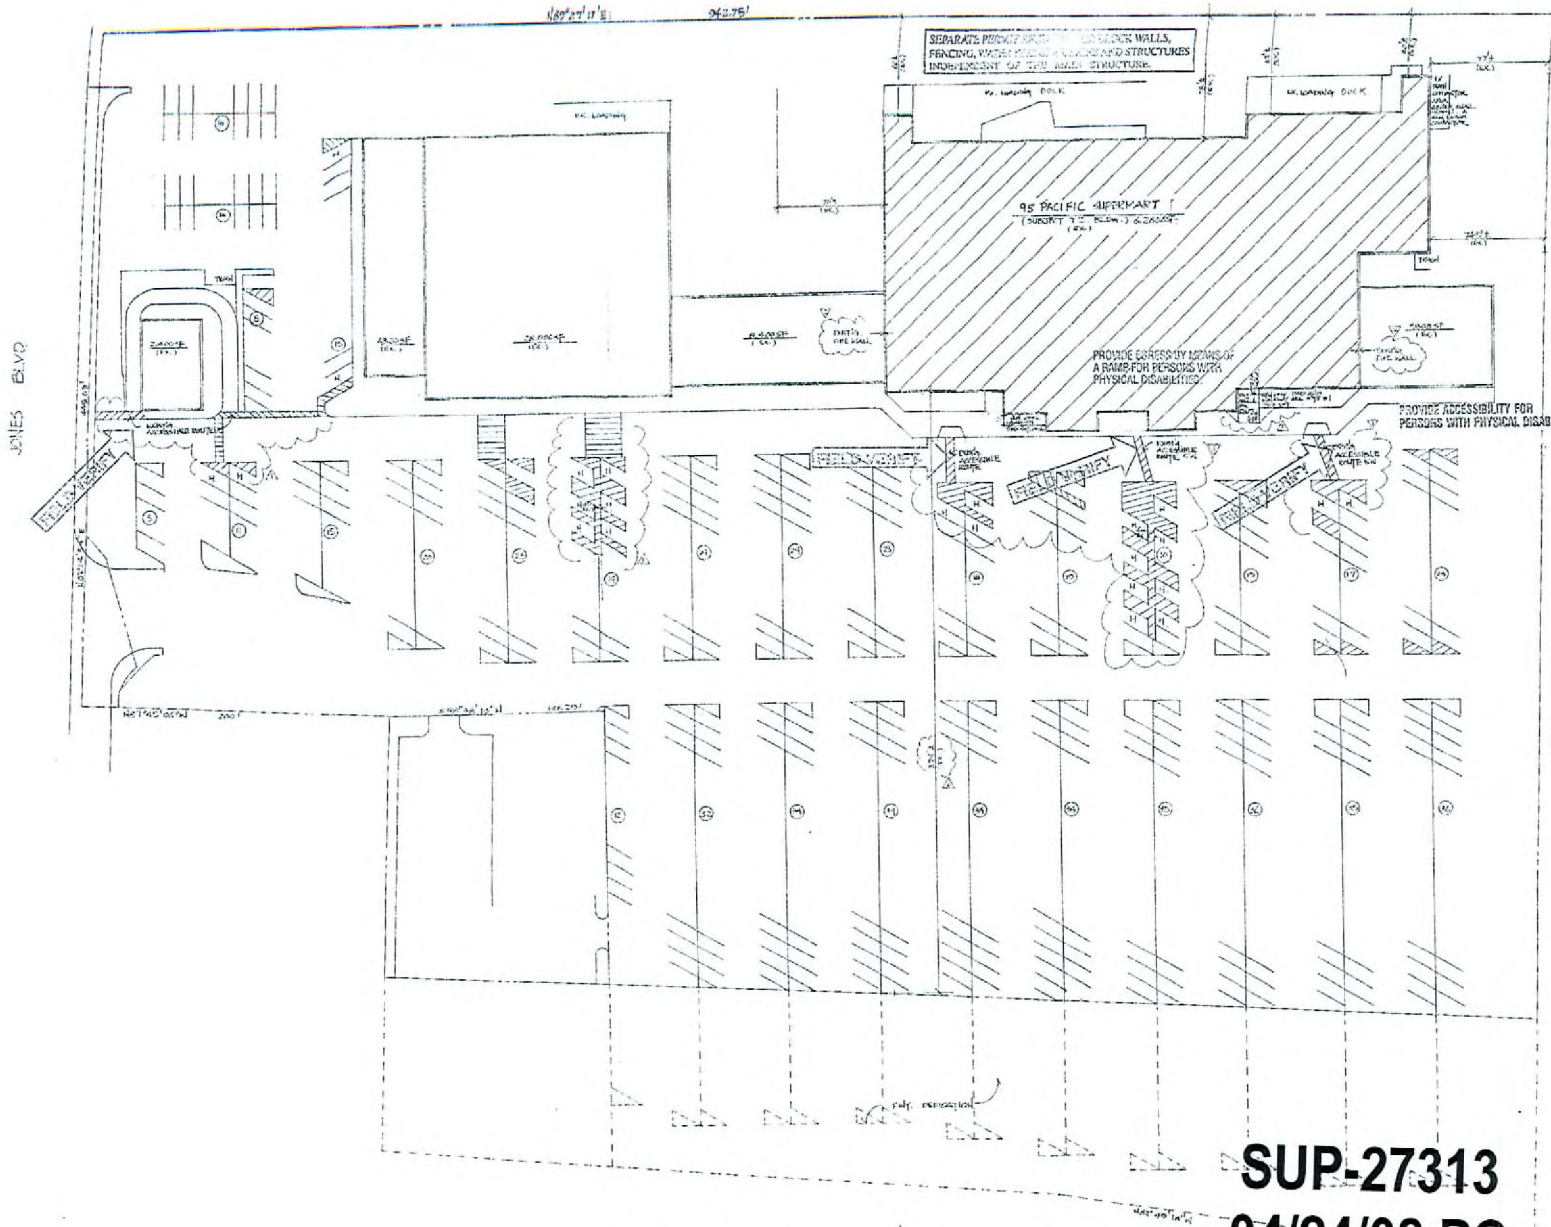


PARKING ANALYSIS

TOTAL COMMERCIAL SPACE	113,714 sq. ft.
TOTAL PARKING REQ'D (1 per 700 sq. ft.)	455
TOTAL NO. SPACES	
Regular	620
Handicapped	23
TOTAL	643

RECEIVED  
MAR 05 2008  
CITY OF LAS VEGAS  
PLANNING DEPARTMENT

RECEIVED  
MAR 11 2008  
CITY OF LAS VEGAS  
PLANNING DEPARTMENT

SUP-27313  
04/24/08 PC

EXISTING SITE PLAN  
PROJECT

REVISIONS	BY
1	...
2	...
3	...
4	...
5	...
6	...
7	...
8	...
9	...
10	...

L.J. FAN & ASSOCIATES  
5222 MONTELEONE PARK CIR.  
LAS VEGAS, NV 89169  
TEL: (702) 366-8228 FAX: (702) 366-8214

RECEIVED  
MAR 05 2008  
CITY OF LAS VEGAS  
PLANNING DEPARTMENT

RECEIVED  
MAR 11 2008  
CITY OF LAS VEGAS  
PLANNING DEPARTMENT

