



PLANNING & DEVELOPMENT DEPARTMENT

STATEMENT OF FINANCIAL INTEREST

Case Number: **SUP-25259** APN: _____

Name of Property Owner: GILDAY FAMILY TRUST

Name of Applicant: FIRSTA DISCOUNT MARKET - MASOOD "SAM" SIOMAN

Name of Representative: H&L REALTY & MGMT - RUBY ABRAHAM

To the best of your knowledge, does the Mayor or any member of the City Council or Planning Commission have any financial interest in this or any other property with the property owner, applicant, the property owner or applicant's general or limited partners, or an officer of their corporation or limited liability company?

_____ Yes

X No

If yes, please indicate the member of the City Council or Planning Commission who is involved and list the name(s) of the person or persons with whom the City Official holds an interest. Also list the Assessor's Parcel Number if the property in which the interest is held is different from the case parcel.

City Official: _____

Partner(s): _____

APN: _____


Signature of Property Owner: US Bank National Association, Trustee f/b/o Donald S Gilday Rosacable Trust

Print Name: Kenneth D. Roth, VP
Kenneth D. Roth, VP


Subscribed and sworn before me

This 19th day of October, 2007

Ann Webb
Notary Public in and for said County and State

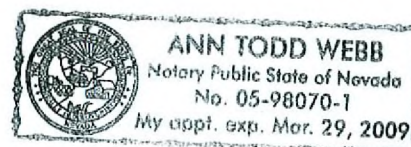

RECEIVED
OCT 23 2007

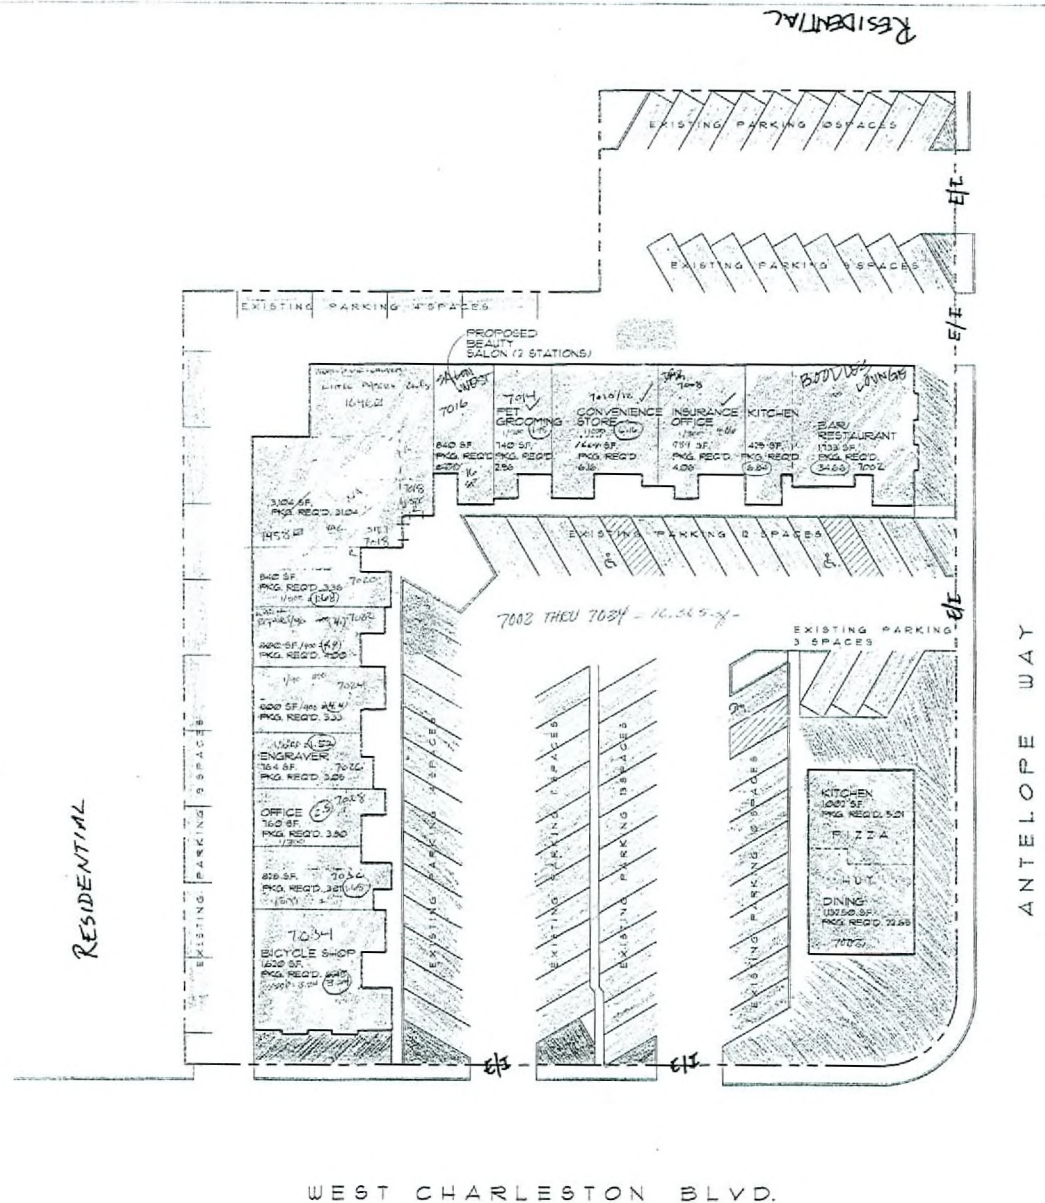

PARKING ANALYSIS
TOTAL PARKING REQUIRED (12)
PARKING PROVIDED (12)

7-11

SUP-25259
12/06/07 PC

ADDP RANGE 7002 - 7034
LESS 8 PARKING
1/15/07 AS PER DAI 3/1/11
FIESTA SQUARE PARKING ANALYSIS
P. 10-0"


OFFICE BUSINESS PARK

OFFICE BUSINESS PARK

RECEIVED
OCT 23 2007

Fiesta Discount Market

7010 and 7012 W. Charleston

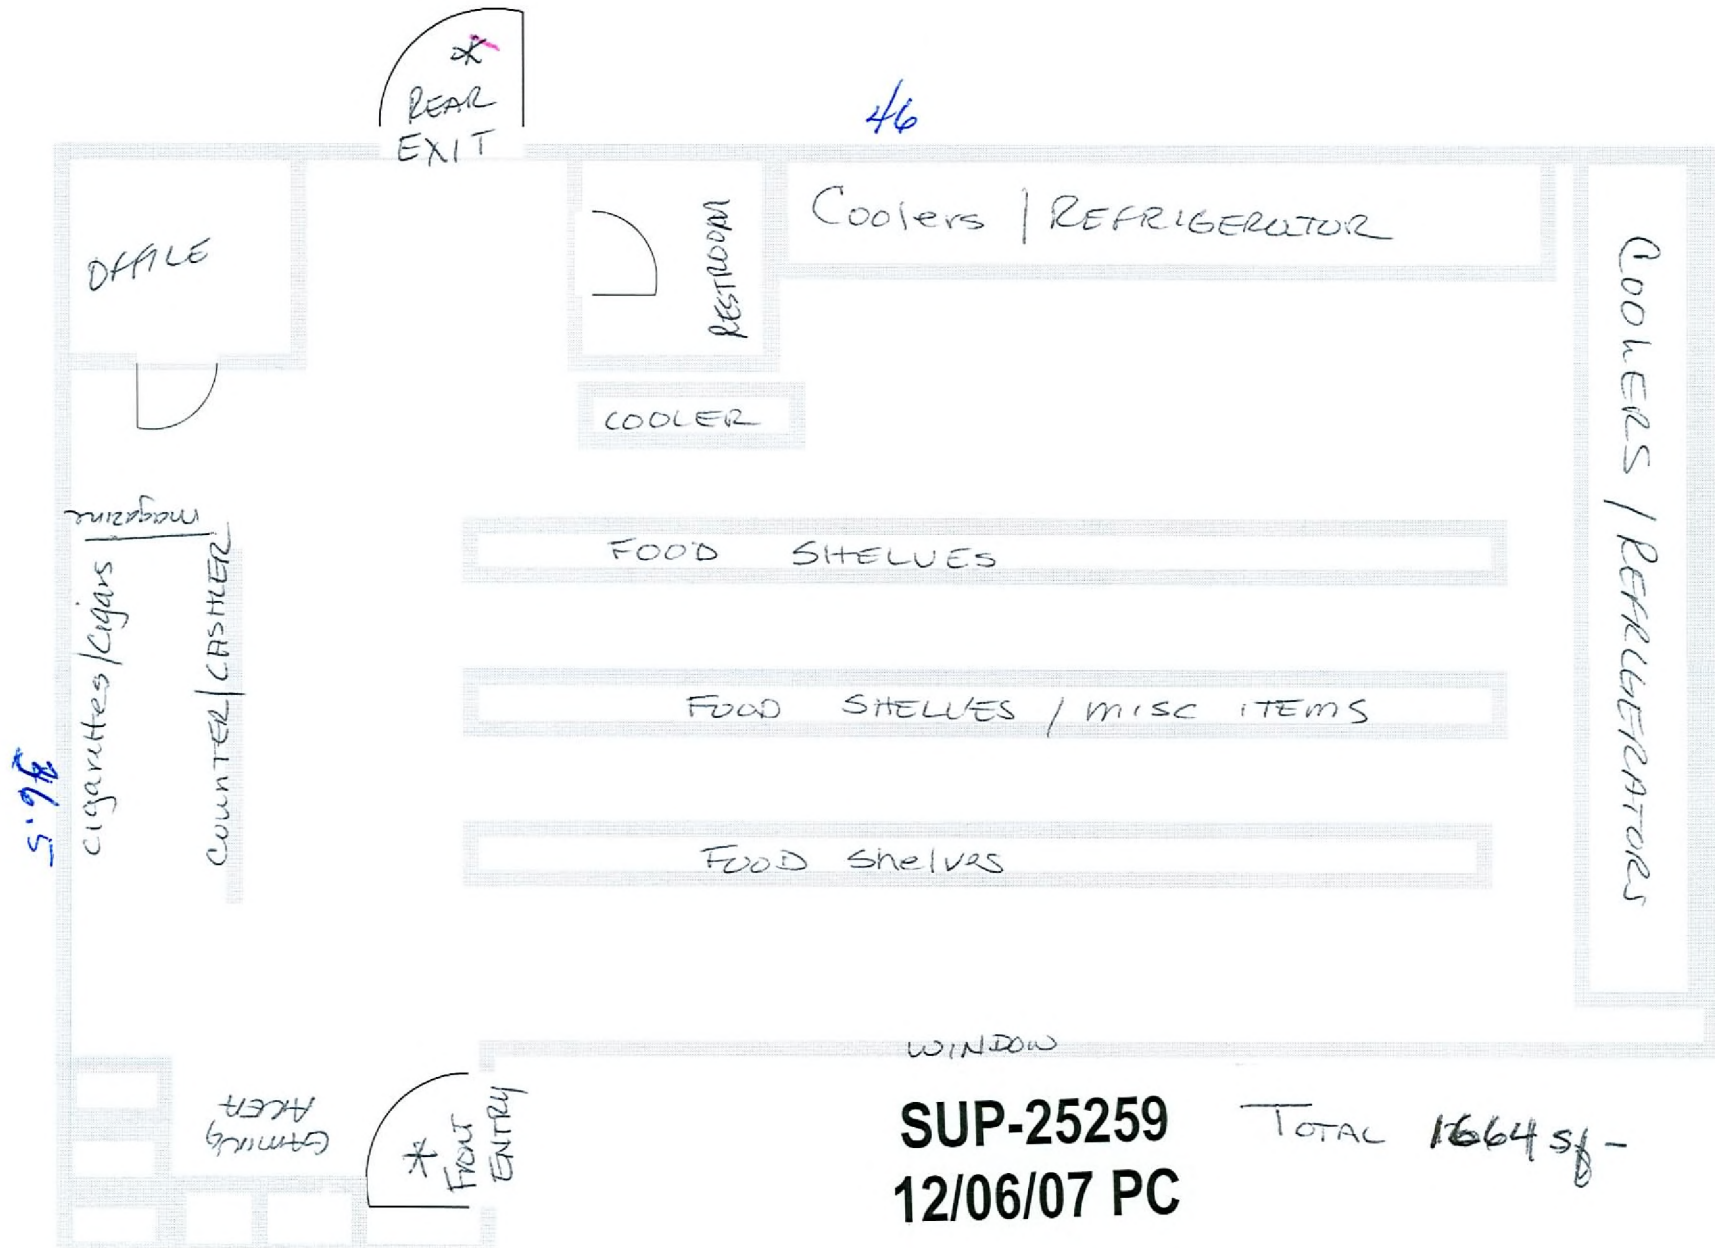

RECEIVED
OCT 23 2007

