



PLANNING & DEVELOPMENT DEPARTMENT

STATEMENT OF FINANCIAL INTEREST

Case Number: **SUP-26427** APN: 138-25-303-007
Name of Property Owner: DECATUR SHOPPING CENTER ASSOCIATES
Name of Applicant: CLARENCE LONG
Name of Representative: _____

To the best of your knowledge, does the Mayor or any member of the City Council or Planning Commission have any financial interest in this or any other property with the property owner, applicant, the property owner or applicant's general or limited partners, or an officer of their corporation or limited liability company?

_____ Yes X No

If yes, please indicate the member of the City Council or Planning Commission who is involved and list the name(s) of the person or persons with whom the City Official holds an interest. Also list the Assessor's Parcel Number if the property in which the interest is held is different from the case parcel.

City Official: _____

Partner(s): _____

APN: _____


Signature of Property Owner: Burt J. Blum

Print Name: BURT J. BLUM

Subscribed and sworn before me

This 8th day of January, 2008

Bea Landen
Notary Public in and for said County and State

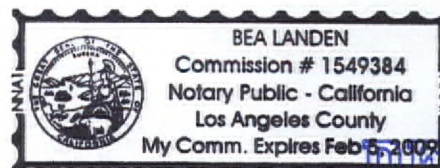

RECEIVED
JAN 15 2008

CALIFORNIA ALL-PURPOSE ACKNOWLEDGMENT

State of California

County of Los Angeles

On January 8, 2008 before me,

personally appeared BURT J. Blum

Here Insert Name and Title of the Officer

Name(s) of Signer(s)

who proved to me on the basis of satisfactory evidence to be the person(s) whose name(s) is/are subscribed to the within instrument and acknowledged to me that he/she/they executed the same in his/her/their authorized capacity(ies), and that by his/her/their signature(s) on the instrument the person(s), or the entity upon behalf of which the person(s) acted, executed the instrument.

I certify under PENALTY OF PERJURY under the laws of the State of California that the foregoing paragraph is true and correct.

WITNESS my hand and official seal.

Signature Bea Landen

Signature of Notary Public



Place Notary Seal Above

OPTIONAL

Though the information below is not required by law, it may prove valuable to persons relying on the document and could prevent fraudulent removal and reattachment of this form to another document.

Description of Attached Document

Title or Type of Document: Statement of Financial Interest

Document Date: 1-8-2008

Number of Pages: 1

Signer(s) Other Than Named Above: _____

Capacity(ies) Claimed by Signer(s)

Signer's Name: _____

- ☐ Individual
☐ Corporate Officer — Title(s): _____
☐ Partner — ☐ Limited ☐ General
☐ Attorney in Fact
☐ Trustee
☐ Guardian or Conservator
☐ Other: _____

Signer Is Representing: _____

RIGHT THUMBPRINT
OF SIGNER
Top of thumb here

Signer's Name: _____

- ☐ Individual
☐ Corporate Officer — Title(s): _____
☐ Partner — ☐ Limited ☐ General
☐ Attorney in Fact
☐ Trustee
☐ Guardian or Conservator
☐ Other: _____

Signer Is Representing: _____

RIGHT THUMBPRINT
OF SIGNER
Top of thumb here

RECEIVED
JAN 15 2008

Sliding Doors
and Folding Doors

IN ALCOVES SHALL COMPLY WITH
CES FOR FRONT APPROACHES.


COVERING CLEARANCES
RS

4 RAMP DIMENSIONS

URB WITH ASPHALT

ED PARKING AREA TO "VAN ACCESSIBLE"
ITY OF LAS VEGAS REQUIREMENTS

WEST MORELAND BLVD.

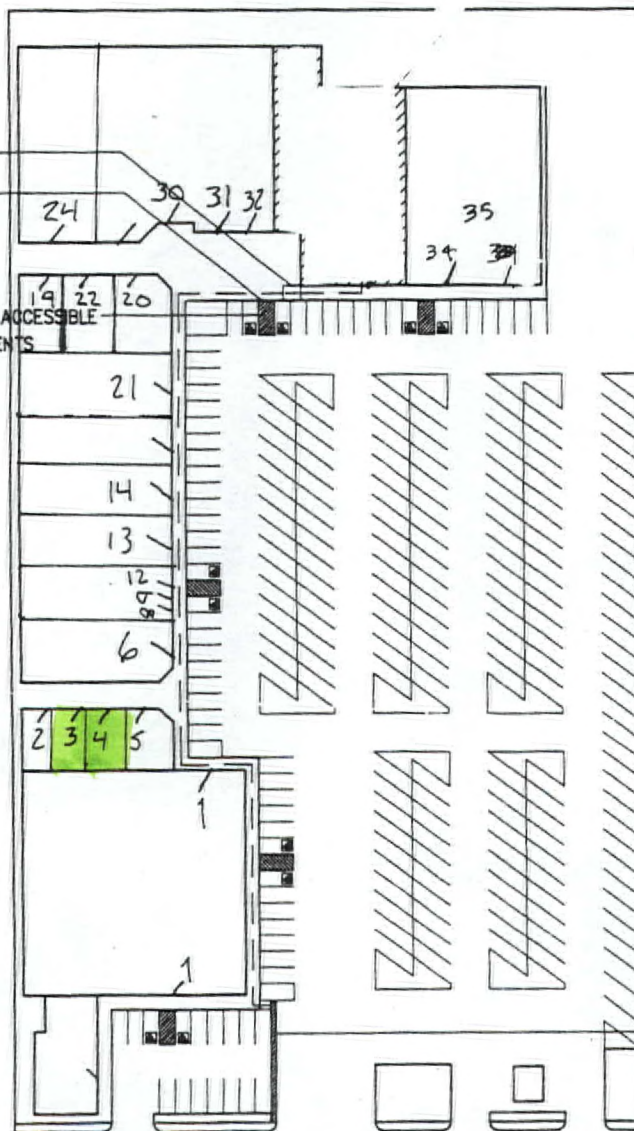

EXISTING PATH OF TRAVEL TO SIDE V
INDICATED WITH DASH LINE FROM NEV

RECEIVED
JAN 30 2008

NORTH DECATUR


SUP-26427

REVISED

1401 N. DECATUR
SITE PLAN

02/28/08 PC

SCALE: N.T.S.

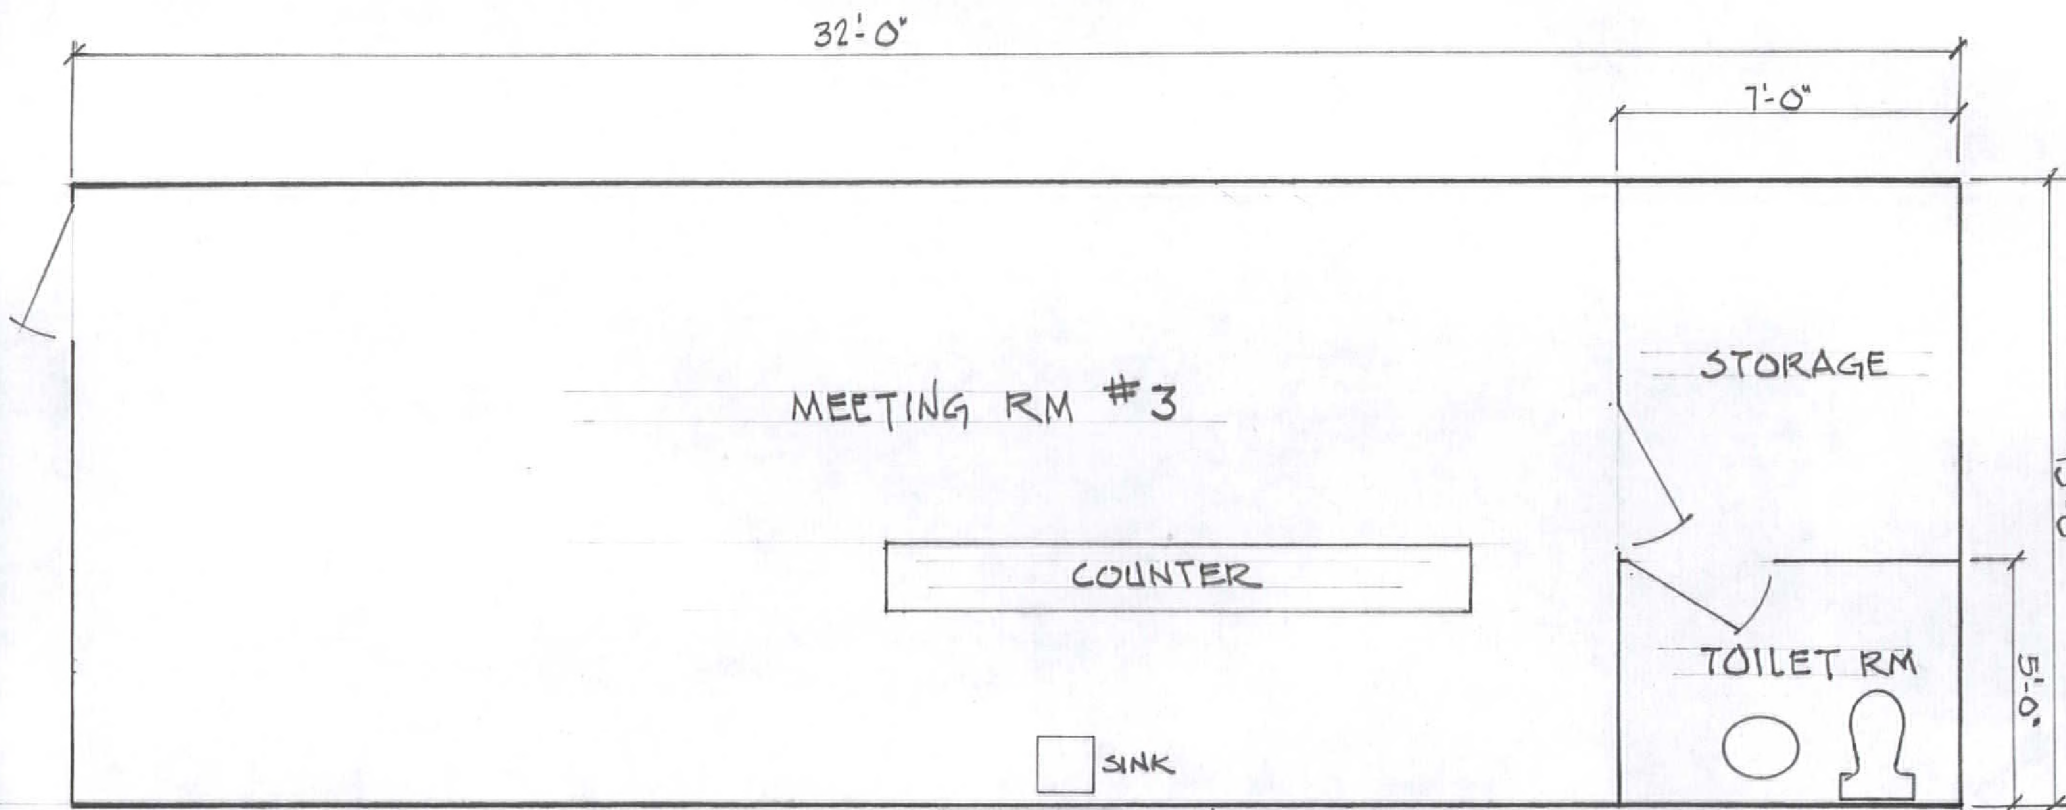


3M MEETING MAKERS MAKE IT RECOVERY CLUB

SCALE: 1/4" = 1'-0"



SUP-26427
02/28/08 PC

RECEIVED
JAN 15 2008

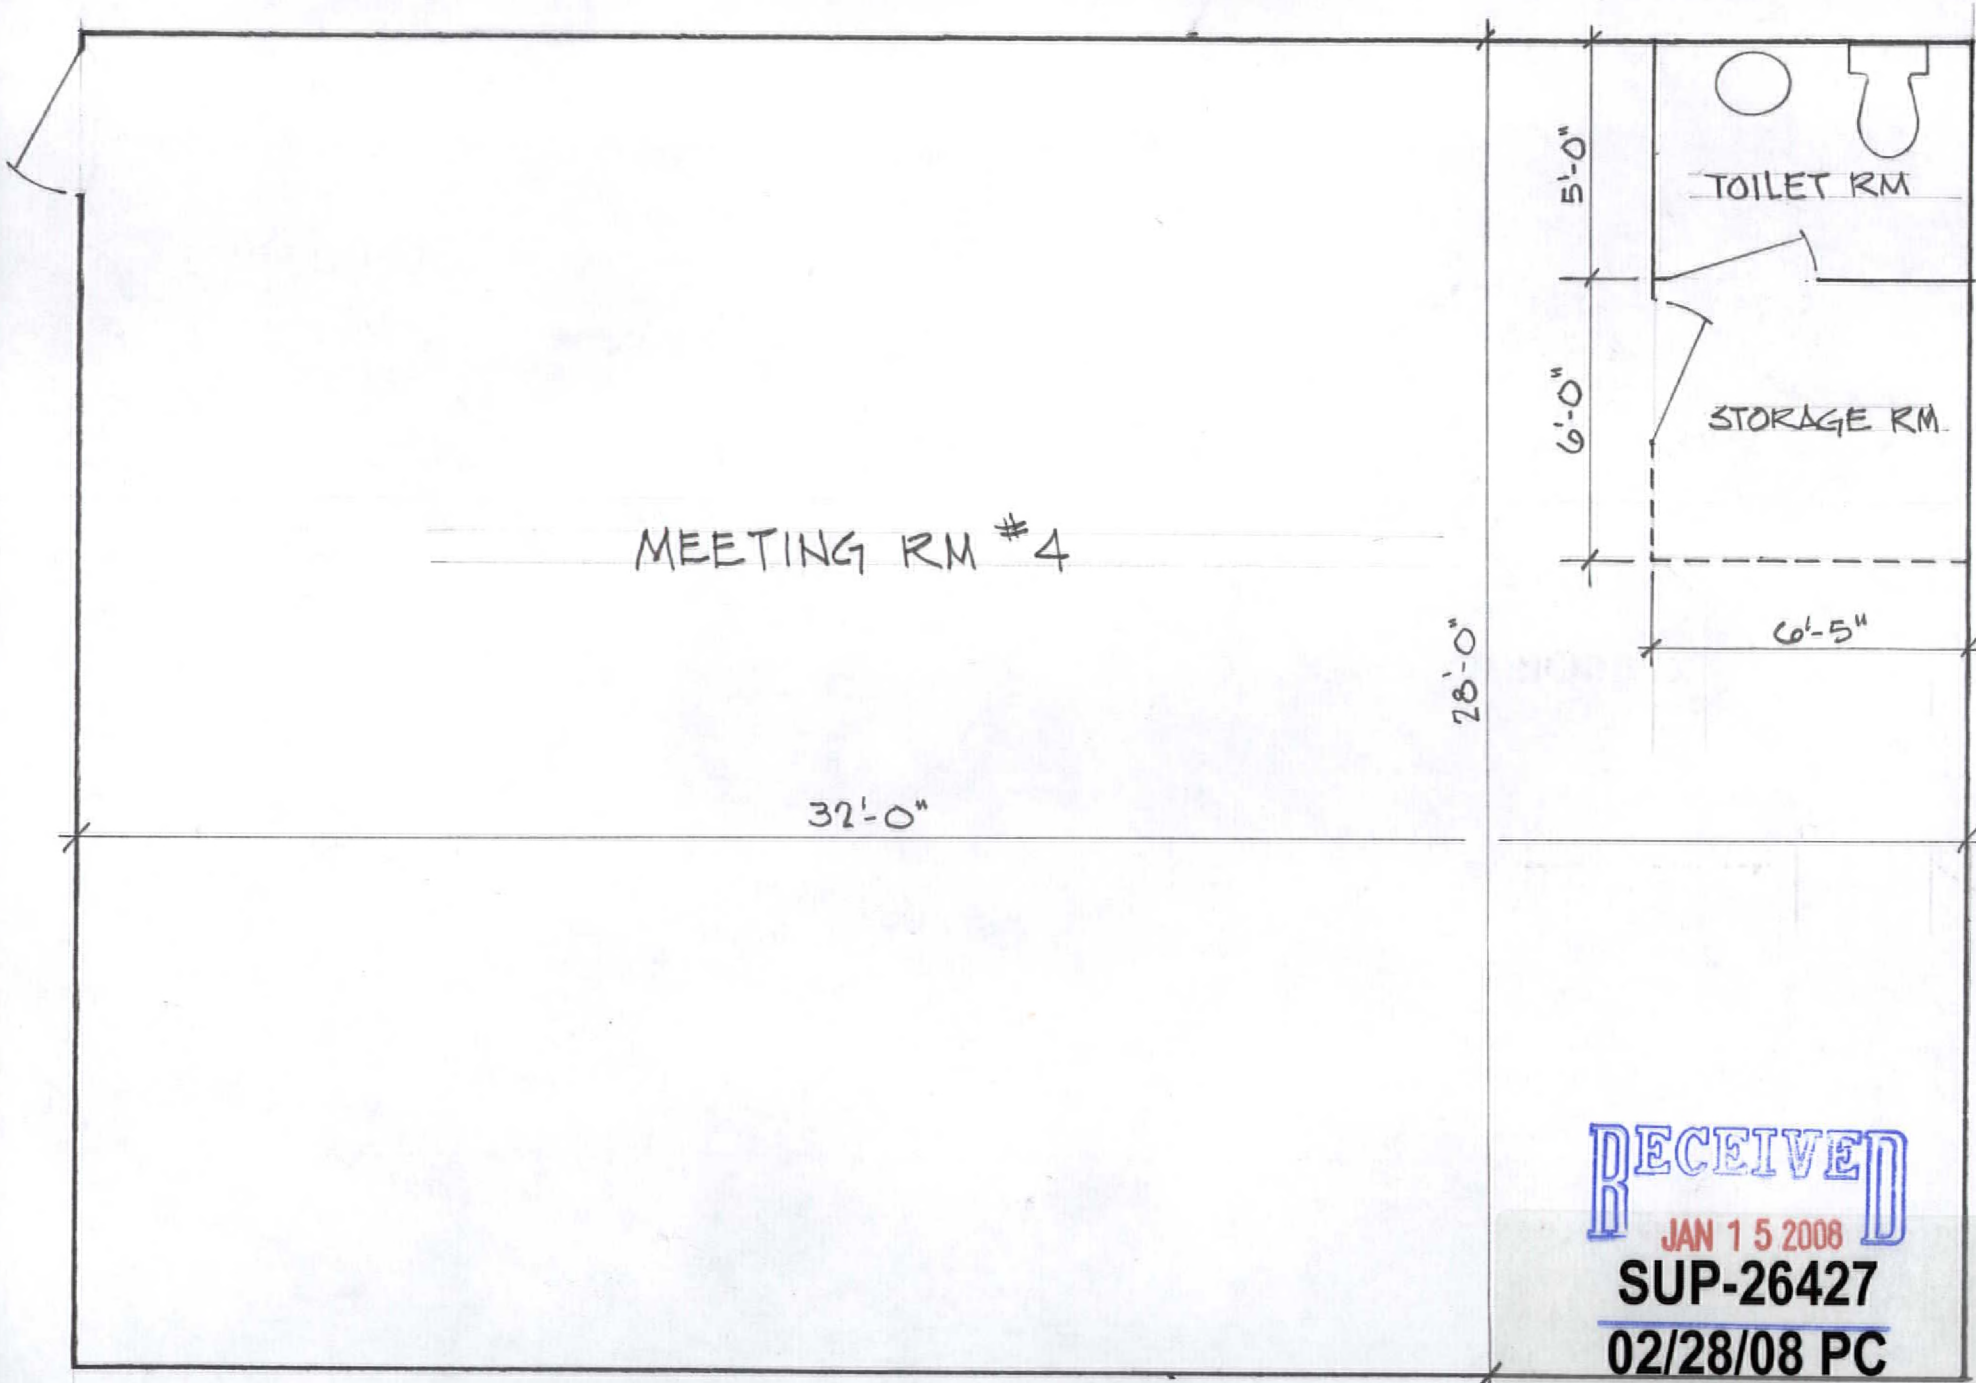

RECEIVED

JAN 15 2008

SUP-26427

02/28/08 PC

3M MEETING MAKERS MAKE IT RECOVERY CLUB

SCALE: 1/4" = 1'-0"

