



PLANNING & DEVELOPMENT DEPARTMENT

STATEMENT OF FINANCIAL INTEREST

Case Number: **SUP-27313** APN: 138-25-404-004
Name of Property Owner: D & W Inc
Name of Applicant: 95 Pacific Supermart
Name of Representative: Andrew Lai

To the best of your knowledge, does the Mayor or any member of the City Council or Planning Commission have any financial interest in this or any other property with the property owner, applicant, the property owner or applicant's general or limited partners, or an officer of their corporation or limited liability company?

☐ Yes

☒ No

If yes, please indicate the member of the City Council or Planning Commission who is involved and list the name(s) of the person or persons with whom the City Official holds an interest. Also list the Assessor's Parcel Number if the property in which the interest is held is different from the case parcel.

City Official: _____

Partner(s): _____

APN: _____


Signature of Property Owner: _____
By: GGP Acquisition L.L.C., its general partner
Authorized Officer

Print Name: Ronald L. Gerv

*As owner of most of the building improvements comprising Fremont Plaza and the Lessee under a long term Ground Lease,
Subscribed and sworn before me

This 14th day of March, 2008
Leslee C Tornabeni
Notary Public in and for said County and State

"OFFICIAL SEAL"
LESLEE C TORNABENI
Notary Public, State of Illinois
My Commission Expires 11/4/2009

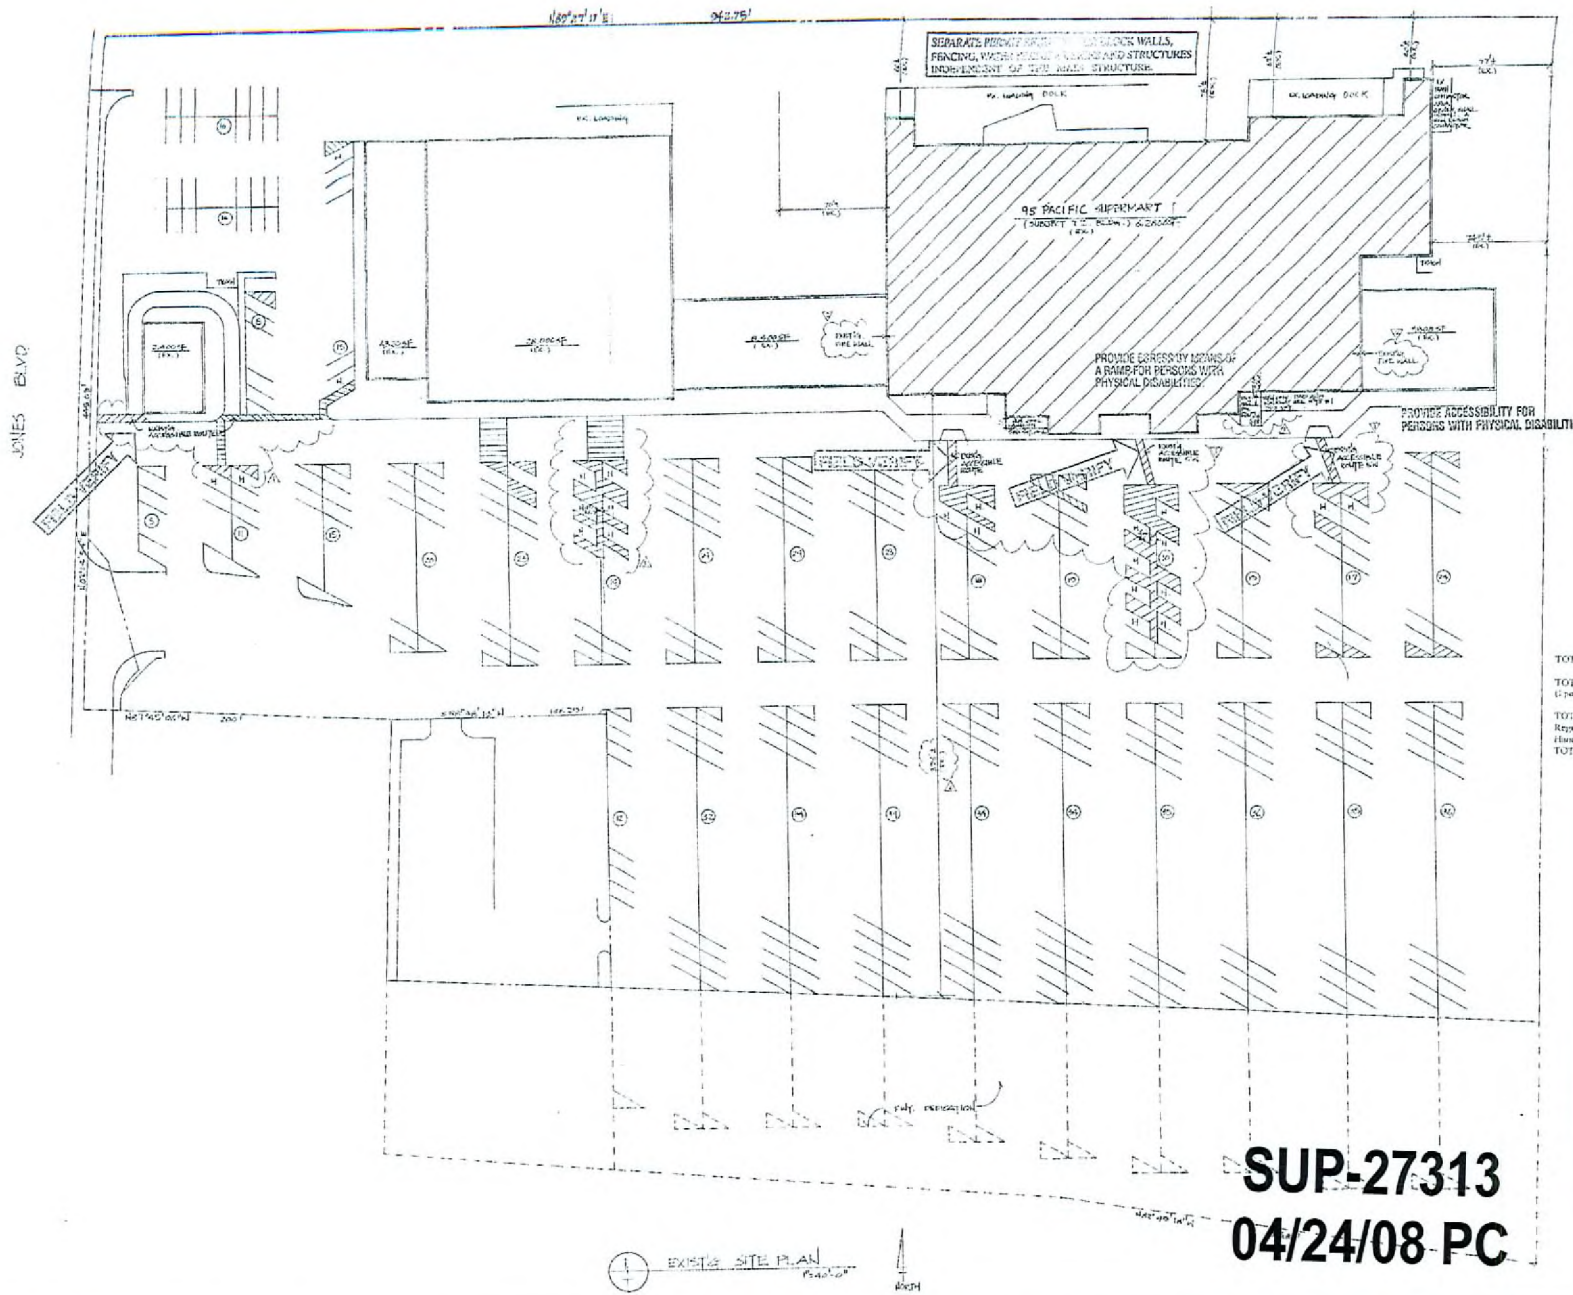

1. REVIEW AND APPROVE THE SITE PLAN AND ALL THE INFORMATION CONTAINED HEREIN. THE CITY OF LAS VEGAS, NEVADA, IS NOT RESPONSIBLE FOR THE ACCURACY OF THE INFORMATION CONTAINED HEREIN.

PARKING ANALYSIS

TOTAL COMMERCIAL SPACE	113,714 sq. ft.
TOTAL PARKING REQ'D	455
(1 per 250 sq. ft.)	
TOTAL NO. SPACES	
Regular	620
Handicapped	23
TOTAL	643

RECEIVED
MR. OSWALD
CITY OF LAS VEGAS
PLANNING

RECEIVED
MAR 1 2008
CITY OF LAS VEGAS
PLANNING

SUP-27313
04/24/08 PC


REVISIONS BY
1. 04/24/08 LJP
2. 04/24/08 LJP

L.J. FAN & ASSOCIATES
5222 MONTEREY PARK CIR.
LAS VEGAS, NV 89146
TEL: (702) 306-0200 FAX: (702) 306-0214




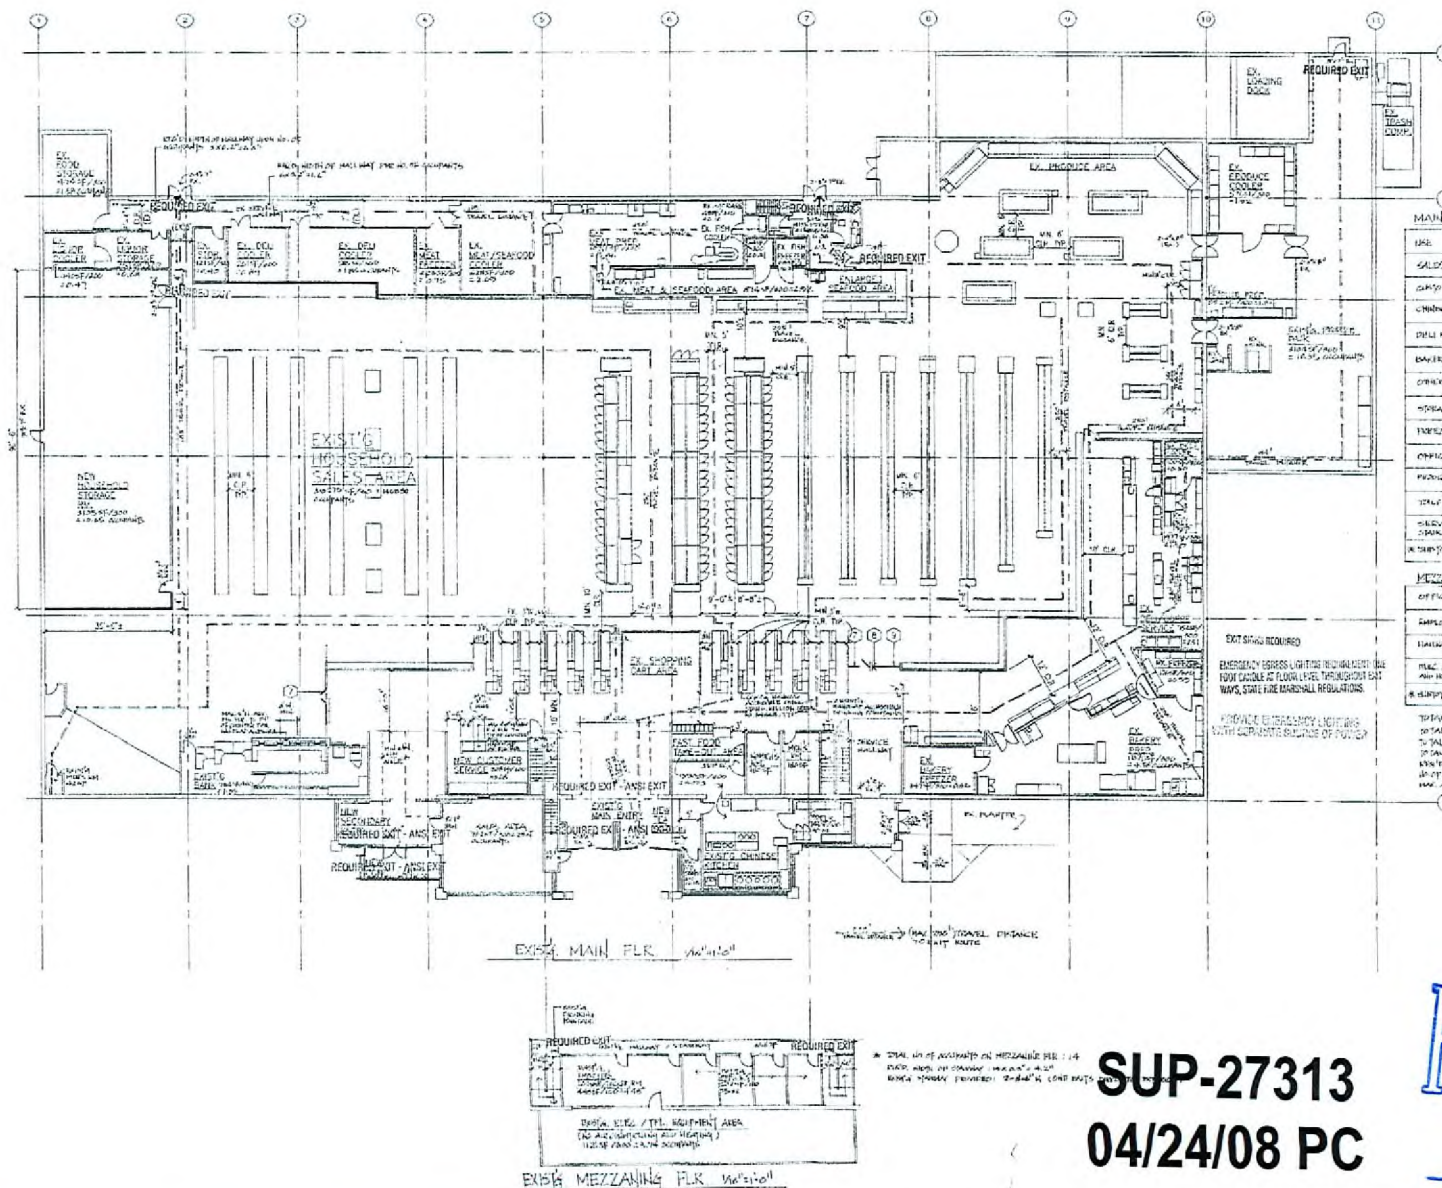

MAIN FLR			



SUP-27313
04/24/08 PC

RECEIVED
MAR 11 2008