



PLANNING & DEVELOPMENT DEPARTMENT

STATEMENT OF FINANCIAL INTEREST

Case Number: **SDR-27195** APN: 139-36-502-003

Name of Property Owner: City of Las Vegas

Name of Applicant: Lamar Outdoor Advertising

Name of Representative: Scott Naftzger

To the best of your knowledge, does the Mayor or any member of the City Council or Planning Commission have any financial interest in this or any other property with the property owner, applicant, the property owner or applicant's general or limited partners, or an officer of their corporation or limited liability company?

☐ Yes

☒ No

If yes, please indicate the member of the City Council or Planning Commission who is involved and list the name(s) of the person or persons with whom the City Official holds an interest. Also list the Assessor's Parcel Number if the property in which the interest is held is different from the case parcel.

City Official: N/A

Partner(s): N/A N/A

APN: N/A

Signature of Property Owner:

Douglas Selby


Print Name:





Douglas Selby

Subscribed and sworn before me

This 29 day of February, 2008

Kviba
Notary Public in and for said County and State

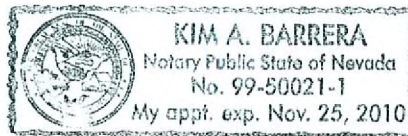

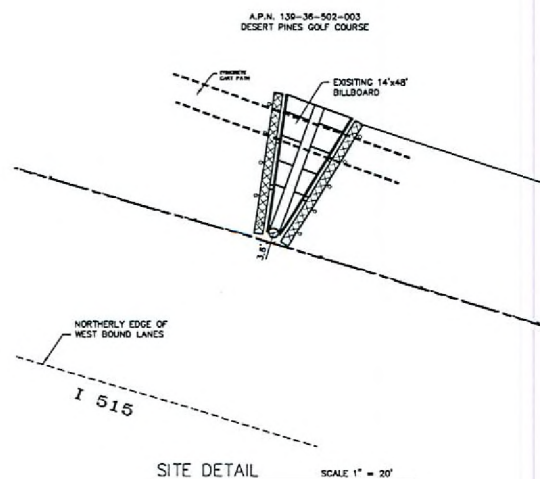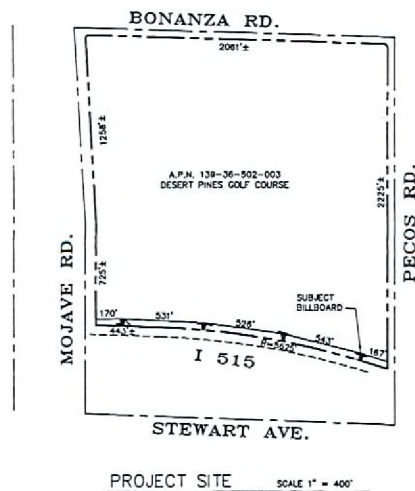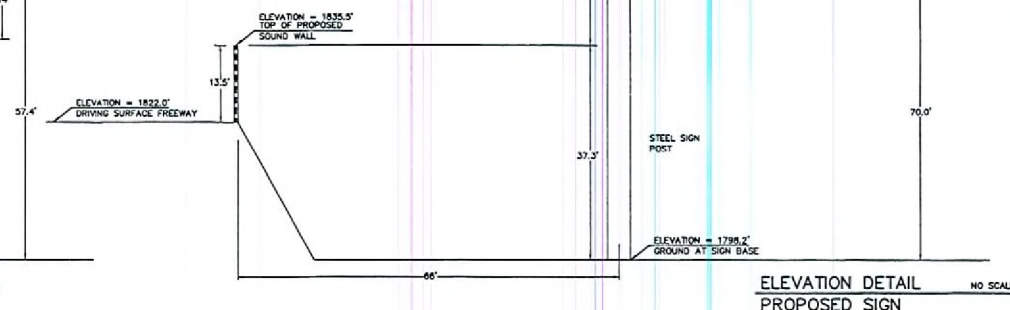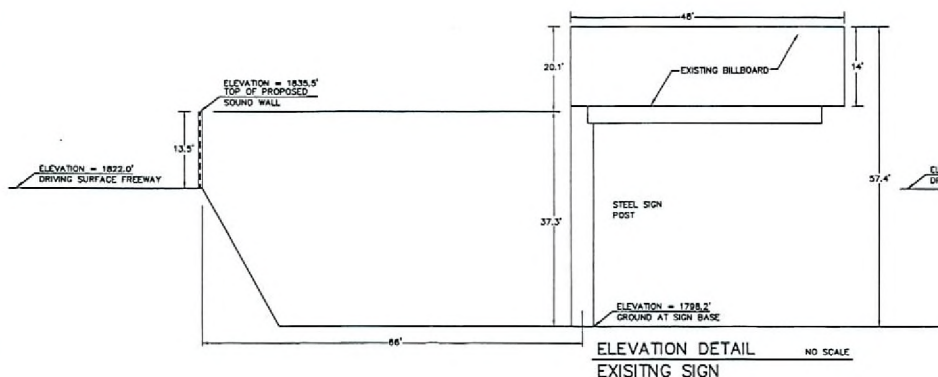

ZONING

C-V CIVIC DISTRICT

GENERAL NOTES

1. NOT WITHIN 300 FOOT RADIUS OF ANOTHER OFF PREMISE BILLBOARD.
2. NOT WITHIN 100 FOOT OF AN ON-PREMISE SIGN ON ADJOINING PROPERTY.
3. NOT WITHIN 300 FOOT RADIUS OF RESIDENTIAL PROPERTY,
4. NO PARKING SPACES WILL BE TAKEN FOR THIS LOCATION,

LAMAR OUTDOOR ADVERTISING
873-4600

OWNER:
CITY OF LAS VEGAS
SITE LOCATION:
3415 E. BONANZA RD.

RECEIVED

MAR 10 2008

SDR-27195
04/24/08 PC

BILLBOARD REVISION PLAN
A.P.N. 159-36-502-003
SECTION 36,
TOWNSHIP 20 SOUTH, RANGE 8 EAST,
COUNTY OF LAS VEGAS, CLARK COUNTY, NEVADA

BAUCHMAN & TURNER, INC.
CIVIL ENGINEERS LAND SURVEYORS LAND PLANNERS
1210 HINSON STREET
LAS VEGAS, NEVADA 89102
(702) 870-8771 Fax (702) 878-3885

SITE PLAN TO ACCOMPANY EXHIBIT A TO SUBLEASE

MOJAVE ROAD

BONANZA ROAD

DESERT PINES GOLF COURSE

PECOS DRIVE

N ↑

Billboard
No. 4

Billboard
No. 3

Billboard
No. 2

Billboard
No. 1

I-515 Freeway
(U.S. Highway 93 & 95)

SDR-27195
04/24/08 PC