



PLANNING & DEVELOPMENT DEPARTMENT

STATEMENT OF FINANCIAL INTEREST

Case Number: ROC-27304 APN: 125-05-510-002

Name of Property Owner: D.R. Horton

Name of Applicant: D.R. Horton

Name of Representative: _____

To the best of your knowledge, does the Mayor or any member of the City Council or Planning Commission have any financial interest in this or any other property with the property owner, applicant, the property owner or applicant's general or limited partners, or an officer of their corporation or limited liability company?

Yes

No

If yes, please indicate the member of the City Council or Planning Commission who is involved and list the name(s) of the person or persons with whom the City Official holds an interest. Also list the Assessor's Parcel Number if the property in which the interest is held is different from the case parcel.

City Official: _____

Partner(s): _____

APN: _____

Signature of Property Owner: 


Print Name: JAMES FRASURE



Subscribed and sworn before me

This 11th day of March, 2008


Barbara A. Bross

Notary Public in and for said County and State

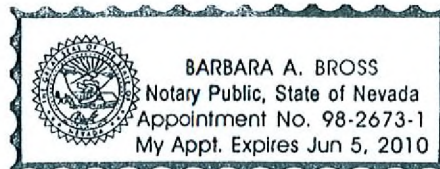

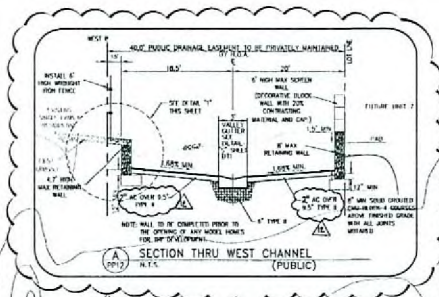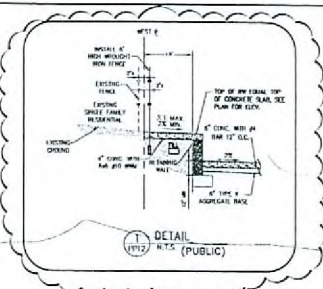

NOTE:
CONTRACTOR TO VERIFY THE HORIZONTAL AND VERTICAL LOCATION OF EXISTING UTILITIES PRIOR TO CONSTRUCTION. REPORT ANY DISCREPANCIES TO ENGINEER IMMEDIATELY.

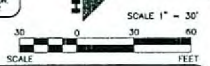

BENCHMARK
CITY OF LAS VEGAS VERTICAL CONTROL
CITY OF LAS VEGAS PIN REFLECTION
1/4" CONCRETE PIN 1000 0 MOCCAMM AND CHAMBERLAIN
ELEVATION: 726.870 METERS (2417.00 FEET)


BASS OF BEARINGS
NORTH 00°27'00" WEST BEING THE BEARING OF THE WEST LINE OF THE NORTHWEST QUARTER (NW 1/4) OF SECTION 4, TOWNSHIP 36 NORTH, RANGE 12 EAST, MERIDIAN OF LAS VEGAS, CLARK COUNTY, NEVADA, AND SOUTHWEST CORNER THEREOF ON FILE IN FILE 100, PAGE 09 OF PARCEL MAPS IN THE CLARK COUNTY RECORDER'S OFFICE, CLARK COUNTY, NEVADA.



Call before you Dig
Under Ground
1-800-227-2600
1-702-452-7611
1-702-220-6611

WEST CHANNEL
(PUBLIC DRAINAGE EASEMENT TO BE PRIVATELY MAINTAINED)

PLAN AND PROFILE
SCALE
HORIZ 1" = 30'
VERT 1" = 3'

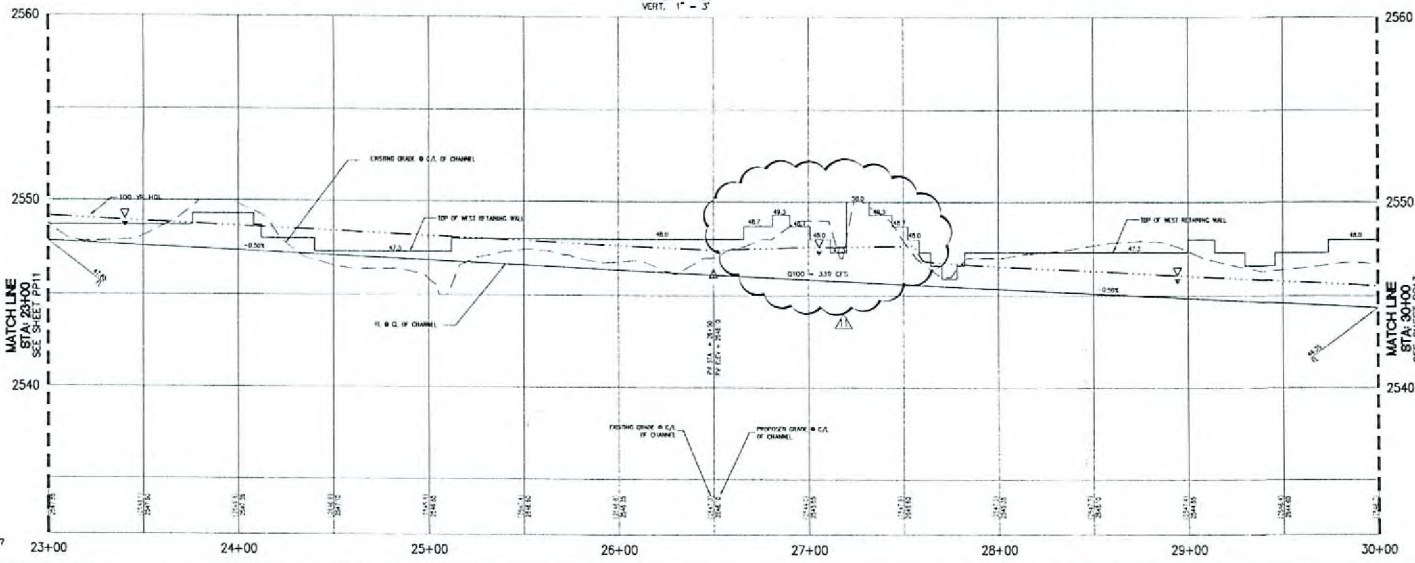

- CONSTRUCTION NOTES
1. CONSTRUCT 12" DIA. DRAIN PER UDDCA DMC 202.
 2. CONSTRUCT 12" DIA. DRAIN PER UDDCA DMC 202.
RECEIVED
MAR 11 2008

DRAINAGE CERTIFICATION
I CERTIFY THIS DRAINAGE PLAN IS IN CONFORMANCE WITH THE APPROVED DRAINAGE STUDY ON FILE WITH THE CITY OF LAS VEGAS FOR THIS PROJECT.
BENJAMIN C. SMITH
12/1/06
1.07 Y 4.234



C.C. WALLACE, INC.
DR. HORTON, INC.
WEST CHANNEL - PLAN AND PROFILE
STA 23+00 - STA 30+00


ROC-27304
06-18-08 CC

MATCH LINE
STA 30+00
SEE SHEET PP12

MATCH LINE
STA 30+00
SEE SHEET PP12

WEST CHANNEL (PUBLIC DRAINAGE EASEMENT TO BE PRIVATELY MAINTAINED)

PLAN AND PROFILE
SCALE
HORIZ. 1" = 30'
VERT. 1" = 3'

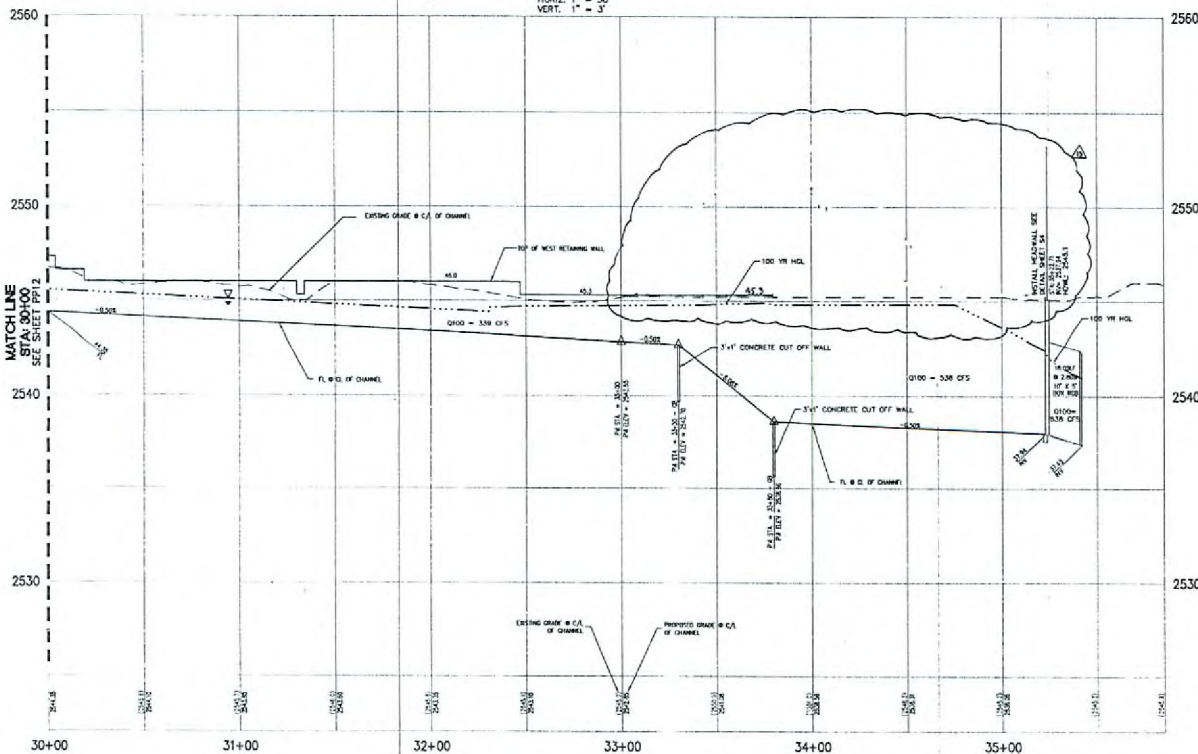


APN 125-05-503-001
BOULEVARD CITY PROPERTIES LLC

MOCCASIN
(PUBLIC)
SEE SHEET PP17



SCALE 1" = 30'
0 30 60
FEET

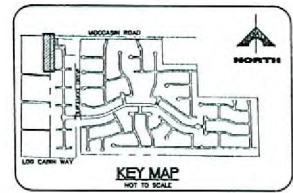

BENCHMARK
CITY OF LAS VEGAS VERTICAL CONTROL,
CORNER OF 1/4 CORNER, BLK 1990 D WOODGATE
AND CHANDLER
ELEVATION: 2483.75 METERS (8148.0)
2483.75 FEET

BASIS OF BEARINGS
NORTH POINTS TO WEST BEING THE BEARING
OF THE WEST LINE OF THE NORTHWEST
QUARTER (SW/4) OF SECTION 4, TOWNSHIP
10 NORTH, RANGE 90 EAST, S.04, CITY OF
LAS VEGAS, CLARK COUNTY, NEVADA, AS
SHOWN BY MAP THEREOF ON FILE IN FILE
NO. PAGE 08 OF PARCEL MAPS IN THE
CLARK COUNTY RECORDER'S OFFICE, CLARK
COUNTY, NEVADA.

NOTE:
CONTRACTOR TO VERIFY THE HORIZONTAL AND VERTICAL
LOCATION OF EXISTING UTILITIES PRIOR TO CONSTRUCTION.
REPORT ANY DISCREPANCIES TO ENGINEER IMMEDIATELY.

- CONSTRUCTION NOTES**
1. CONSTRUCT 1" MIN. DRAIN COVER PER SUDCO DMC #278.
 2. CONSTRUCT 1" PVC DRAIN PER SUDCO DMC #278.
DRAINAGE CERTIFICATION
I CERTIFY THIS DRAINAGE PLAN IS IN CONFORMANCE WITH THE APPROVED
DRAINAGE STUDY ON FILE WITH THE CITY OF LAS VEGAS FOR THIS PROJECT.
Benjamin C. Smith 8141 4/8/05
BENJAMIN C. SMITH P.E. NO. DATE

Call before you Dig
800-227-2800
1-702-229-8611

Call UnderGround
1-702-229-8611

Call before you Dig
800-227-2800
1-702-229-8611

ROC-27304
06-18-08 CC

MAR 11 2008



G.C. WALLACE, INC.
DR. HORTON, INC.
WEST CHANNEL - PLAN AND PROFILE
STA 30+00 - STA 35+22.71

LOG CABIN RANCH - INFRASTRUCTURE
DR. HORTON, INC.
WEST CHANNEL - PLAN AND PROFILE
STA 30+00 - STA 35+22.71

SHEET
PP13
15 OF 69 SHEETS

