

September 16, 2008

Peter Lowenstein, Planning Supervisor
City of Las Vegas Development Services
731 S. Fourth Street
Las Vegas, NV 89101

RE: ROC-29322, SUP-29323 & VAR 29324

Dear Peter,

Nevada Power Company is respectfully requesting that the above items be stricken from the September 25, 2008 Planning Commission Agenda and that this application be rescinded. Nevada Power Company is working with Staff to re-apply for a SUP for a new facility.

Should you have any questions, please feel free to call me at 402-2421.

Thank you for your assistance with this matter.

Sincerely,



Michelle Baltz, SR/WA
Senior Land Use Consultant

Cc: Debbie Sullivan – City of Las Vegas
Edgar Patino - Nevada Power Company

RECEIVED
SEP 16 2008



PLANNING & DEVELOPMENT DEPARTMENT

STATEMENT OF FINANCIAL INTEREST

Case Number: **SUP-29323** APN: 138-09-401-014

Name of Property Owner: Nevada Power Company

Name of Applicant: Nevada Power Company

Name of Representative: Michelle Baltz

To the best of your knowledge, does the Mayor or any member of the City Council or Planning Commission have any financial interest in this or any other property with the property owner, applicant, the property owner or applicant's general or limited partners, or an officer of their corporation or limited liability company?

Yes

No

If yes, please indicate the member of the City Council or Planning Commission who is involved and list the name(s) of the person or persons with whom the City Official holds an interest. Also list the Assessor's Parcel Number if the property in which the interest is held is different from the case parcel.

City Official: _____

Partner(s): _____

APN: _____

Signature of Property Owner: *James R. Saavedra*


Print Name: James R Saavedra

Subscribed and sworn before me

This 5th day of August, 20 05

Michelle Baltz
Notary Public in and for said County and State



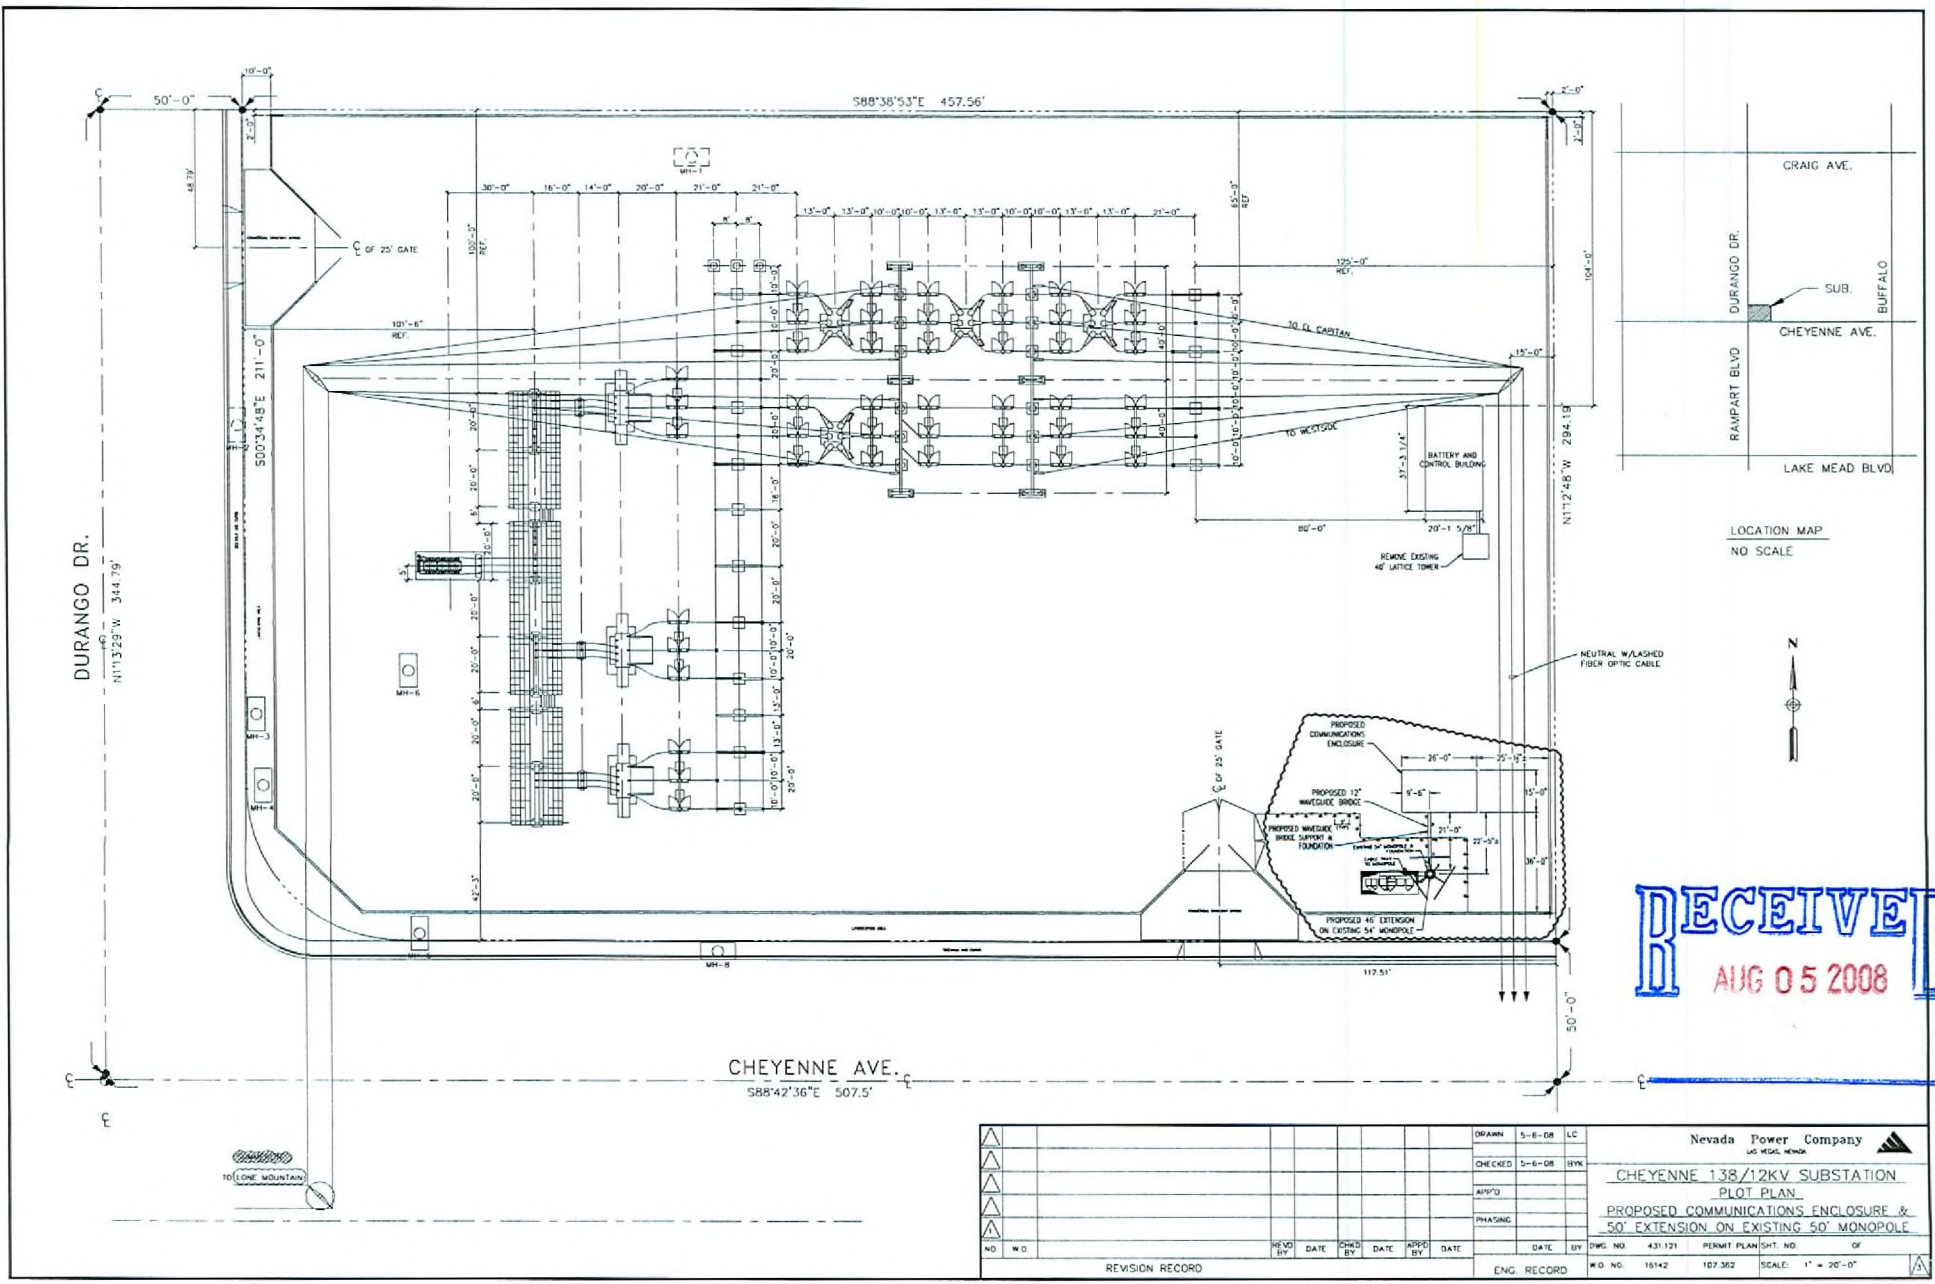


RECEIVED
AUG 05 2008

REVISION RECORD				ENG RECORD			
NO	W.D.	REVISED BY	DATE	CHKD BY	DATE	APPR BY	DATE

DRAWN	5-6-08	LC	Nevada Power Company LAS VEGAS, NEVADA				
CHECKED	5-6-08	BYN	CHEYENNE 138/12KV SUBSTATION PLOT PLAN				
APPROV			PROPOSED COMMUNICATIONS ENCLOSURE & 50' EXTENSION ON EXISTING 54' MONOPOLE				
PHASING							
DATE	BY	DATE	DATE	BY	DATE	DATE	BY

SUP-29323
09/25/08 PC

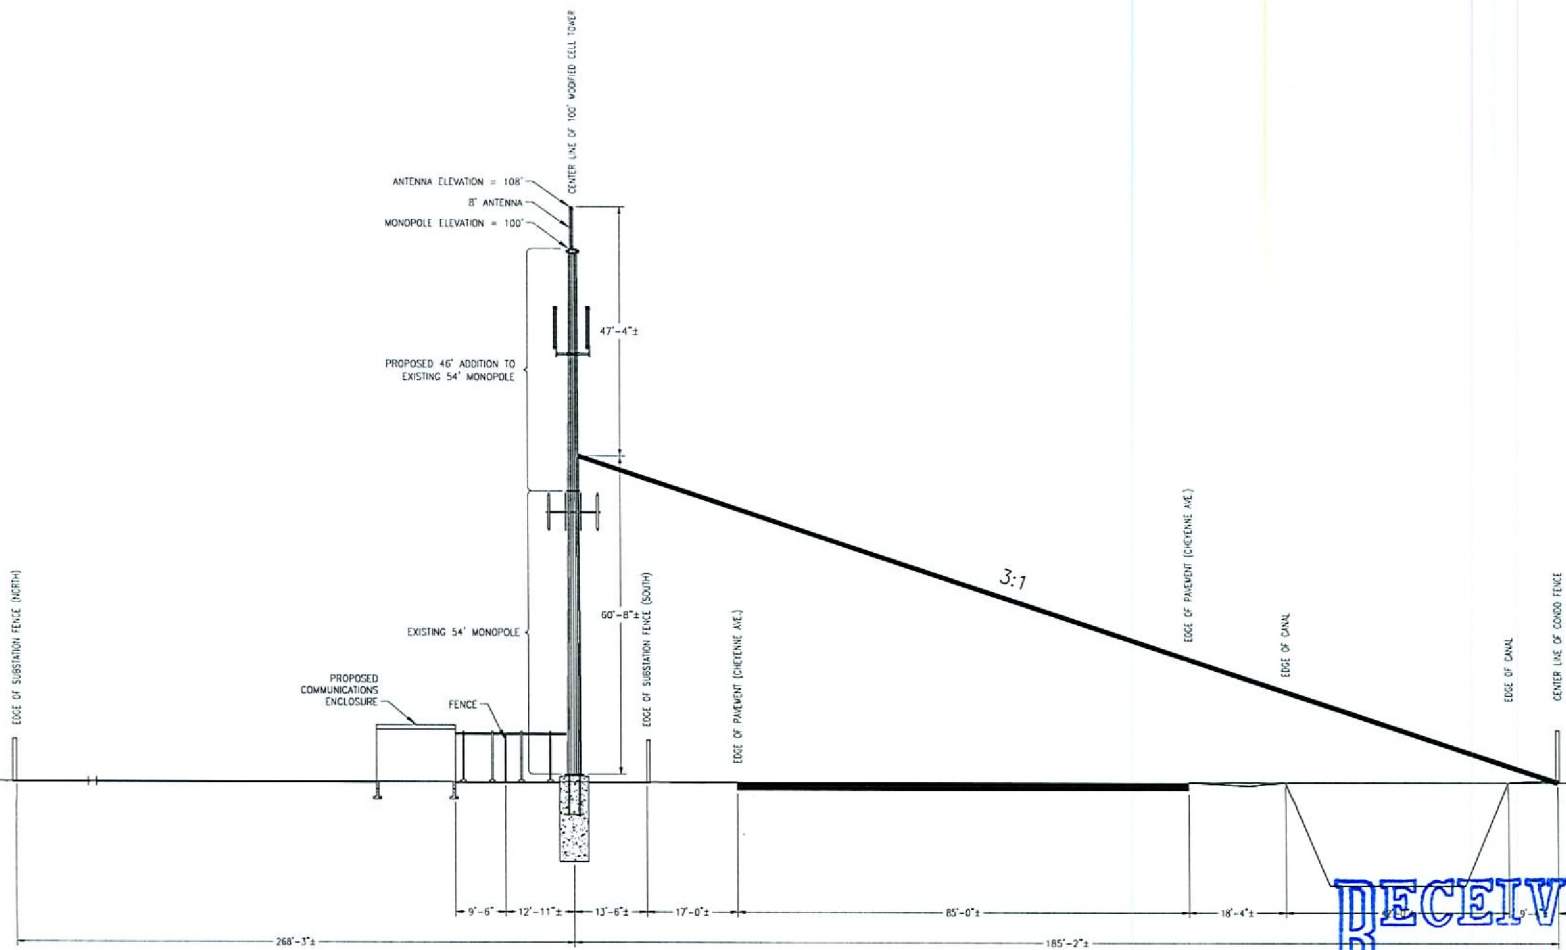

PROPOSED COMMUNICATIONS TOWER @ CHEYENNE SUBSTATION
(LOOKING EAST)

RECEIVED
AUG 05 2008

ALL DIMENSIONAL INFORMATION EXCEPT SUBSTATION TAKEN FROM GOOGLE EARTH

C.I. CO		DRAWN	3-27-08	LC	Nevada Power Company LAS VEGAS, NEVADA												
ACCT. DEPT																	
SURVEY		CHECKED	3-27-08	SWP													
DESIGNED																	
CONSTRUCTION		APP'D	3-27-08	BN	CHEYENNE COMMUNICATIONS EQUIPMENT ENCLOSURE ELEVATION RATIO OF PROPOSED TOWER TO CONDO PROPERTY LINE (FENCE) WITH MODIFIED CELL TOWER												
SUBSTATION																	
PURCHASING		PENDING															
REV. NO.	WORK ORDER	DESCRIPTION	DATE	BY	CHKD	APP'D	TO	J	DATE	DATE	BY	DWG. No.	431.121.E30/PERMIT	SHEET	1	OF	1
REVISIONS												PRINTS ISSUED	ENG. RECORD	APPROVED BY MANAGER TRANSMISSION & DISTRIBUTION FACILITIES	DATE		

SUP-29323
09/25/08 PC