




③ CHAIN LINK FENCE DETAIL
SCALE: 1/2" = 1'-0"

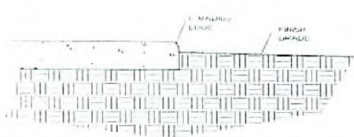


TYP. CONCRETE EDGE
SCALE: 1/2" = 1'-0"

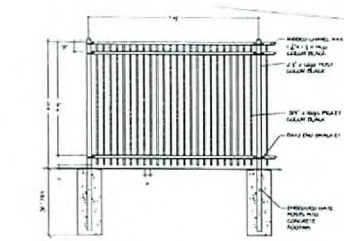


① ORNAMENTAL FENCE NTD

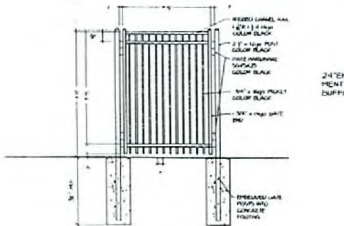

② ORNAMENTAL GATE NTD

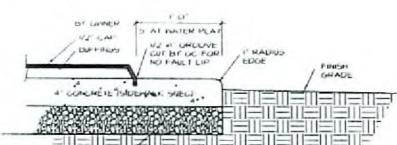


TYP. UNITARY SURFACE DETAIL
SCALE: 1/2" = 1'-0"

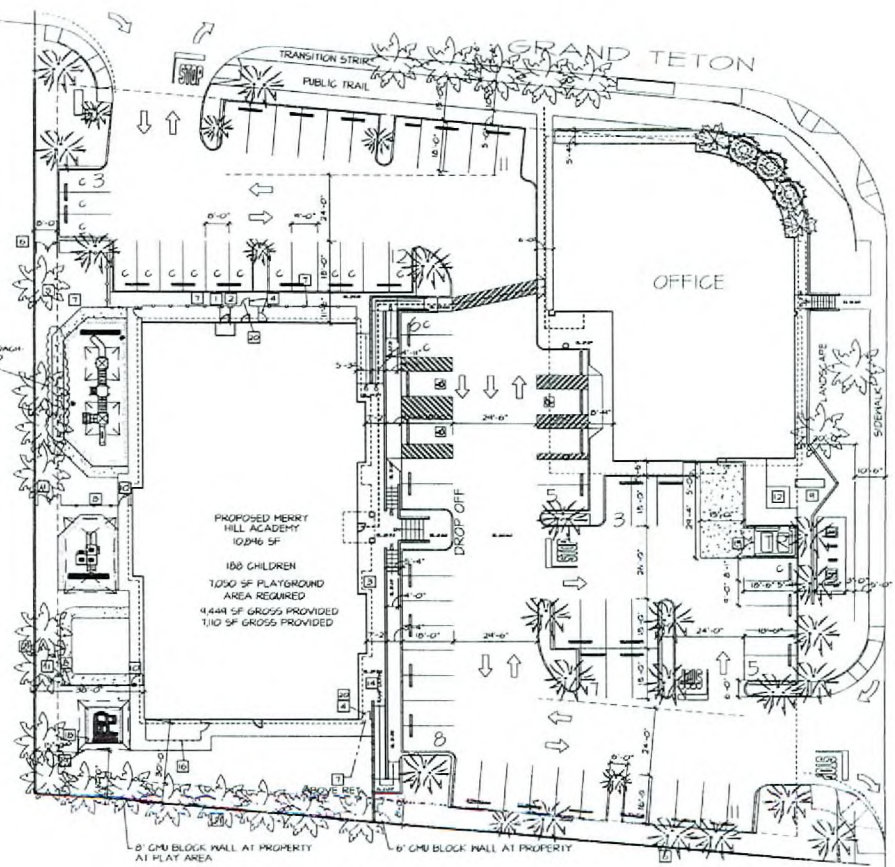

ARCHITECTURAL SITE PLAN
SCALE: 1" = 20'-0"

- KEYNOTES
- ① 1" FIRE LINE & WALL - SEE CIVILS
 - ② CURBSTOP SERVICE - SEE CIVILS
 - ③ MANHOLE LOCATION
 - ④ 6" x 10" x 10" DECORATIVE METAL GATE
 - ⑤ 6" x 10" x 10" DECORATIVE METAL DOUBLE GATE
 - ⑥ MANHOLE SCREENING WALL
 - ⑦ DECORATIVE METAL FENCE - SEE DETAIL UK-1
 - ⑧ 4" x 10" DECORATIVE METAL FENCE - SEE DETAIL UK-1
 - ⑨ MONUMENT SIGN - SEE SHEET SIGN-1
 - ⑩ 6" x 10" x 10" DECORATIVE METAL GATE
 - ⑪ 6" x 10" x 10" DECORATIVE METAL GATE
 - ⑫ PROPOSED TRANSITION LOCATION
 - ⑬ UTILITY LOCATION - SEE E-1
 - ⑭ 1" PVC SANITARY SEWER SERVICE
 - ⑮ DUMPSTER SEE CIVIL DRAWINGS
 - ⑯ 4" x 10" DECORATIVE METAL FENCE - SEE DETAIL UK-1
 - ⑰ GAS METER LOCATION - SEE P-2
 - ⑱ UNITARY PAVEMENT SURFACE - SEE DETAIL THIS SHEET
 - ⑲ CHANGE SHEET FOR VARIATION HEIGHT - LISTING RESOURCES FOR FINISH
 - ⑳ PROVIDER DIAL METER (SEE E-1) & DAN PALMARCH DIV. (SEE E-1) (SEE SHEET FOR DETAILS)

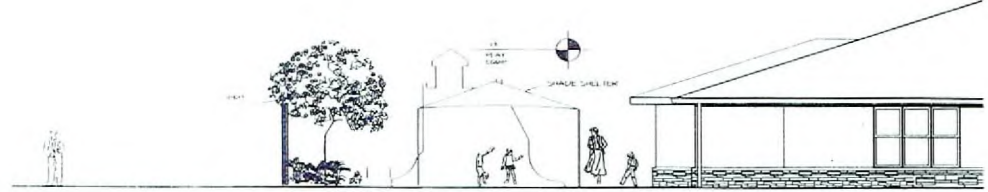

TYPICAL PLAYGROUND SECTION
SCALE: 1/2" = 1'-0"

AN-W-11-1P-4



MERRYHILL
 SCHOOLS
 500 GRAND TETON &
 BUFFALO DRIVE
 LAS VEGAS, NEVADA

Drawing Title
 ARCHITECTURAL
 SITE PLAN

Date: Dwg. No. 08/28/08
 Date: 08/28/08
 Drawing Number
 X-1

Revisions
 1 08/28/08
 2 08/28/08

RECEIVED

AUG 21 2008

Submitted after final agenda
 Date 8-28-08 PC
 Item 18

WVR-28533
 REVISED
 08/28/08 PC