
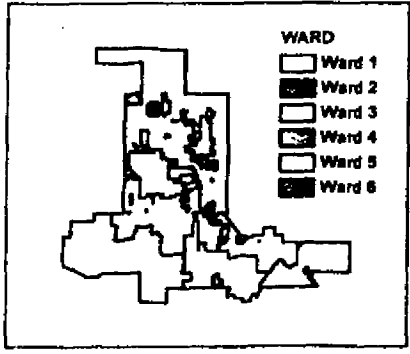
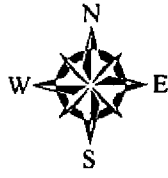


# AMENDMENT FOR BLM GRANT N-75757

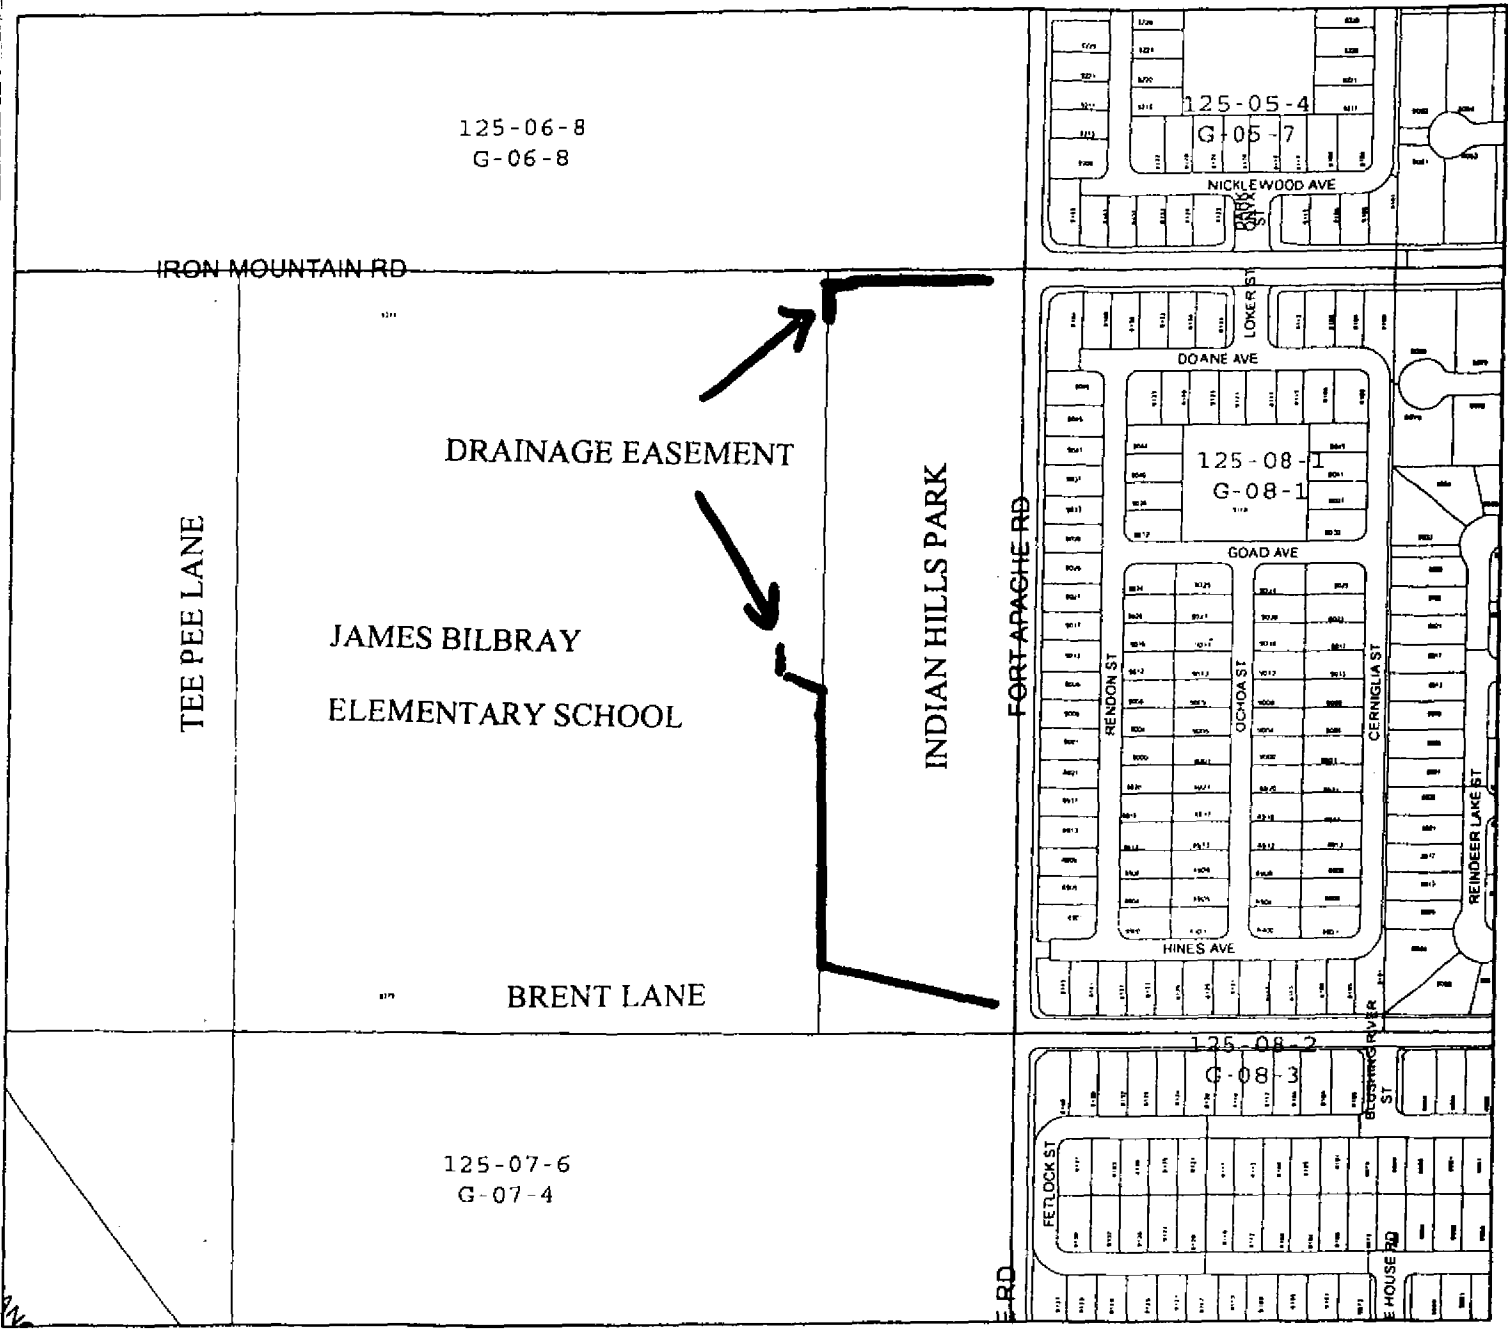

Created by: Right-of-Way 9.2 on Jun 10 2008  
 Due to continuous development activity  
 this map is for reference only.