
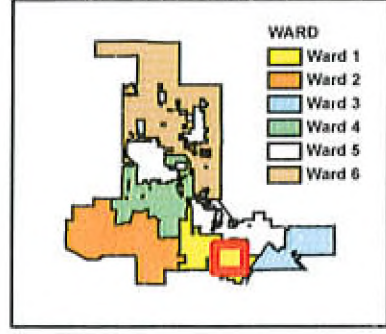
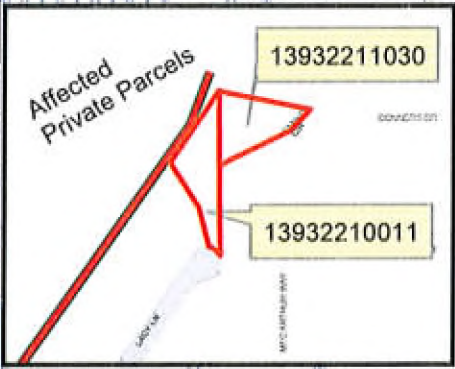


Oakey/Meadows Storm Drain - Phase 1

(Project Boundaries: Sahara Avenue to Alta Drive)

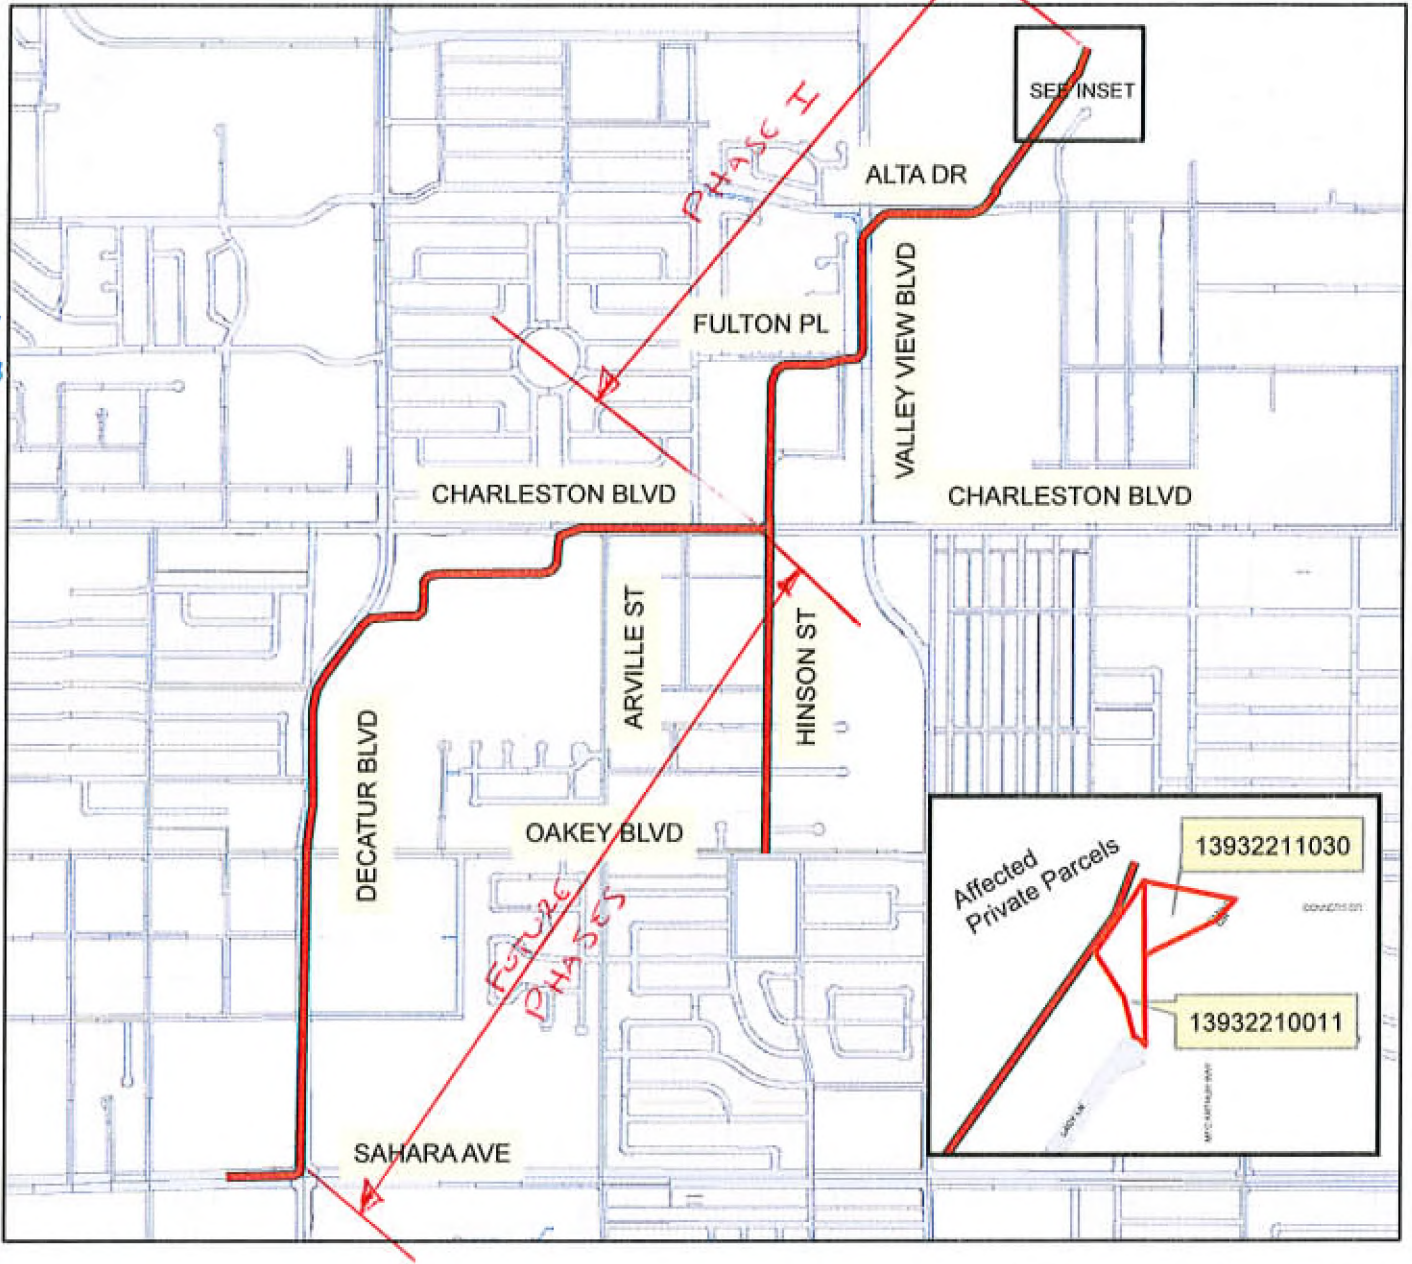

Created by: CLV Right-of-Way on Jun 18 2008

Due to continuous development activity this map is for reference only.