PLANNING & DEVELOPMENT DEPARTMENT

STATEMENT OF FINANCIAL INTEREST

Case Number: DIR-28776 APN: 162-06-603-015, 162-06-603-005.

Name of Property Owner: ERIC HINDS - VEGAS SENIOR HOUSING, Valley View LLC

Name of Applicant: NATURE WORKS

Name of Representative: JESSICA MACKIE

To the best of your knowledge, does the Mayor or any member of the City Council or Planning Commission have any financial interest in this or any other property with the property owner, applicant, the property owner or applicant's general or limited partners, or an officer of their corporation or limited liability company?

_____ Yes __X__ No

If yes, please indicate the member of the City Council or Planning Commission who is involved and list the name(s) of the person or persons with whom the City Official holds an interest. Also list the Assessor's Parcel Number if the property in which the interest is held is different from the case parcel.

City Official: _____

Partner(s): _____ _____

APN: _____

Signature of Property Owner: Eric Hinds

Print Name: ERIC HINDS

Subscribed and sworn before me

This 19th day of June, 2008

Notary Public in and for said County and State - Lake County, Illinois

OFFICIAL SEAL
ANNETTE SURITZ
Notary Public - State of Illinois
My Commission Expires May 16, 2011

SOUTHERN NEVADA WATER AUTHORITY
100 City Parkway, Suite 700 • Las Vegas, NV 89106
MAILING ADDRESS: P.O. Box 99956 • Las Vegas, NV 89193-9956
(702) 862-3400 • snwa.com

June 25, 2008

To whom it may concern:

The Las Vegas Valley Water District (for the Southern Nevada Water Authority) received checks for the following:

$2,735 for Destinations at Pueblo
$1,400 for Destinations at Sandhill

The amounts above are tendered to the Southern Nevada Water Authority for Decorative Water Features Fees.

Employee Signature

Toby Bickmore for Doug Bennett

Employee Name

Acting Conservation Manager

Employee Title

DIR-28776
08-06-08 CC

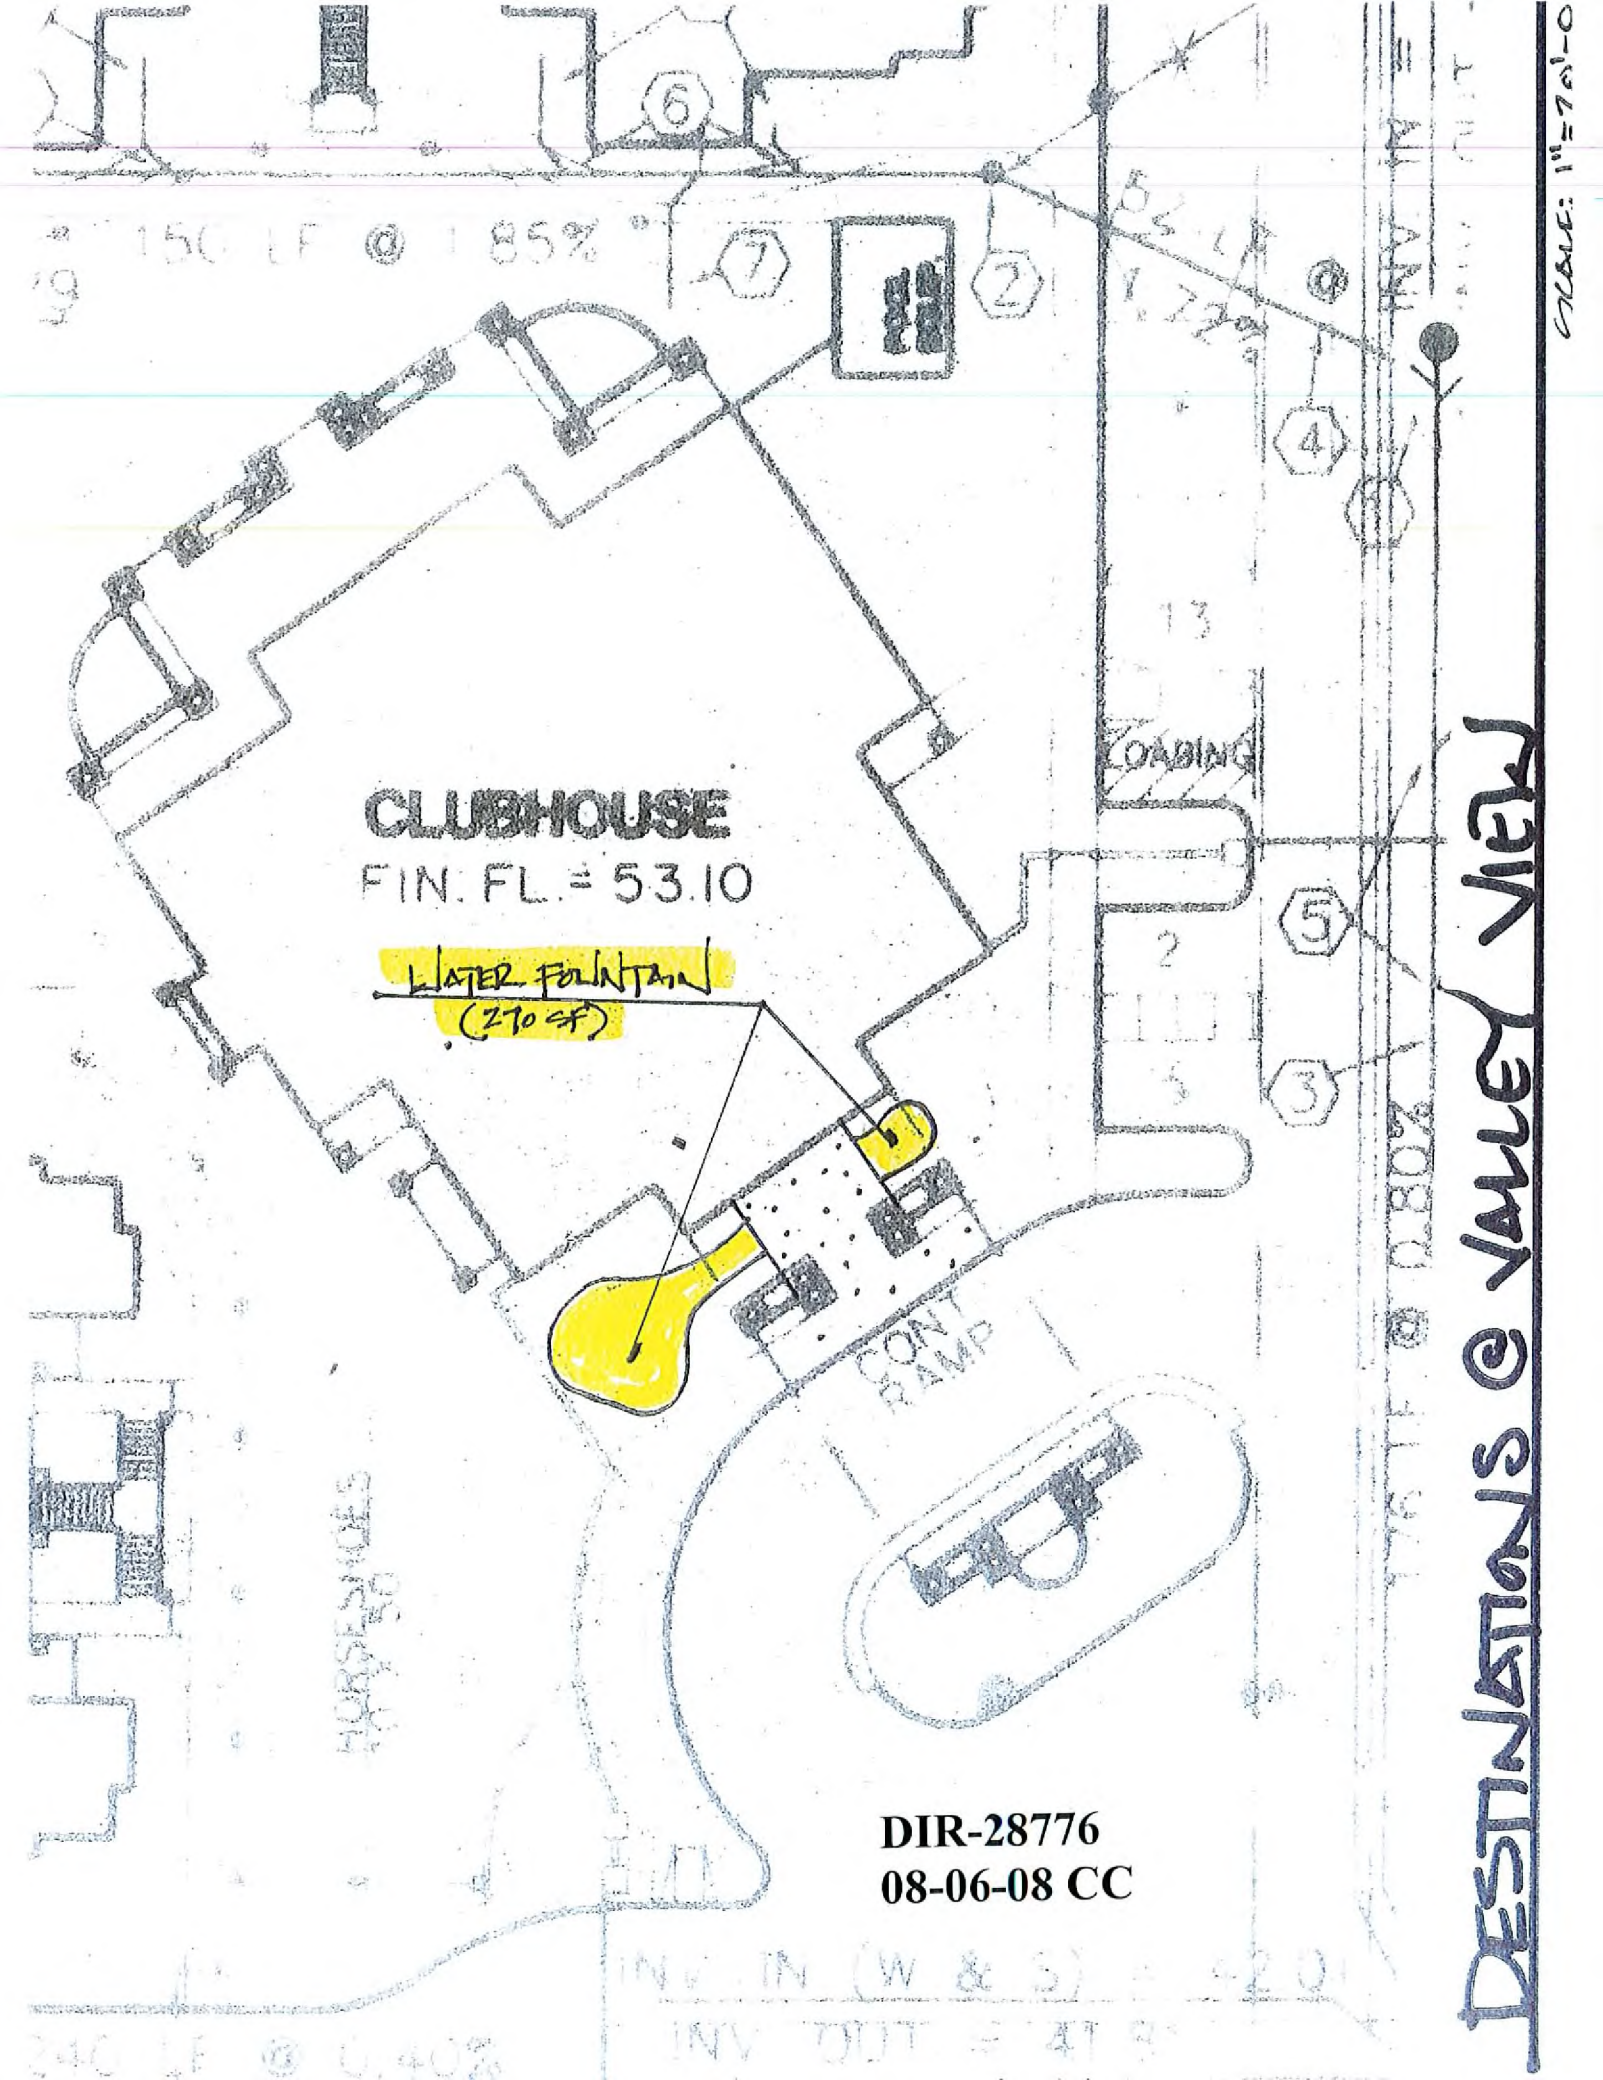

DIR-28776
08-06-08 CC

DIR-28776
08-06-08 CC

DIR-28776
08-06-08 CC