



SOUTHERN NEVADA WATER AUTHORITY

100 City Parkway, Suite 700 • Las Vegas, NV 89106
MAILING ADDRESS: P.O. Box 99956 • Las Vegas, NV 89193-9956
(702) 862-3400 • snwa.com

June 25, 2008

To whom it may concern:

The Las Vegas Valley Water District (for the Southern Nevada Water Authority) received checks for the following:

\$2,735 for Destinations at Pueblo
\$1,400 for Destinations at Sandhill

The amounts above are tendered to the Southern Nevada Water Authority for Decorative Water Features Fees.

Employee Signature


Toby Bickmore for Doug Bennett

Employee Name

Acting Conservation Manager

Employee Title

DIR-28776
08-06-08 CC

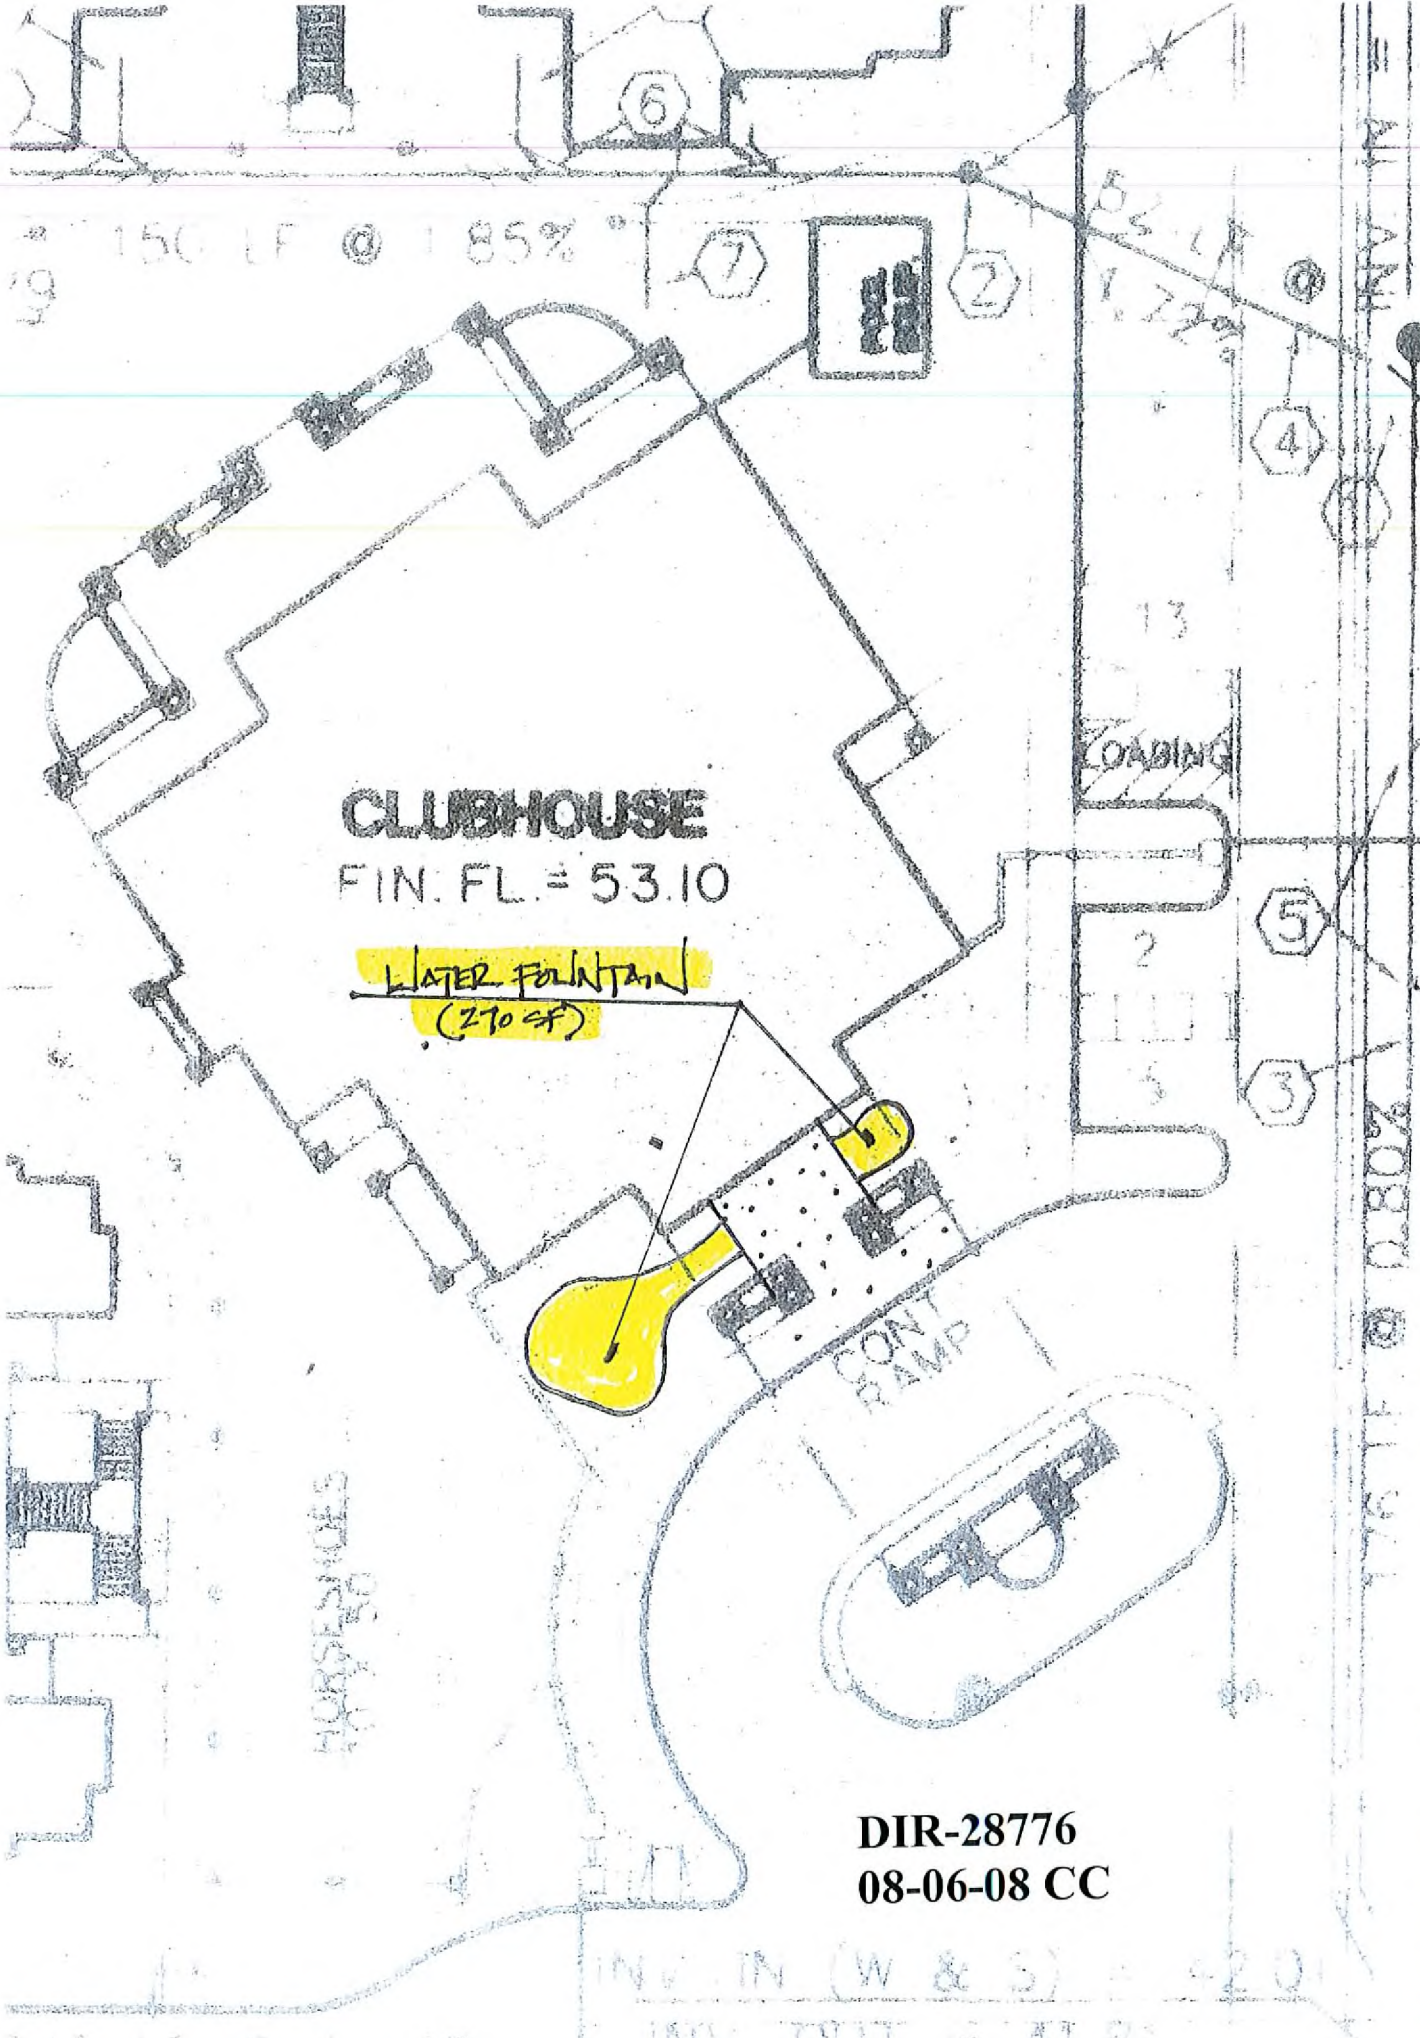

CLUBHOUSE
FIN. FL. = 53.10

WATER FOUNTAIN
(270 SF)

LOADING


CONT.
RAMP

HORSESHOES

DIR-28776
08-06-08 CC

DESTINATIONS @ VALLEY VIEW

SCALE: 1" = 70'-0"

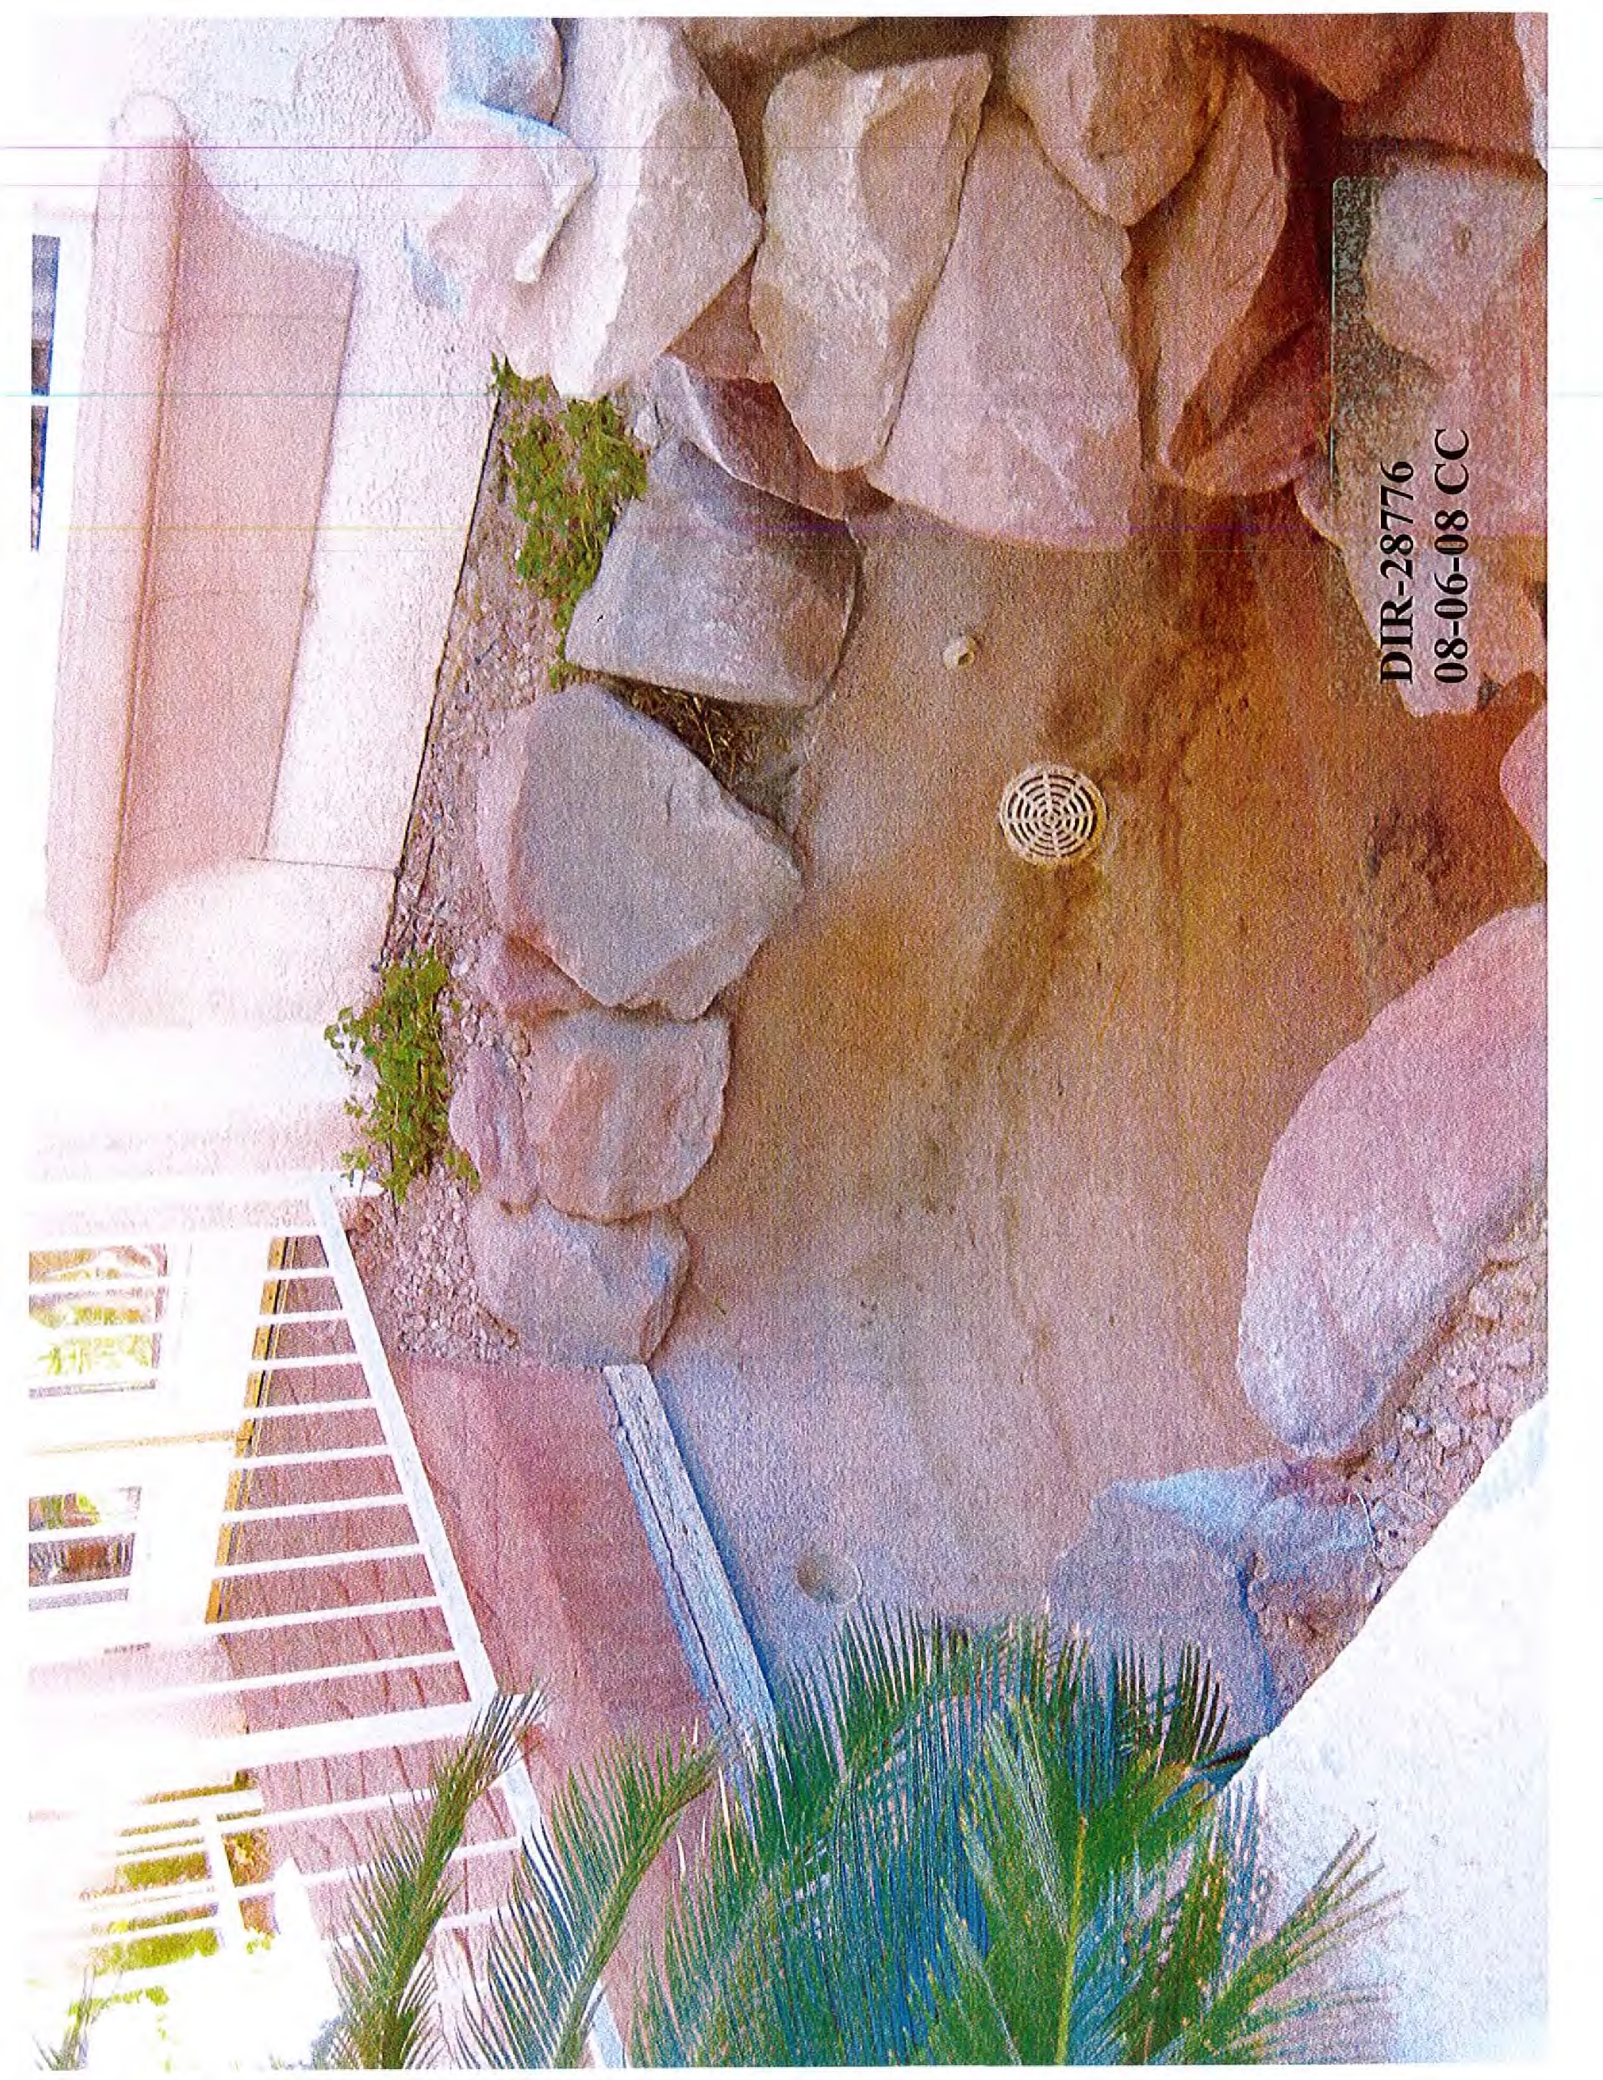

DIR-28776
08-06-08 CC



DIR-28776
08-06-08 CC