


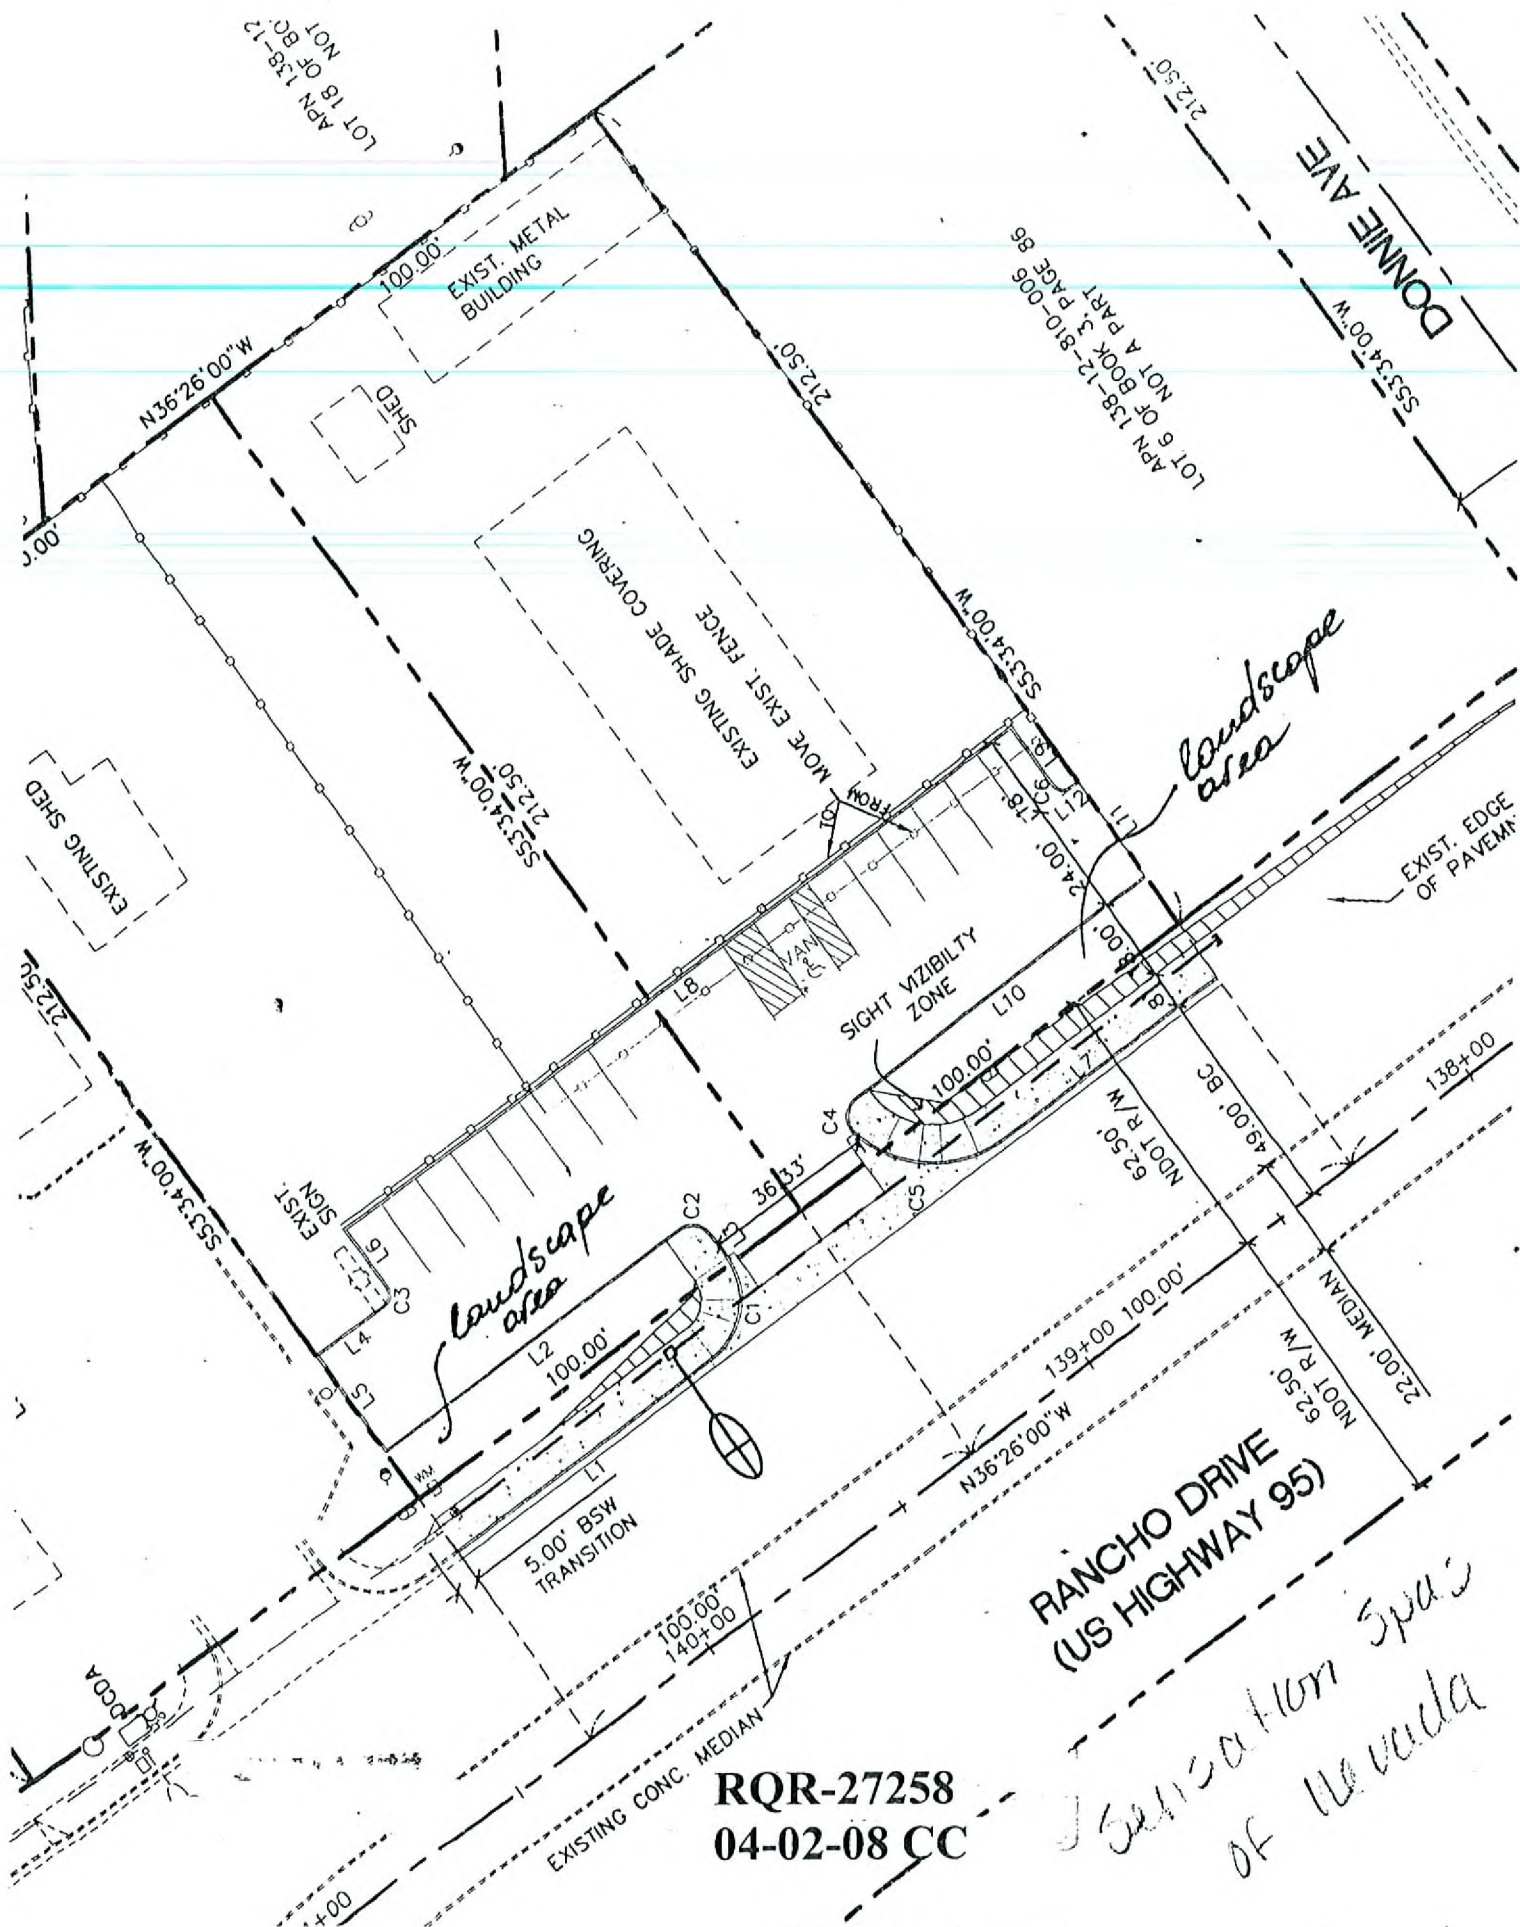

RQR-27258

04-02-08 CC

RANCHO DRIVE
(US HIGHWAY 95)

Sanitation Spas
of Nevada



RQR-27258
04-02-08 CC