

**PLANNING & DEVELOPMENT DEPARTMENT****STATEMENT OF FINANCIAL INTEREST**Case Number: DIR-29019 APN: 138-18-821-009Name of Property Owner: Sunshine Holding

Name of Applicant: _____

Name of Representative: Nora Armenian

To the best of your knowledge, does the Mayor or any member of the City Council or Planning Commission have any financial interest in this or any other property with the property owner, applicant, the property owner or applicant's general or limited partners, or an officer of their corporation or limited liability company?

_____ Yes

_____ ☒ No

If yes, please indicate the member of the City Council or Planning Commission who is involved and list the name(s) of the person or persons with whom the City Official holds an interest. Also list the Assessor's Parcel Number if the property in which the interest is held is different from the case parcel.

City Official: _____


Partner(s): _____

APN: _____

Signature of Property Owner: N. ArmenianPrint Name: Nora Armenian

Subscribed and sworn before me

This 12th day of June, 2008Clark NV Lois Sanders
Notary Public in and for said County and State

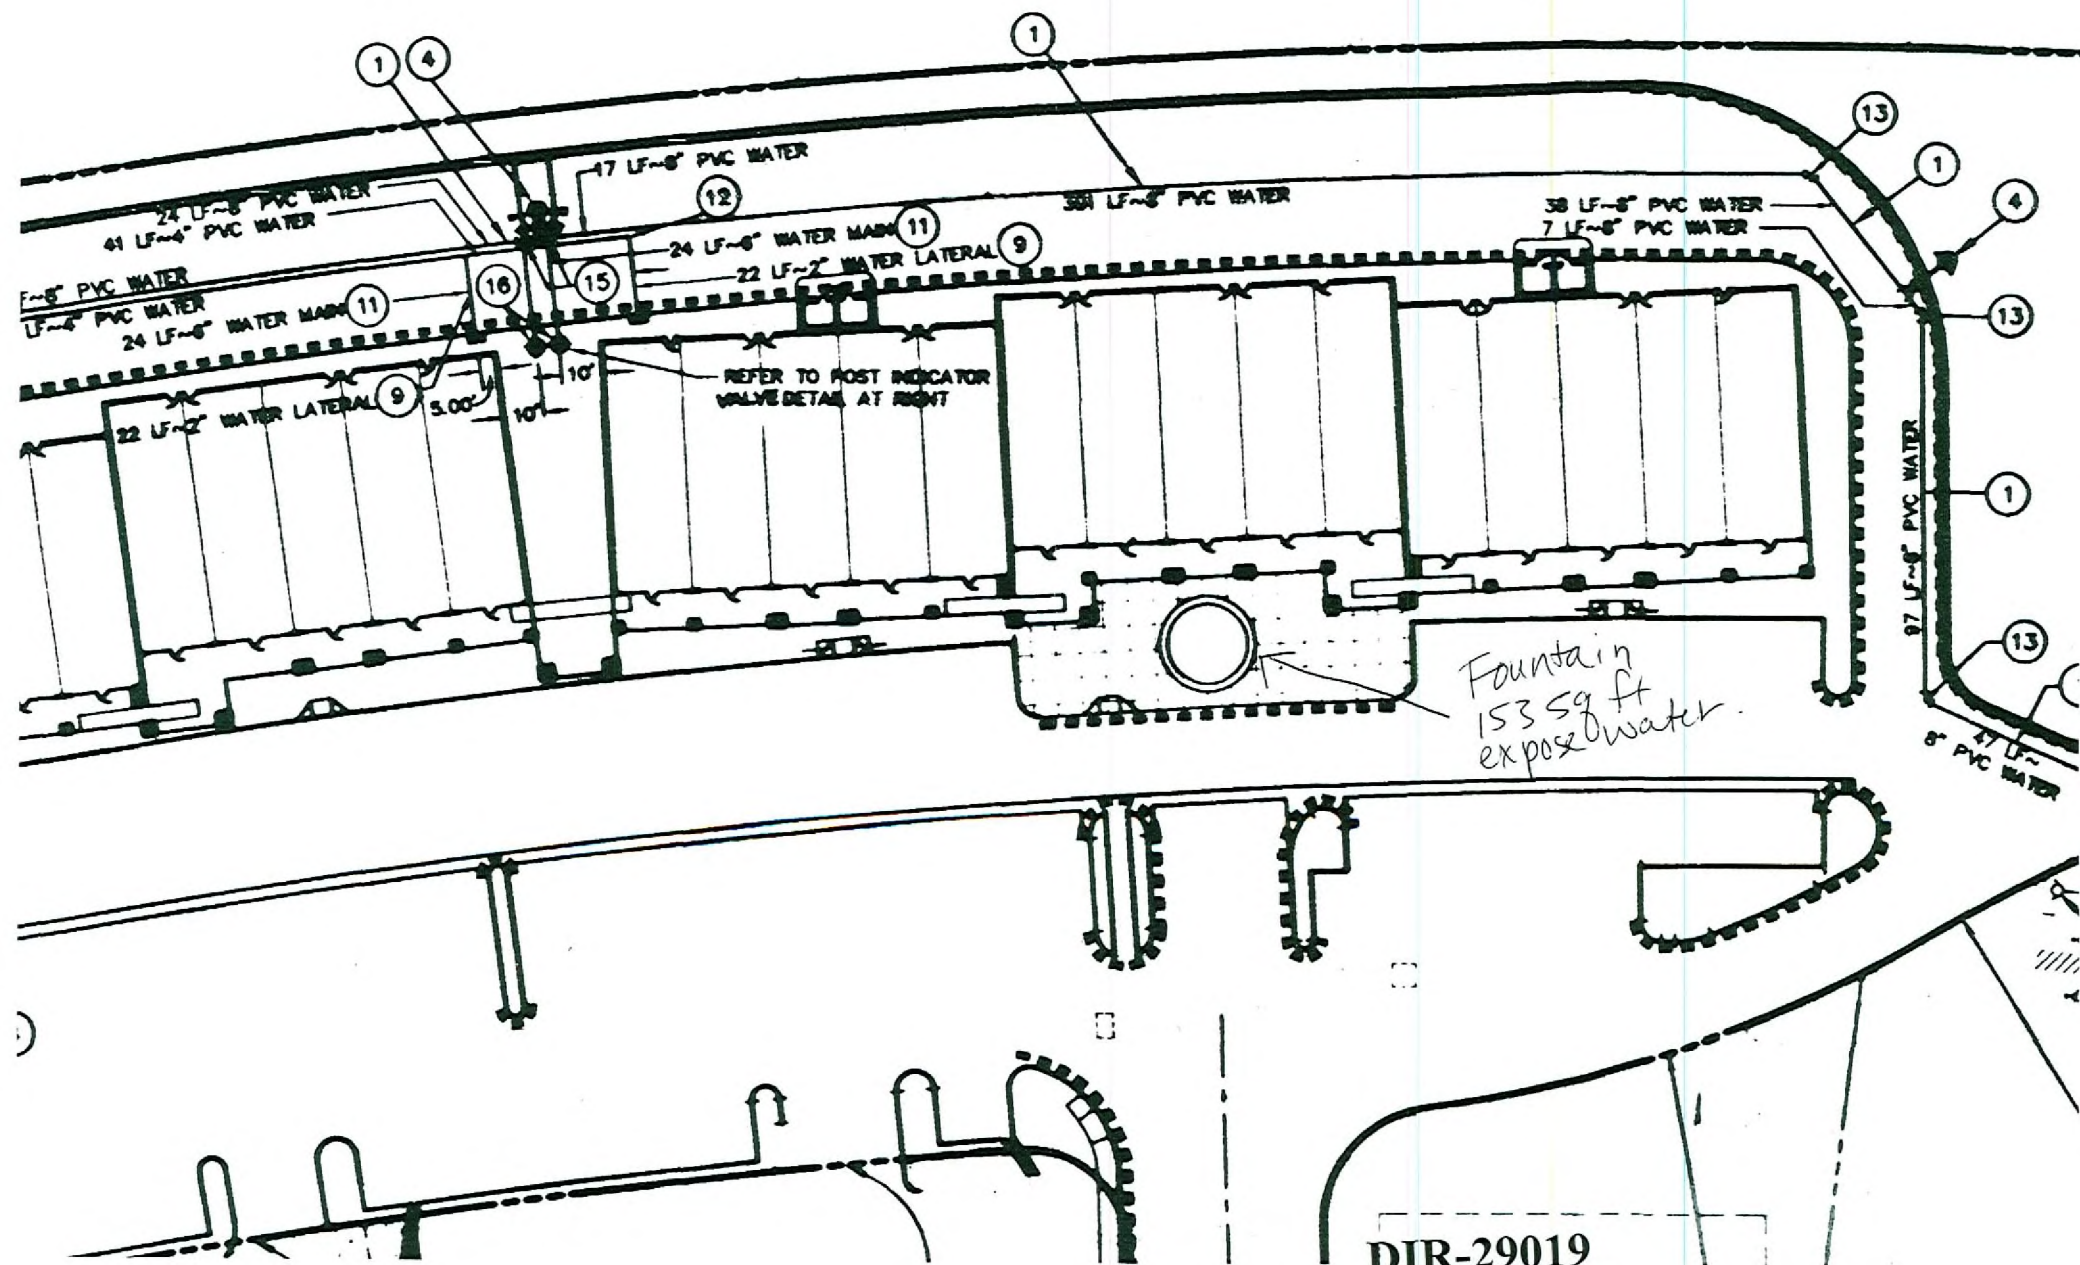

DIR-29019
08-20-08 CC

Sprint Picture Mail

Learn About the Service


New Picture Phones

New Service Features

Groups

Service Options


You have new Picture Mail!

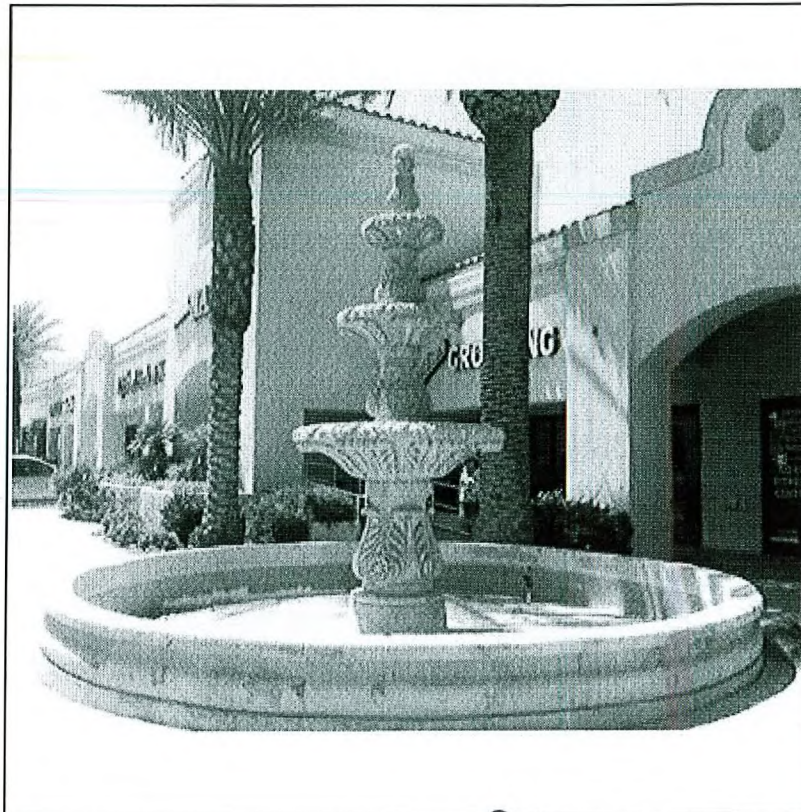

153 sq ft.
expose water.



1 of 1

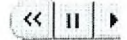

Slow



Done

[Contact Us](#) | [Privacy Policy](#) | [Security](#) | [Copyright Notices](#) | [Terms & Conditions](#) | [Find a Store](#)

© 2008 Sprint. All rights reserved.



DIR-29019
08-20-08 CC