PLANNING & DEVELOPMENT DEPARTMENT

STATEMENT OF FINANCIAL INTEREST

Case Number: ROC-29347 APN: 162-03-801-136

Name of Property Owner: Sharon Kea

Name of Applicant: Sharon Kea

Name of Representative: Raymond L. Cordova

To the best of your knowledge, does the Mayor or any member of the City Council or Planning Commission have any financial interest in this or any other property with the property owner, applicant, the property owner or applicant's general or limited partners, or an officer of their corporation or limited liability company?

_____ Yes XX No

If yes, please indicate the member of the City Council or Planning Commission who is involved and list the name(s) of the person or persons with whom the City Official holds an interest. Also list the Assessor's Parcel Number if the property in which the interest is held is different from the case parcel.

City Official: _____

Partner(s): _____ _____

APN: _____

Signature of Property Owner: Sharon Kea

Print Name: Sharon Kea

Subscribed and sworn before me

This 28th day of June, 2008

Notary Public in and for said County and State

MOON C. LEE
COMM. #1611408
NOTARY PUBLIC - CALIFORNIA
ORANGE COUNTY
My Comm. Expires Nov. 4, 2009

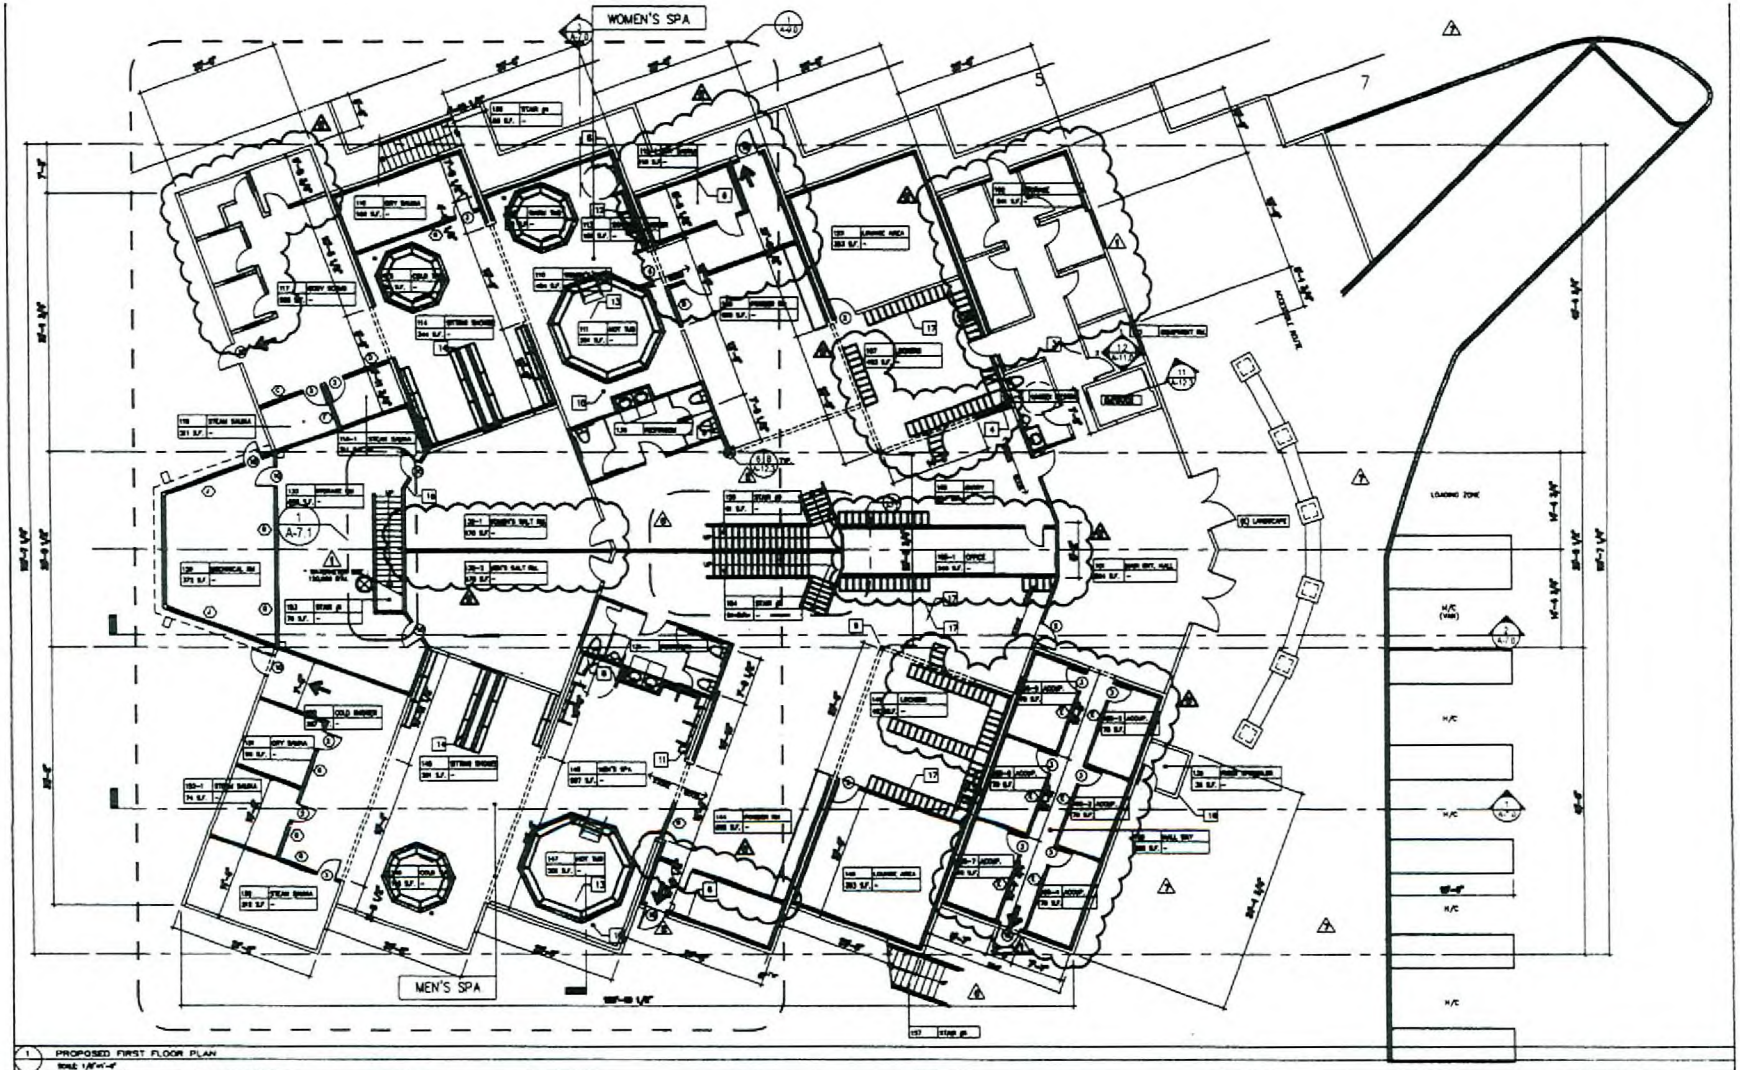

1 PROPOSED FIRST FLOOR PLAN
SCALE: 1/8"=1'-0"

KEY NOTES

1. (N)DOOR
2. (N)COUNTER - SEE DETAIL : A-11.0 / 1
3. NEW ADA COMPLIED H/C COUNTER MIN. 36" WIDER & MAX. 34" HT.
4. WOMAN'S SHOES RACK
5. MEN'S SHOES RACK
6. MIRROR W/ALUM. FRAME
7. PONDER COUNTER-MAPLE WOOD VENEER FINISHED W/ STONE TOP FINISH.
8. H/C COMPLIED SHOWER, SEE : A-13.1 / 11
9. (E) COLUMN TO BE REMAIN
10. ADA SWING LIFT HOLE W/ SST. COVER
11. DRINKING FOUNTAINS
12. STANDING SHOWER, SEE : A-10.1 / 1
13. HOT TUB, SEE : A-10.2 / 2
14. SITTING SHOWER, SEE : A-10.0 / 1
15. -
16. 1-HR CONSTRUCTION
17. LOCKERS
18. SHOES RACK
19. (E) COLUMN TO BE REMAIN
20. (E) COLUMN TO BE REMAIN

ALL CLV COMMENTS ON APPROVED PLAN DATED MAY 17, 2005 TO REMAIN VALID AND WILL FORM PARTS OF THIS RESUBMITTAL.

LEGENDS:
- : EXISTING WALL TO REMAIN
- : NEW PARTITION WALL TO INSTALL, SEE DETAIL A-12.3 / 14
- : NEW 1-HR RATED FULL HEIGHT WALL, SEE DETAIL A-12.3 / 9
- : EXISTING WALL DEMOLISHED

PROPOSED
IMPERIAL SPA AT LAS VEGAS
1070 E. SAHARA AVE.
LAS VEGAS, NV 89104

PROPOSED
FIRST FLOOR PLAN

DATE: JAN. 2, 2008

A-4.0

ROC-29347
09/03/08 CC

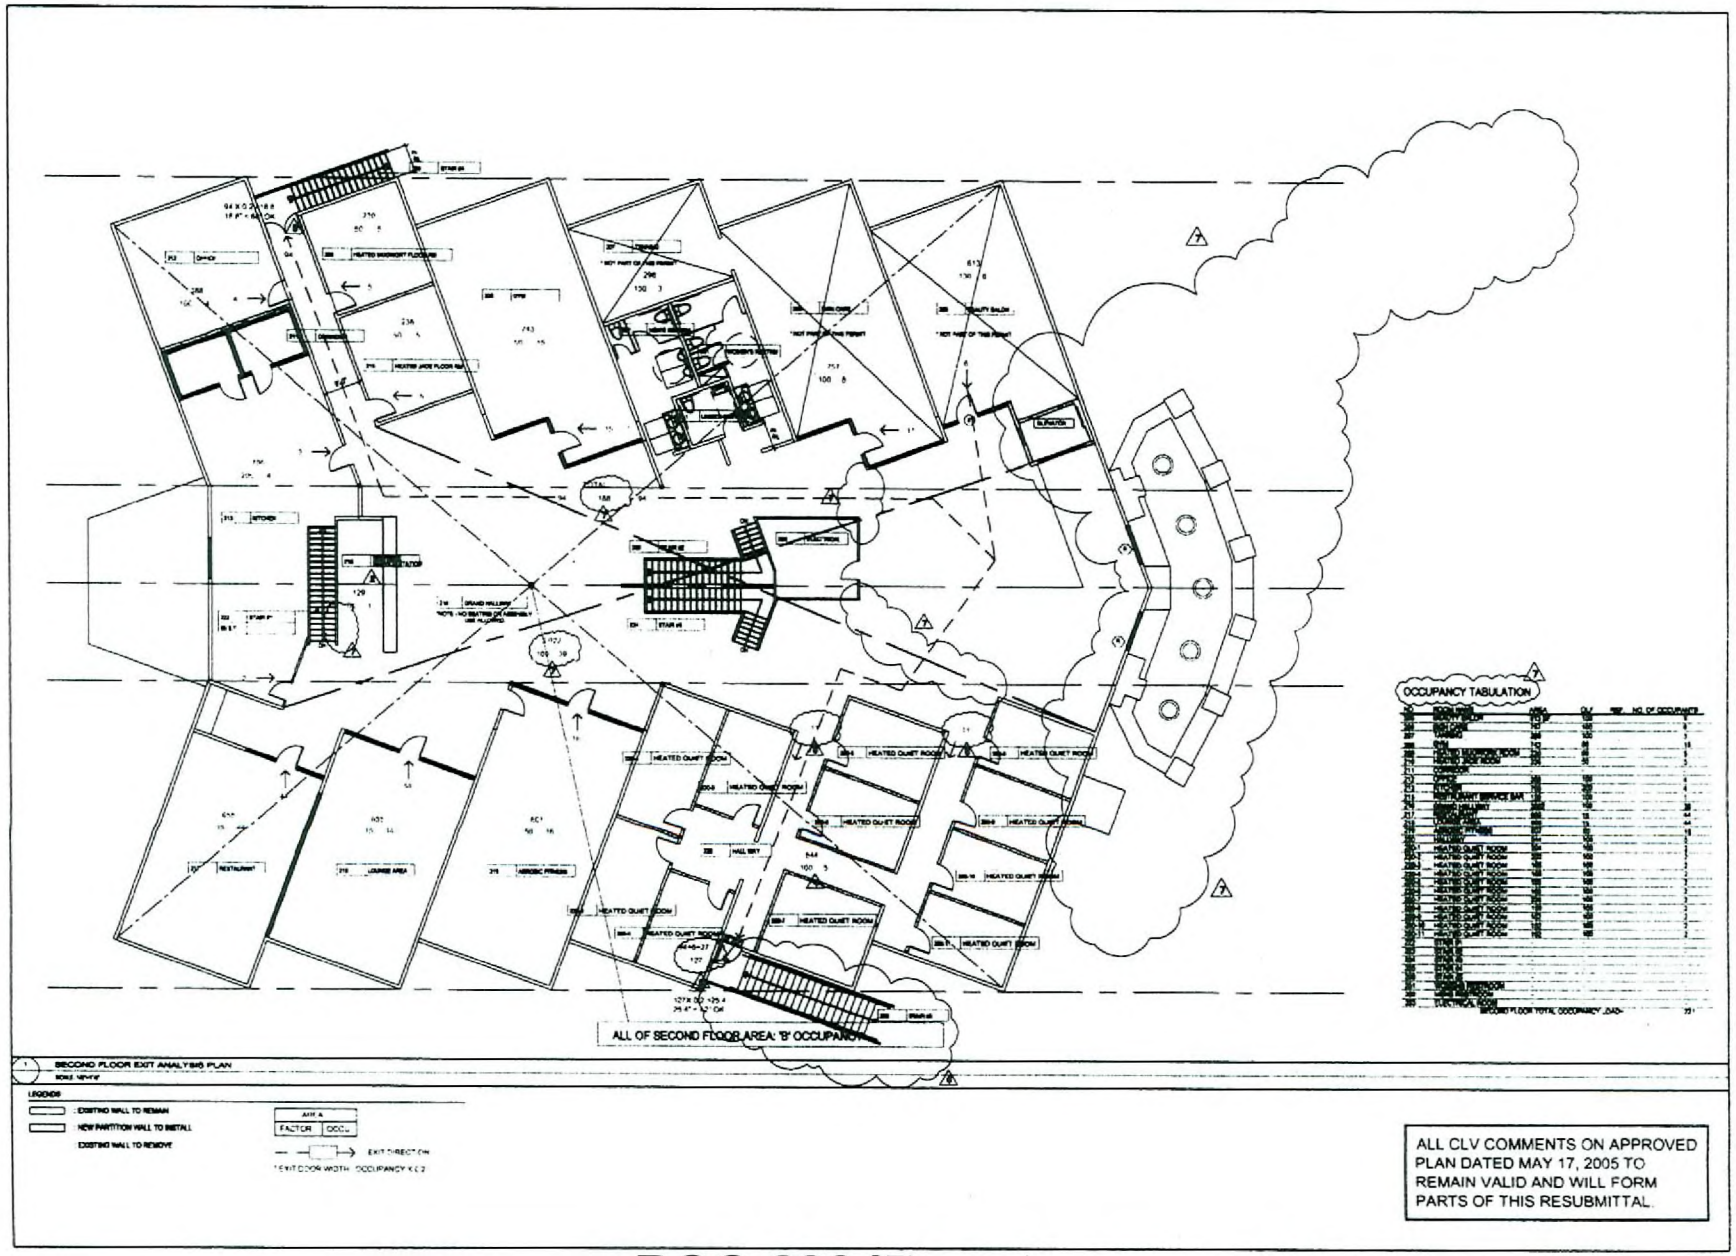

ALL CLV COMMENTS ON APPROVED PLAN DATED MAY 17, 2005 TO REMAIN VALID AND WILL FORM PARTS OF THIS RESUBMITTAL.

PROPOSED
IMPERIAL SPA AT LAS VEGAS
1070 E. SAHARA AVE
LAS VEGAS, NV 89104

SECOND FLOOR
EXIT ANALYSIS PLAN

A-2.2

ROC-29347
09/03/08 CC