

1 SQUARE
= 4 FT.

DONALD RD.

74.76

BACK YARD
.234 ACRE

EXISTING
HOUSE
2387 \square

NEW
GARAGE
406 \square

EXISTING
GARAGE
625 \square

PARKING

PARKING

WALK WAY

95.50

WILD THYME AVE.

VAR-29604
10/09/08 PC
REVISED

ELKORN RD.


DECATUR BLVD.

CELADINE

BRADLEY RD.

SFD

SFD

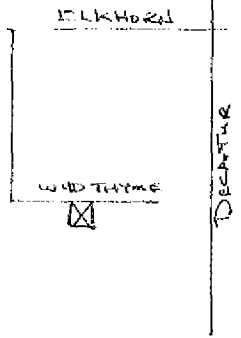

RECEIVED

VAR-29604
10/09/08 PC

Example
9927 Wild Thyme

