



PLANNING & DEVELOPMENT DEPARTMENT

STATEMENT OF FINANCIAL INTEREST

Case Number: **RQR-30484** APN: 138-03-701-003

Name of Property Owner: Craig 95, LLC

Name of Applicant: Lamar Outdoor Advertising

Name of Representative: _____

To the best of your knowledge, does the Mayor or any member of the City Council or Planning Commission have any financial interest in this or any other property with the property owner, applicant, the property owner or applicant's general or limited partners, or an officer of their corporation or limited liability company?

Yes No

If yes, please indicate the member of the City Council or Planning Commission who is involved and list the name(s) of the person or persons with whom the City Official holds an interest. Also list the Assessor's Parcel Number if the property in which the interest is held is different from the case parcel.

City Official: _____

Partner(s): _____

APN: _____


Signature of Property Owner: *[Handwritten Signature]*


Print Name: Alireza Kaveh

Subscribed and sworn before me

This 10th day of October, 2009
[Handwritten Signature]



Notary Public in and for said County and State

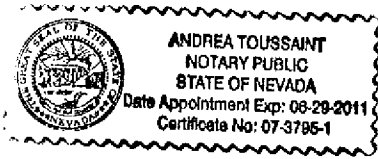

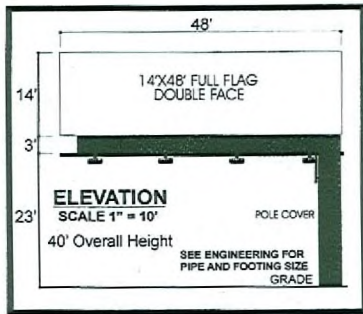


CRAIG ROAD

**TOP VIEW
SCALE 1" = 40'
DETAIL**

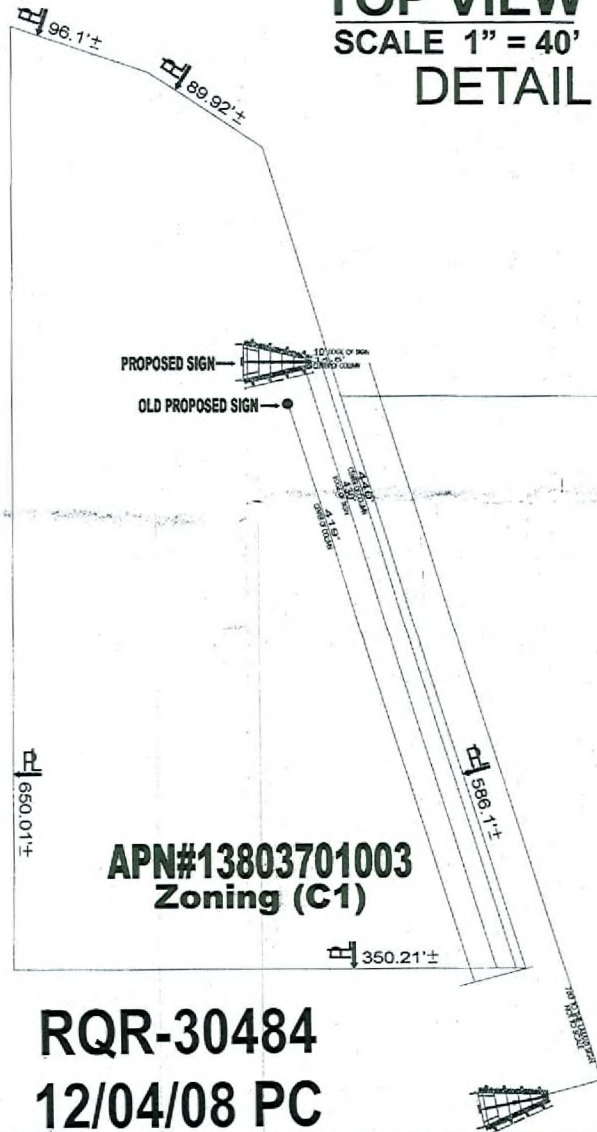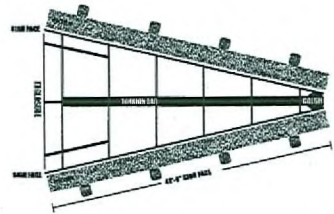

RECEIVED
OCT 21 2008
CITY OF LAS VEGAS
PLANNING & DEVELOPMENT

**RQR-30484
12/04/08 PC**

 


GENERAL NOTES

1. Not within 750 foot radius of another off-premise billboard.
2. Not within 300 foot radius of residential use.
3. No parking spaces will be taken for this location.

ORION JOB
OUTDOOR MEDIA
GLENDALIPPMAN
595-4896




L.351-05

| | | |
|--|-------------------------------|----------------------------|
| JONES | | |
| 4145 W. TECO AVE. / LAS VEGAS, NV 89118 / 702-645-0072 | | |
| OWNER: STIMAC RICHARD A | | |
| SCALE: NOTED | APPROVED BY: | DRAWN BY: TOM JONES |
| DATE: 5-25-04 | | REVISED: |
| LOCATION: 7075 W CRAIG RD | | |
| APN#13803701003 | DRAWING NUMBER: 355 | |

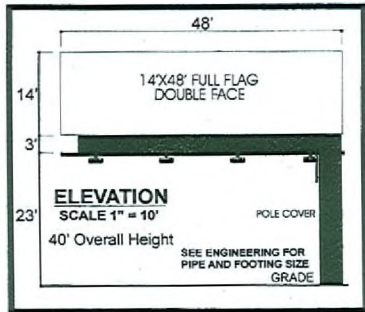

CRAIG ROAD

**TOP VIEW
SCALE 1" = 40'
DETAIL**

 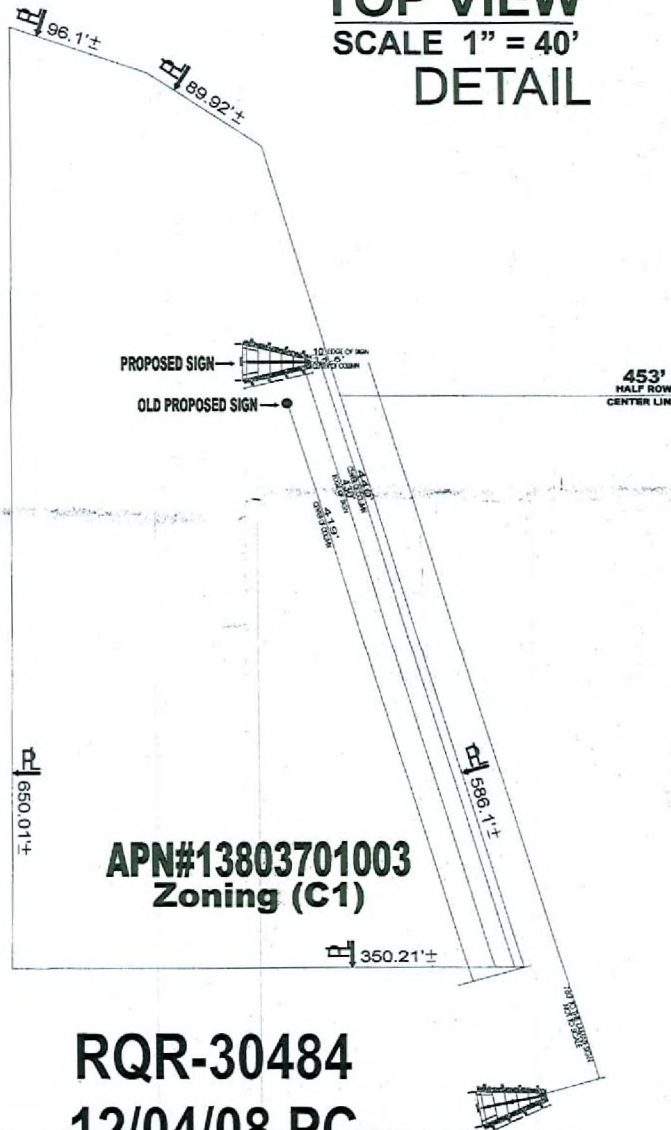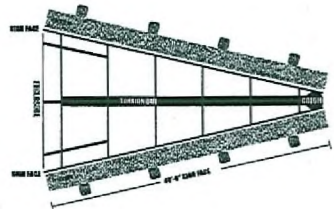

GENERAL NOTES

1. Not within 750 foot radius of another off-premise billboard.
2. Not within 300 foot radius of residential use.
3. No parking spaces will be taken for this location.

US 95

L.331-05

ORION JOB
OUTDOOR MEDIA
GLENDALIPPMAN
595-4896

RECEIVED
JUN 09 2005

JONES
H-E-D-I-A 4145 W. TECO AVE. / LAS VEGAS, NV 89118 / 702-645-0092

OWNER:
STIMAC RICHARD A

| | | |
|-------------------------------------|-------------------------------|---------------------|
| SCALE: NOTED | APPROVED BY: | DRAWN BY: TOM JONES |
| DATE: 5-25-04 | | REVISED: |
| LOCATION: 7075 W CRAIG RD | | |
| APN#13803701003 | DRAWING NUMBER: 355 | |

RECEIVED
OCT 21 2008
CITY OF LAS VEGAS
PLANNING & DEVELOPMENT

RQR-30484
12/04/08 PC