



PLANNING & DEVELOPMENT DEPARTMENT

STATEMENT OF FINANCIAL INTEREST

Case Number: **SUP-30324** APN: 138-09-401-014

Name of Property Owner: Nevada Power Company

Name of Applicant: Nevada Power Company

Name of Representative: Michelle Baltz

To the best of your knowledge, does the Mayor or any member of the City Council or Planning Commission have any financial interest in this or any other property with the property owner, applicant, the property owner or applicant's general or limited partners, or an officer of their corporation or limited liability company?

☐ Yes

☒ No

If yes, please indicate the member of the City Council or Planning Commission who is involved and list the name(s) of the person or persons with whom the City Official holds an interest. Also list the Assessor's Parcel Number if the property in which the interest is held is different from the case parcel.

City Official: _____

Partner(s): _____

APN: _____

Signature of Property Owner: *James Saavedra*

Print Name: James Saavedra

Subscribed and sworn before me

This 22nd day of September, 2008

Michelle Baltz
Notary Public in and for said County and State




[illegible]

RECEIVED
SEP 24 2008

[illegible]

SUP-30324
10/23/08 PC

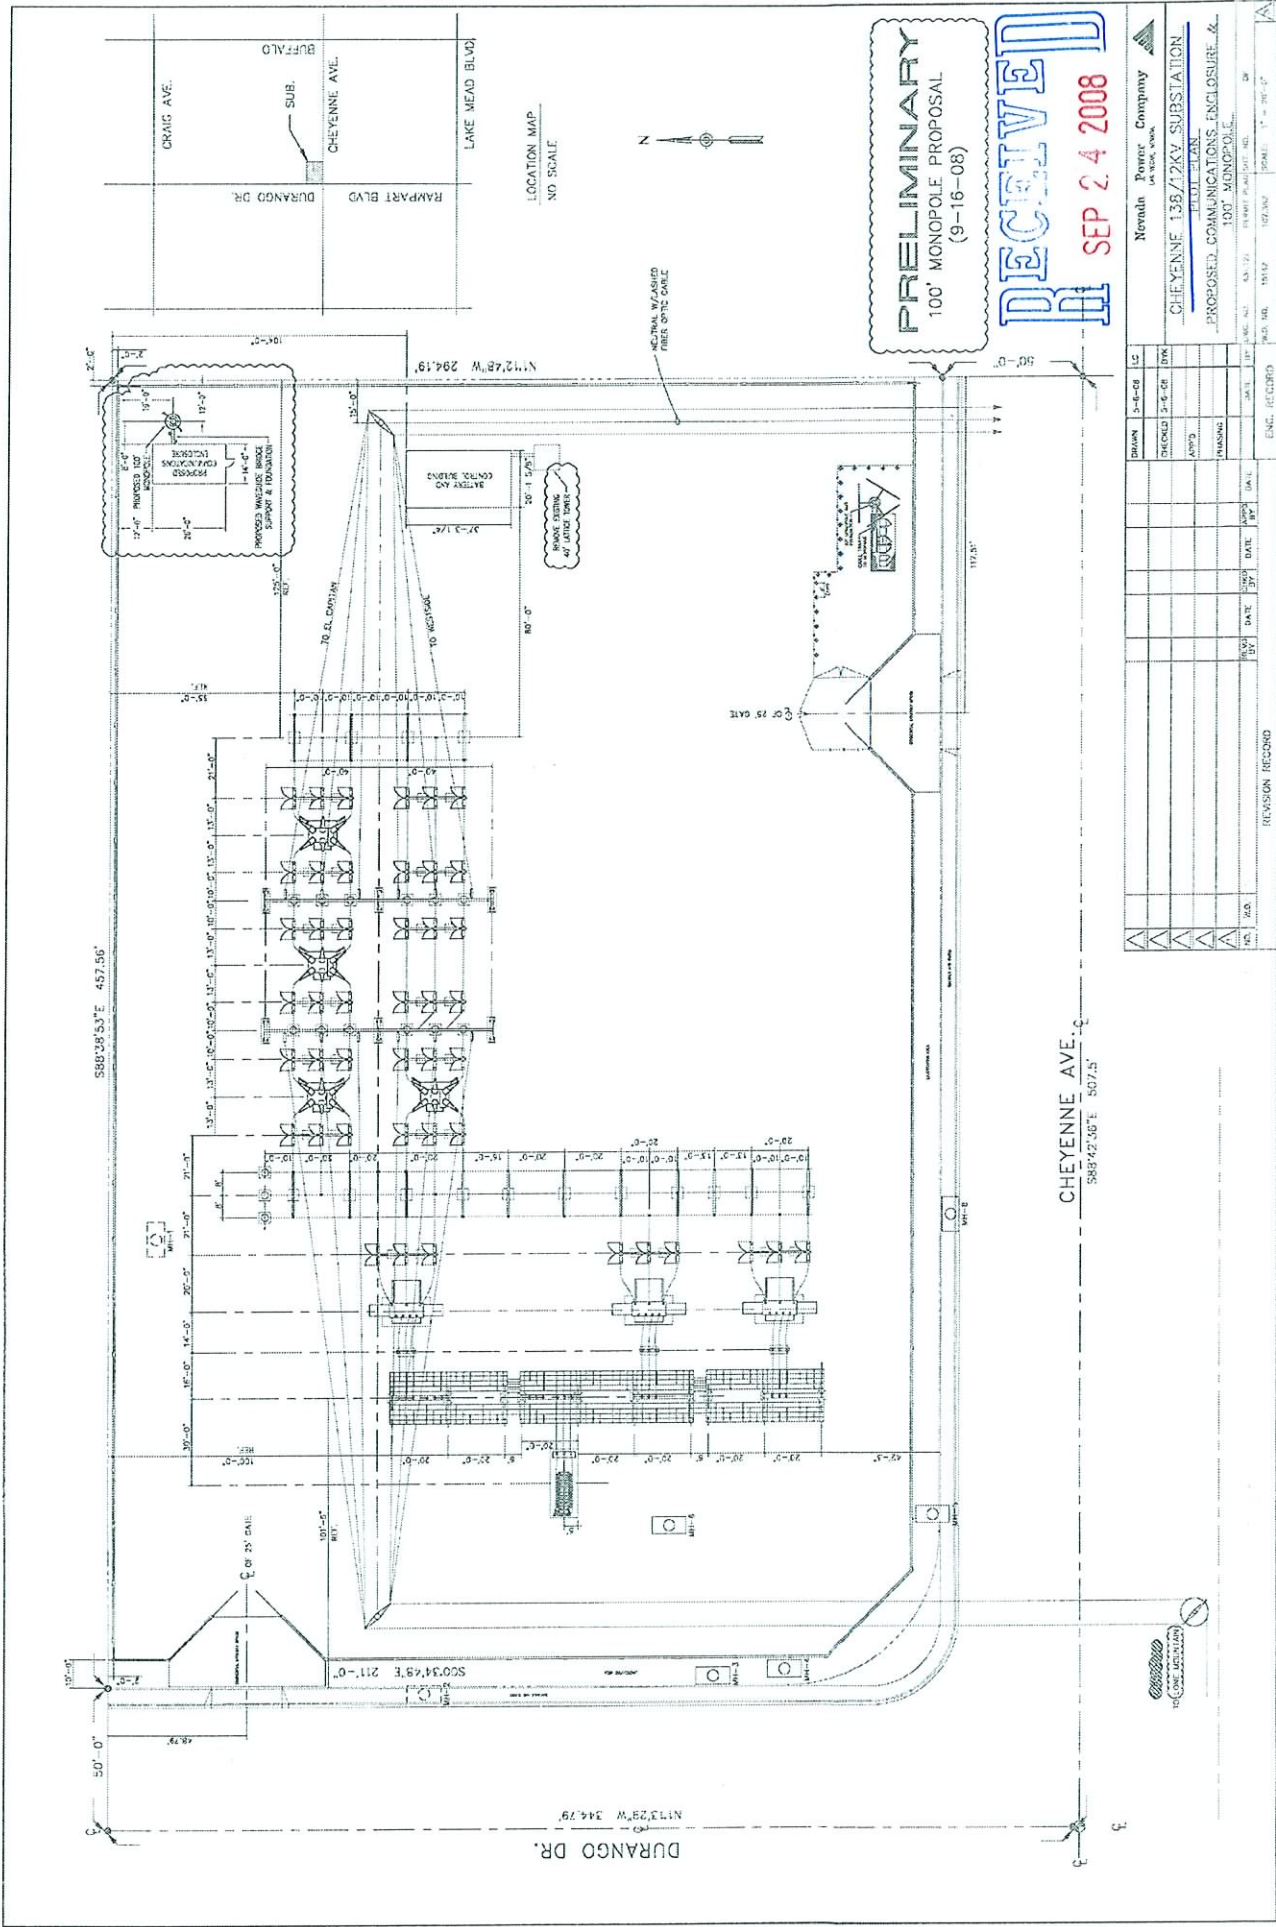

SUP-30324
10/23/08 PC