



PLANNING & DEVELOPMENT DEPARTMENT

STATEMENT OF FINANCIAL INTEREST

Case Number: **RQR-29722** APN: 139 33 510 002

Name of Property Owner: CONSTANTINO NOVAL, NEVADA LLC

Name of Applicant: CLEAR CHANNEL OUTDOOR

Name of Representative: ROD CARTER

To the best of your knowledge, does the Mayor or any member of the City Council or Planning Commission have any financial interest in this or any other property with the property owner, applicant, the property owner or applicant's general or limited partners, or an officer of their corporation or limited liability company?

_____ Yes No

If yes, please indicate the member of the City Council or Planning Commission who is involved and list the name(s) of the person or persons with whom the City Official holds an interest. Also list the Assessor's Parcel Number if the property in which the interest is held is different from the case parcel.

City Official: _____

Partner(s): _____

APN: _____

Signature of Property Owner: [Handwritten Signature]




Print Name: ROD ROBERTSON FOR CONSTANTINO NOVAL NV, LLC

Subscribed and sworn before me

This 9th day of September, 2008

Aimee Jo Knox
Notary Public in and for said County and State



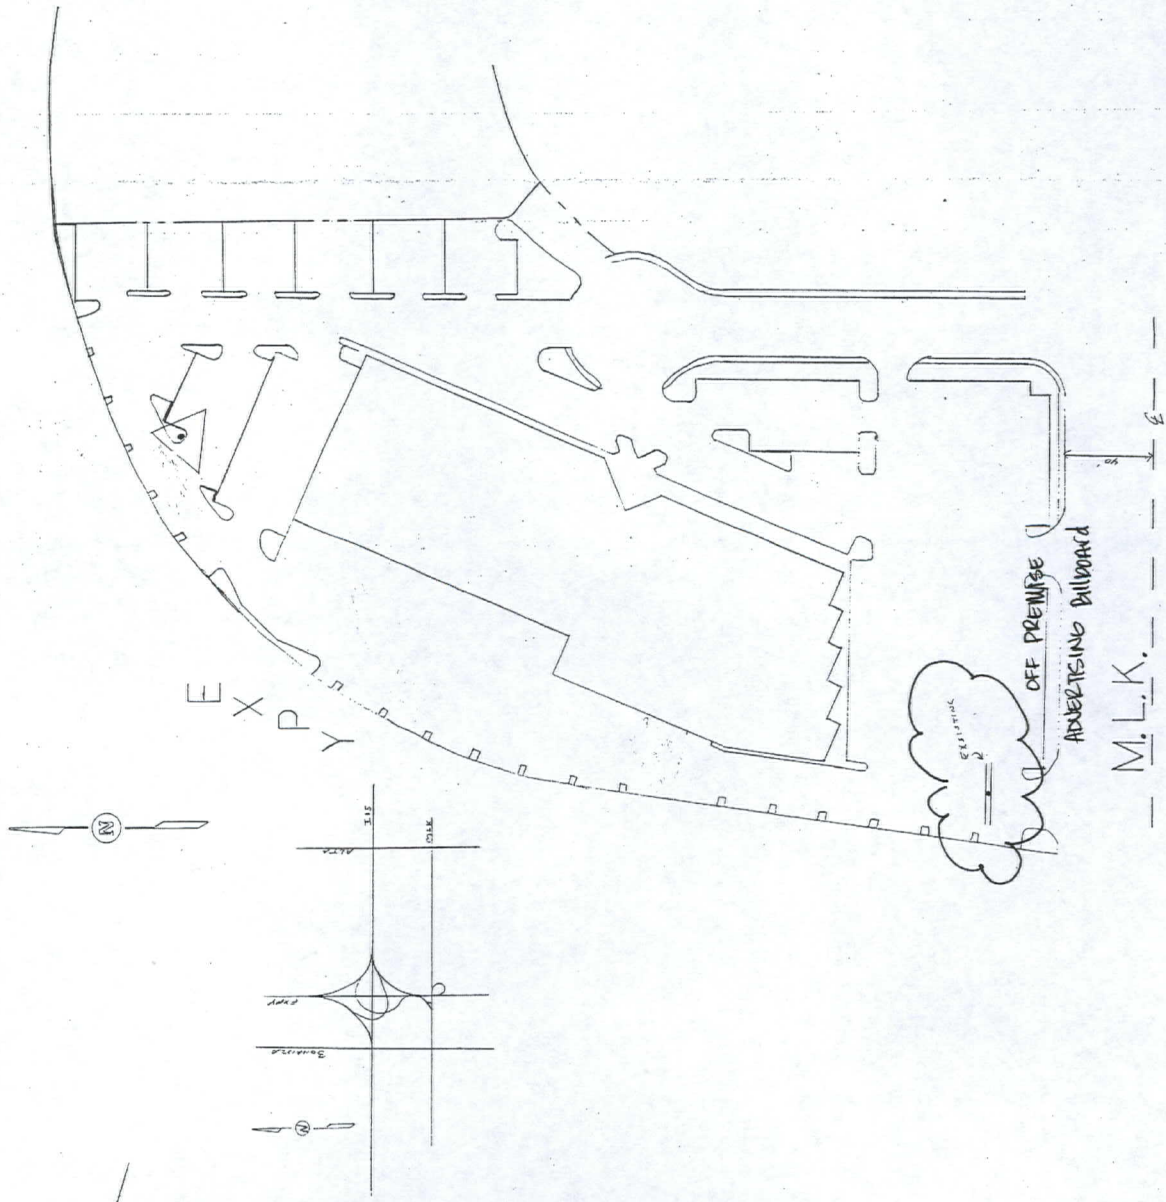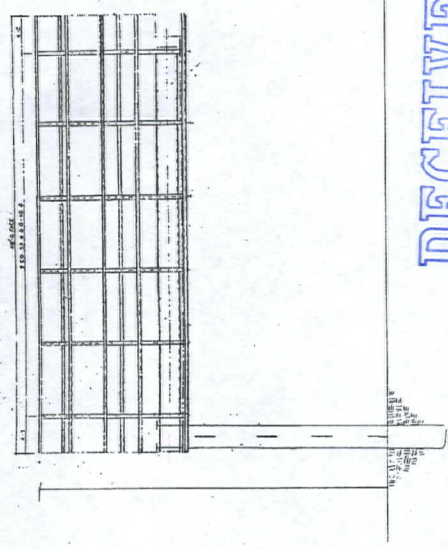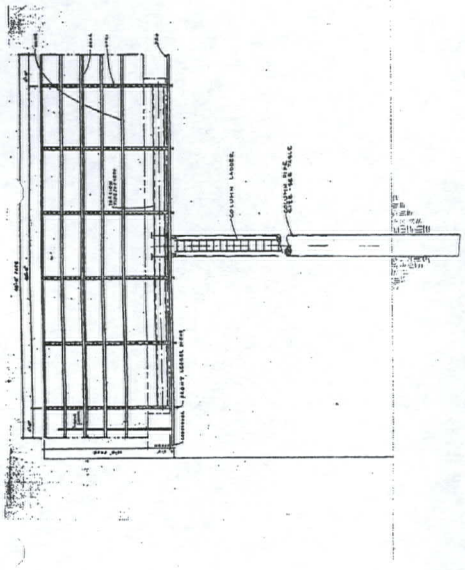

RECEIVED
SEP 17 2008

CONSTANTINO NOVAL



SCALE 1/8" = 5'-0"
DATE 2-9-91
DRAWN BY S. J. BROWN / M.L.K. - R.F.M. INC.
1211 West Bonanza Road
Phone 384-5020

RQR-29722
10/23/08 PC