


RECEIVED

NOV 21 2008

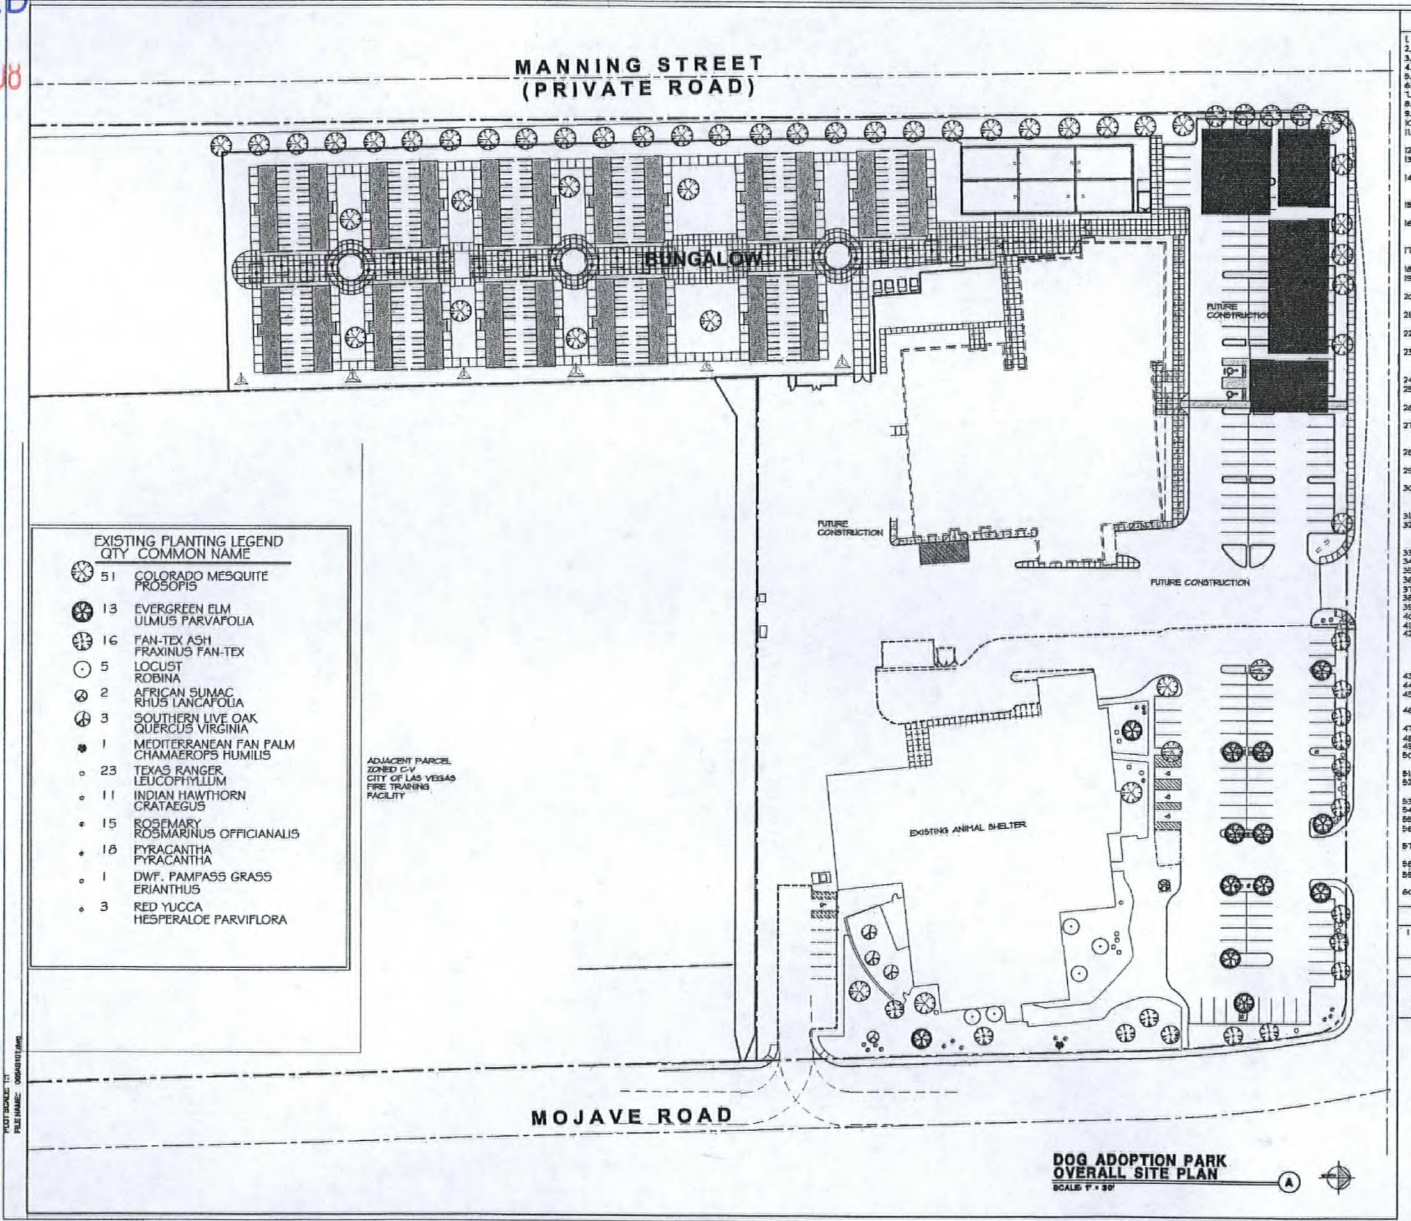

- EXISTING PLANTING LEGEND**
QTY COMMON NAME
- 51 COLORADO MESQUITE
PROSOPIS
 - 13 EVERGREEN ELM
ULMUS PARVIFOLIA
 - 16 FAN-TEX ASH
FRAXINUS FAN-TEX
 - 5 LOCUST
ROBINA
 - 2 AFRICAN SUMAC
RHIUS LANCIFOLIA
 - 3 SOUTHERN LIVE OAK
QUERCUS VIRGINIA
 - 1 MEDITERRANEAN FAN PALM
CHAMAEROPS HUMILIS
 - 23 TEXAS RANGER
LEUCOPYLLUM
 - 11 INDIAN HAWTHORN
CRATAEGUS
 - 15 ROSEMARY
ROSMARINUS OFFICINALIS
 - 16 PYRACANTHA
PYRACANTHA
 - 1 DWF. PAMPASS GRASS
ERIANTHUS
 - 3 RED YUCCA
HESPERALOE PARVIFLORA

ADJACENT PARCEL
ZONED C.V.
CITY OF LAS VEGAS
FIRE TRAINING
FACILITY

DOG ADOPTION PARK
OVERALL SITE PLAN



LANDSCAPE SITE PLAN
LIED ANIMAL SHELTER
655 N. MOJAVE RD
LAS VEGAS, NV 89101

NO.	DATE	REVISION

DESIGNED BY:	MJO
DRAWN BY:	
CHECKED BY:	
DATE:	11/19/08
SCALE:	1" = 40'-0"
TITLE:	LANDSCAPE

SHEET NUMBER
L I O

SDR-31744
REVISED
12/18/08 PC

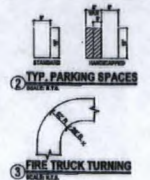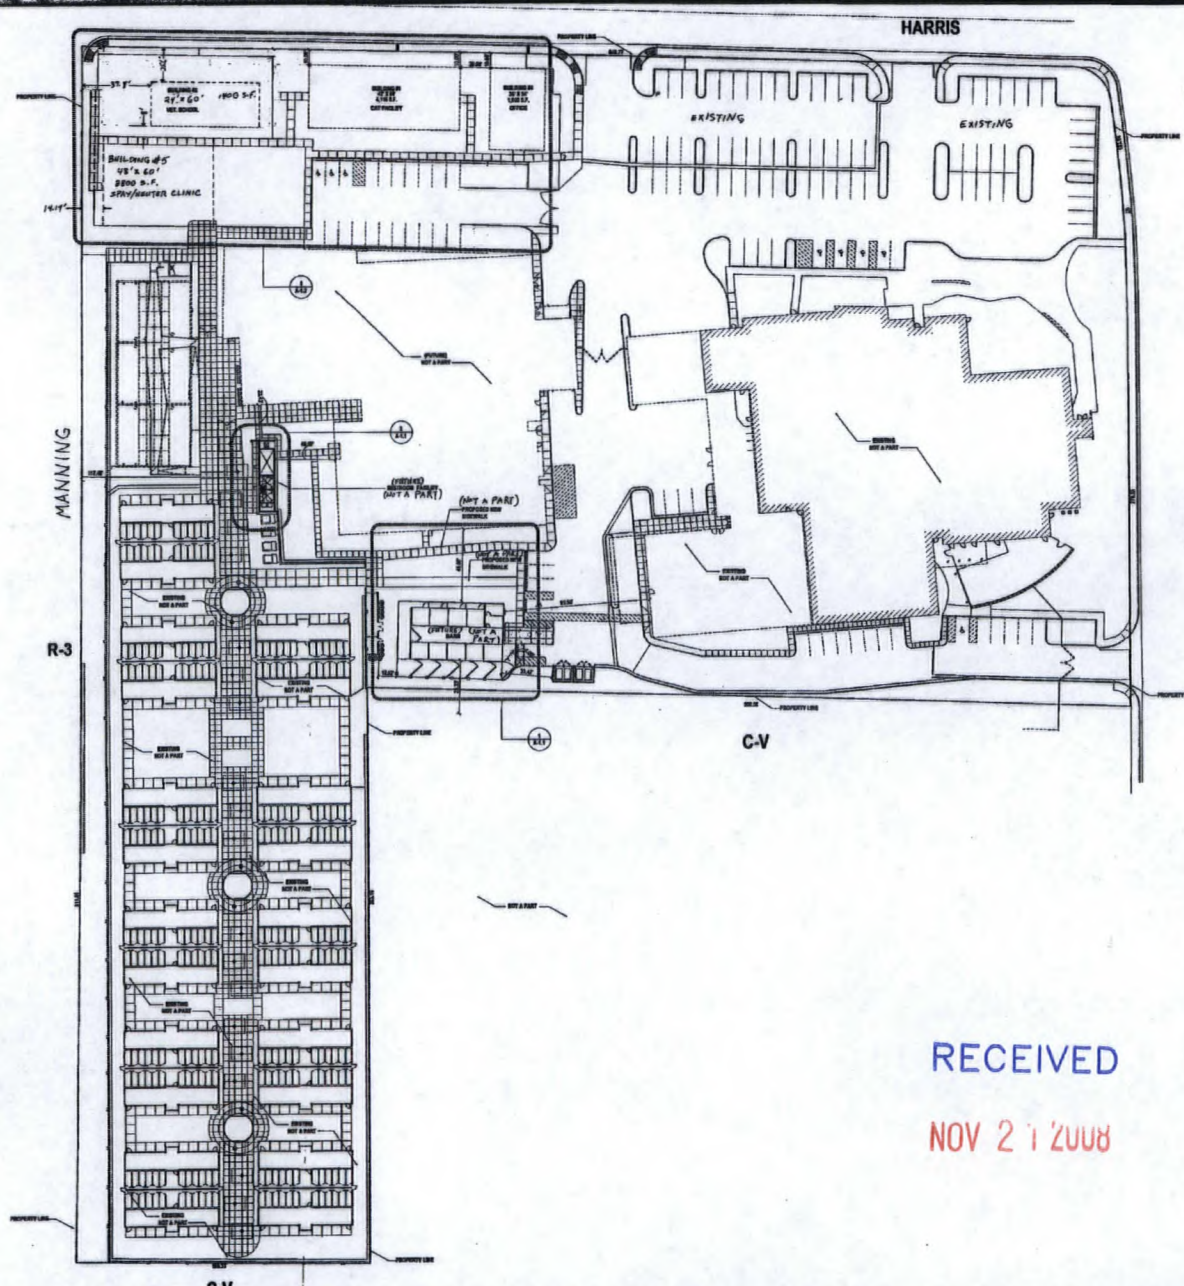

TYPICAL SITE DETAILS
SCALE: N.T.S.

SITE INFORMATION

APN NUMBER: 120-054-02-010
 ZONING: CVC DISTRICT (C-10)
 LOT SIZE: 8.50 ACRES



RECEIVED
NOV 21 2008



SDR-31744
 REVISED
 12/18/08 PC

FRONTLINE GROUP
 ARCHITECTURE
 ENGINEERING
 PLANNING

MOSEB architecture studio

Lead Architect
 Shantae Carr

Site Plan

RECEIVED