


Log Cabin Ranch Estates

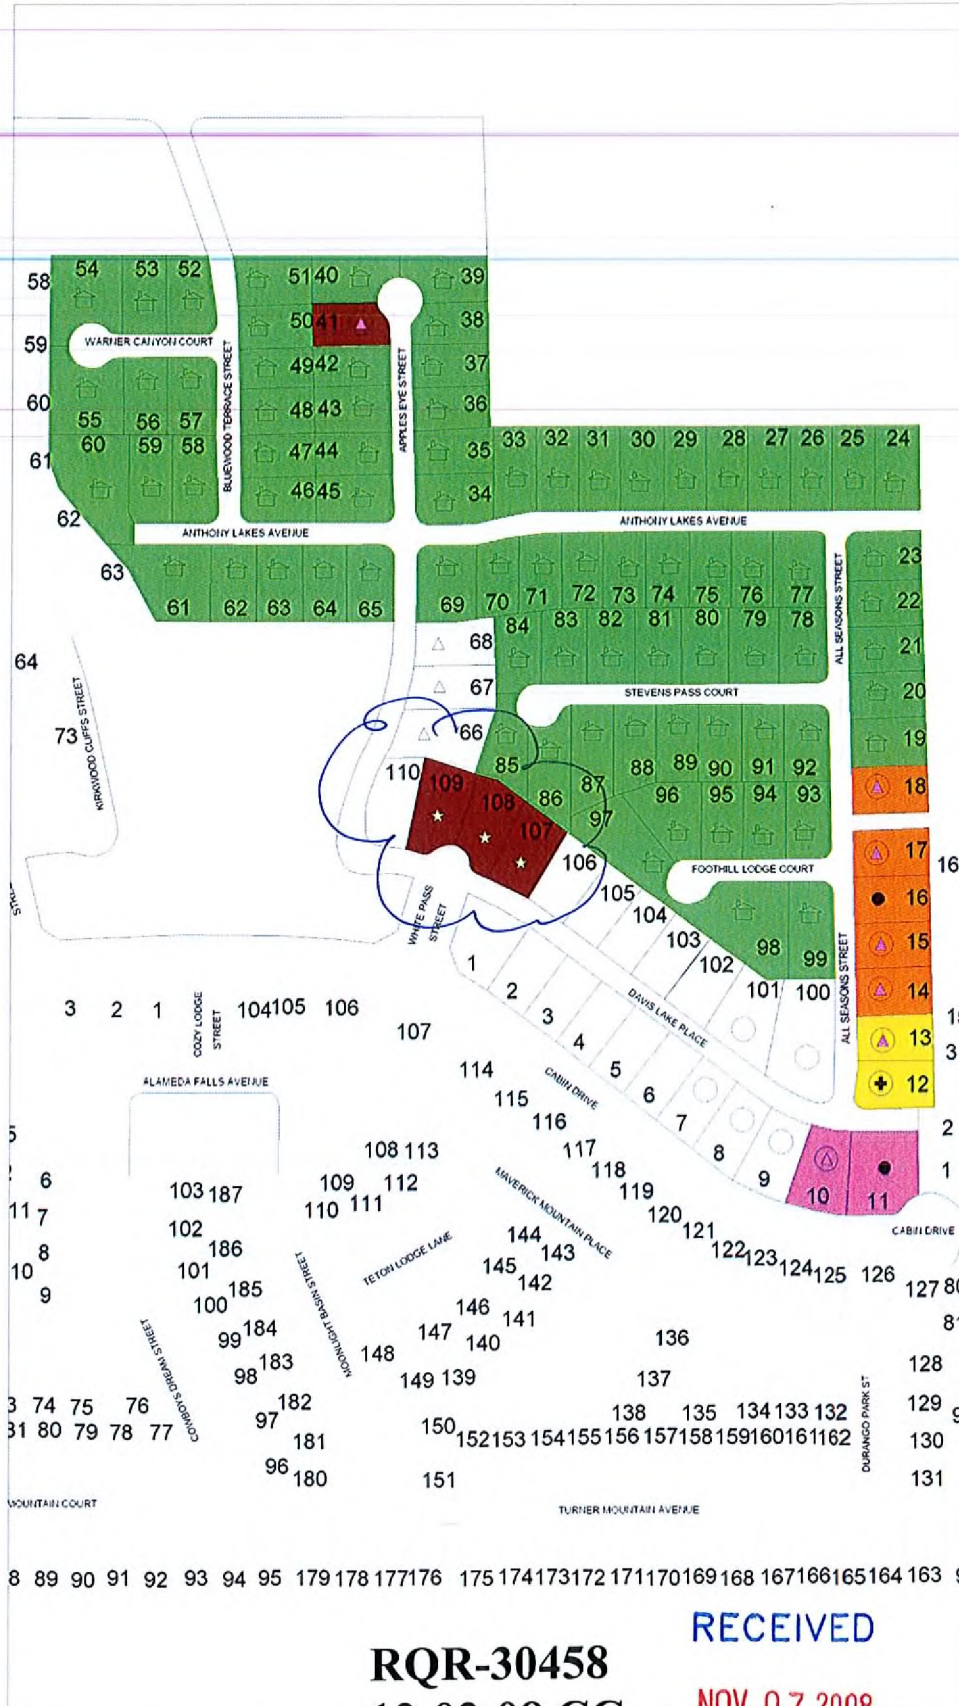

110 Total Homes

Features

As of 11/5/2008

- Construction Trailer
- Soil Pile or Borrow Pit

Sales Status

- Model (3)
- Pre-Spec (3)
- Spec (7)
- Spec Cmpltd-90 (0)
- Contingent Sale (1)
- Sold (not closed) (2)
- Closed (77)
- Remaining (17)
- Released for Sale (13)
- Not Purchsd/Dev (0)
- Permit (no const) (0)
- Permit at City (0)

Construction Status

- Layout & Trench (2)
- Foundation (2)
- Framing (5)
- Drywall (0)
- Second Trim (4)
- Completed (77)

RECEIVED

RQR-30458

12-03-08 CC

NOV 07 2008

