PLANNING & DEVELOPMENT

PLANNING & DEVELOPMENT DEPARTMENT

STATEMENT OF FINANCIAL INTEREST

Case Number: RQR-29727 APN: 139-34-410-165

Name of Property Owner: Gateway Motel Inc

Name of Applicant: Reagan National Advertising of Nevada

Name of Representative: Dewey Reagan

To the best of your knowledge, does the Mayor or any member of the City Council or Planning Commission have any financial interest in this or any other property with the property owner, applicant, the property owner or applicant's general or limited partners, or an officer of their corporation or limited liability company?

_____ Yes X No

If yes, please indicate the member of the City Council or Planning Commission who is involved and list the name(s) of the person or persons with whom the City Official holds an interest. Also list the Assessor's Parcel Number if the property in which the interest is held is different from the case parcel.

City Official: _____

Partner(s): _____

APN: _____

Signature of Property Owner: Dewey Reagan

Print Name: Dewey A. Reagan

Subscribed and sworn before me

This 15 day of September, 2006

Cheryl Jenson

Notary Public in and for said County and State

Revised 11-14-06

CHERYL A. JENSON
NOTARY PUBLIC - STATE OF UTAH
1002 E. MILL ST.
BOUNTIFUL, UT 84010
My Comm. Exp. 12/05/2011

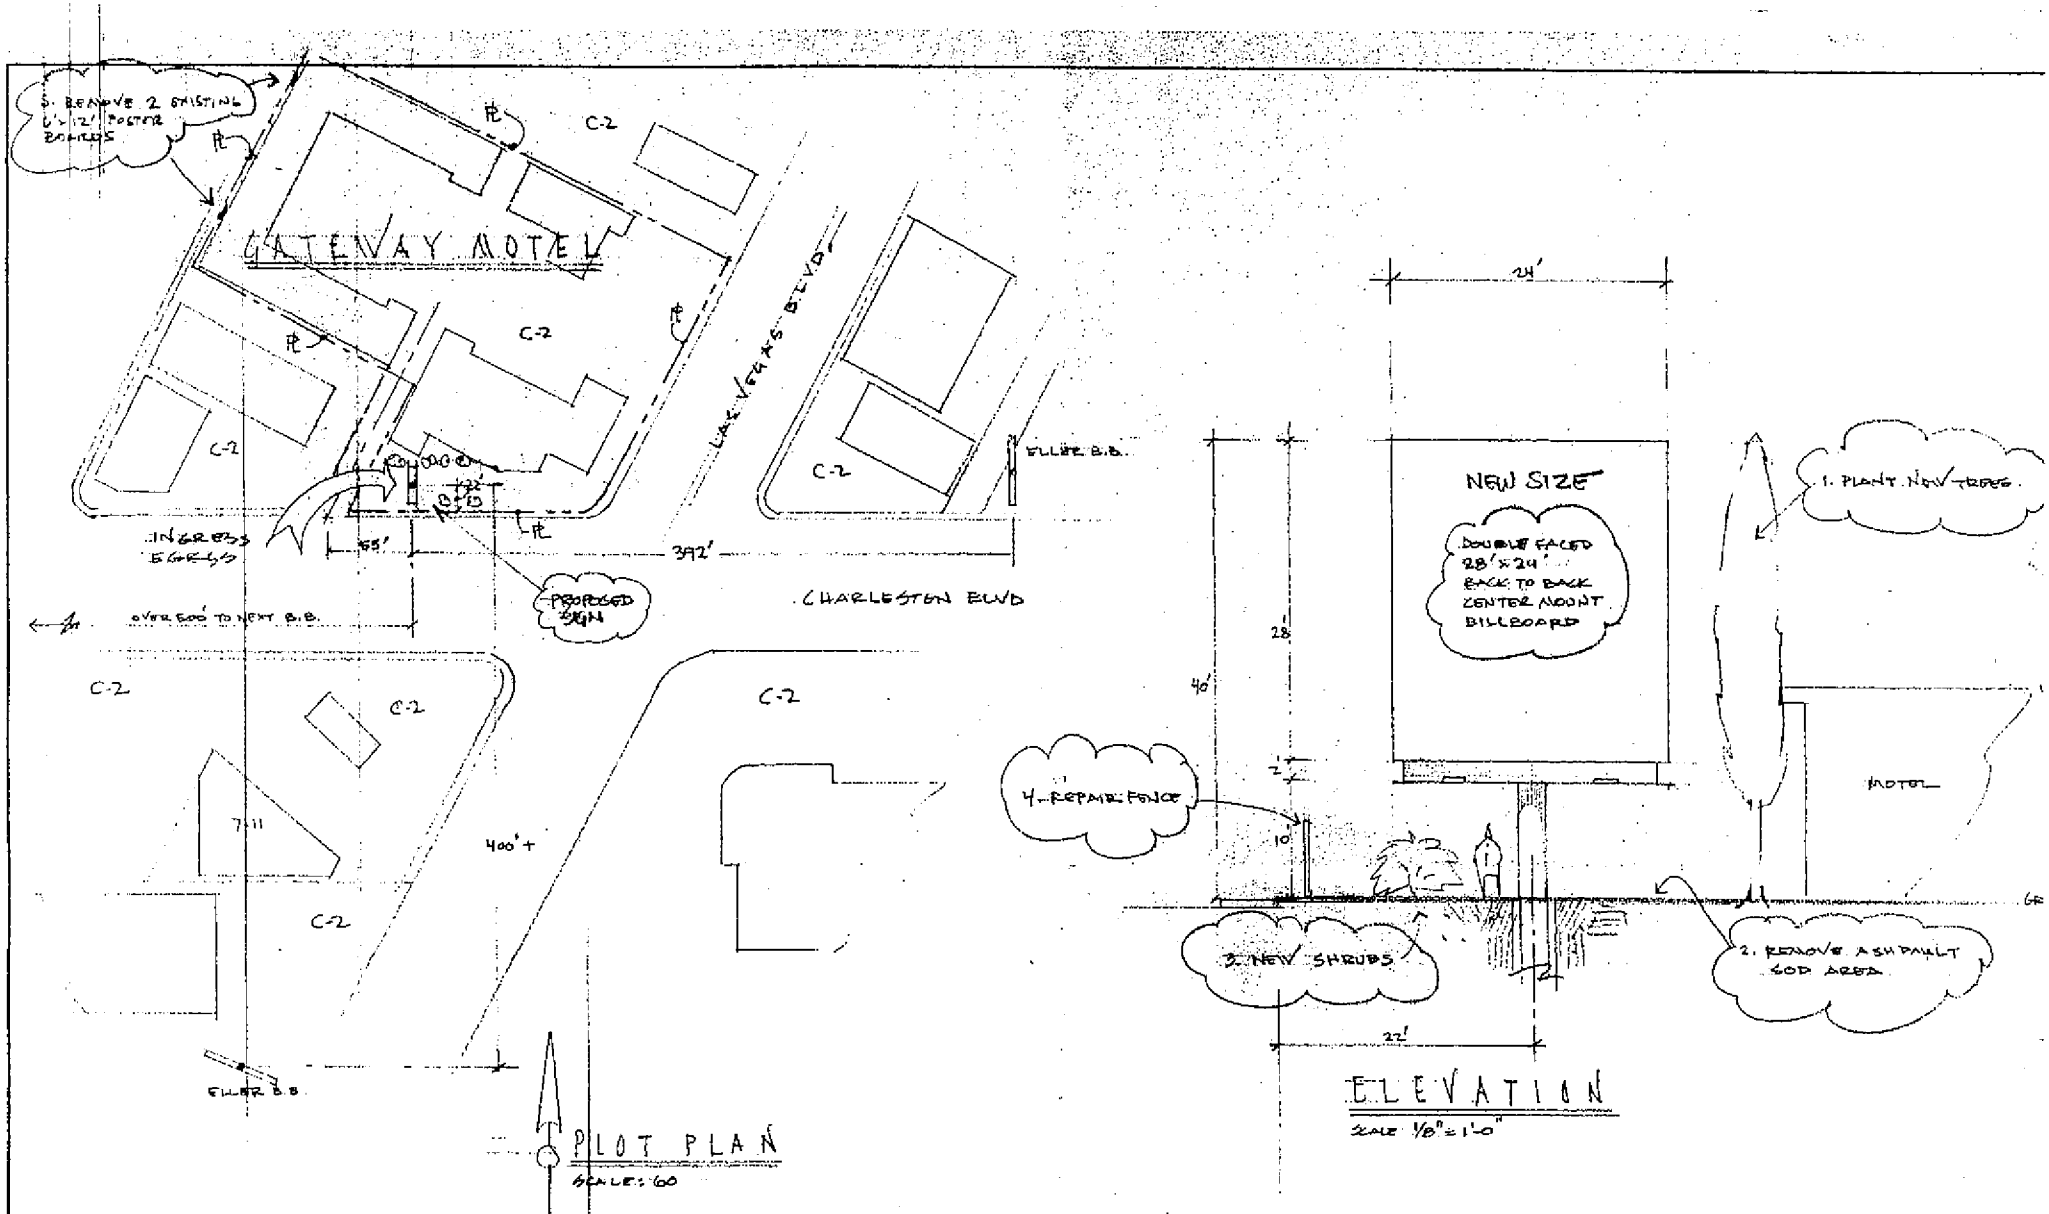

RQR-29727
10/23/08 PC

REAGAN NATIONAL ADVERTISI
7181 S. INDUSTRIAL LV NV 89118 · 702-361-

OWNER:
GATEWAY MOTEL
928 LVBS. LV. NV 89109

SCALE: NOTED | APPROVED BY: | DRAWN BY: LC