

2


UTILITY STATEMENT

1. THE UNDERGROUND UTILITIES SHOWN HAVE BEEN LOCATED FROM FIELD SURVEY INFORMATION. THE SURVEYOR MAKES NO GUARANTEE THAT THE UNDERGROUND UTILITIES SHOWN COMPRISE OF ALL SUCH UTILITIES IN THE AREA, EITHER IN SERVICE OR ABANDONED.

SUTTER HILL SUBDIVISION

LOT 8
ASSESSORS PARCEL No. 139-31-110-003

PROPOSED
SITE

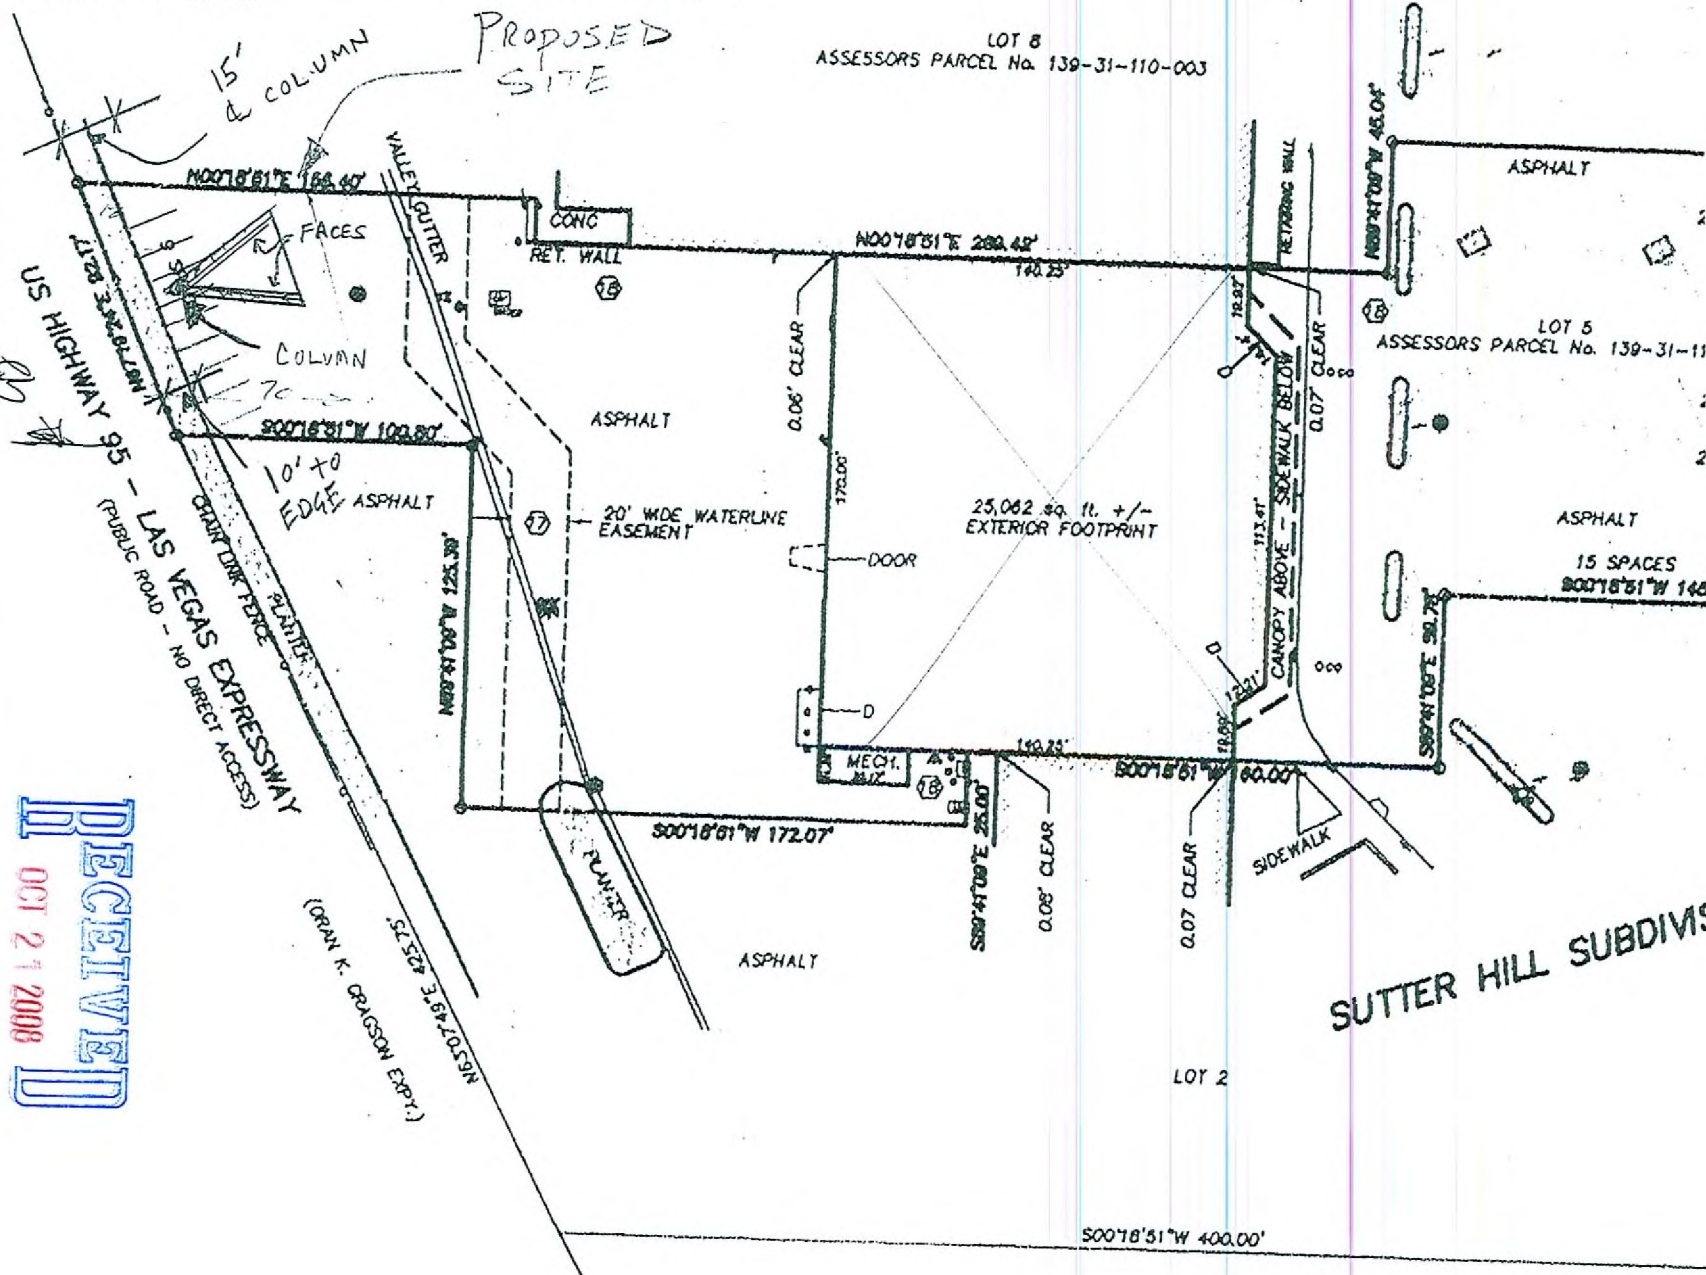

RECEIVED
OCT 27 2008

RQR-31290
12-03-08 CC

SUTTER HILL SUBDIVISION